

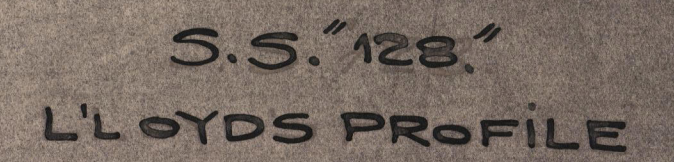


TO CLASS LLOYD'S 100 A I. SINGLE DECK STEEL

SCALE:  $\frac{1}{8}'' = 1 \text{ FOOT.}$

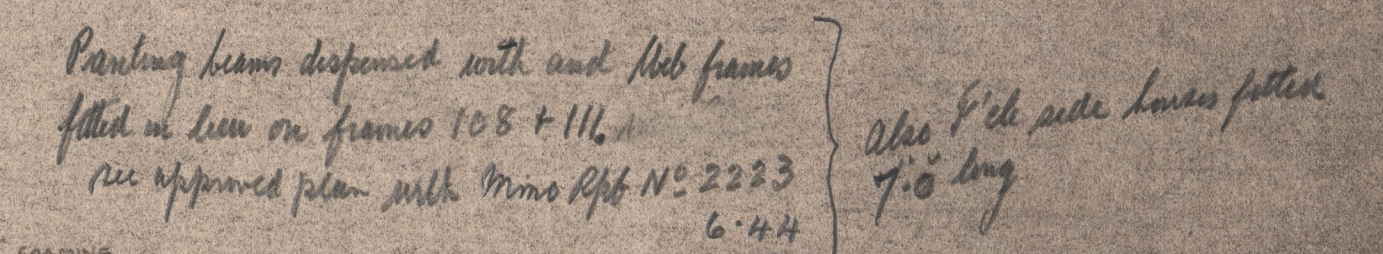

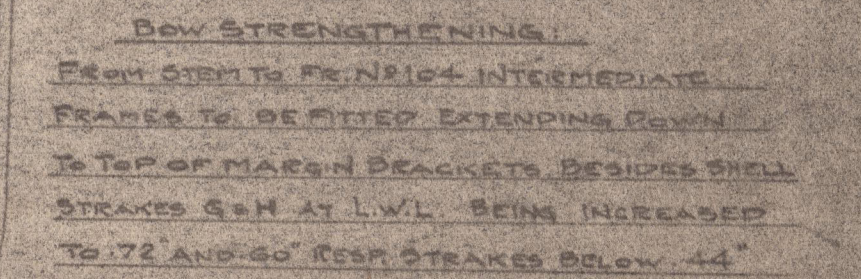

S.S. "Grim", Lockums Yard No. 128.  
Kalmes 54.

Profile and Decks,  
(Vessel as built.)



© 2020

Lloyd's Register  
Foundation

002701-002710-0060