


5/11 KINGSTON TURQUOISE

FRAMING &c IN NEW CRUISER STERN.

12.9.36

SCALE 1/4" = 1'-0"

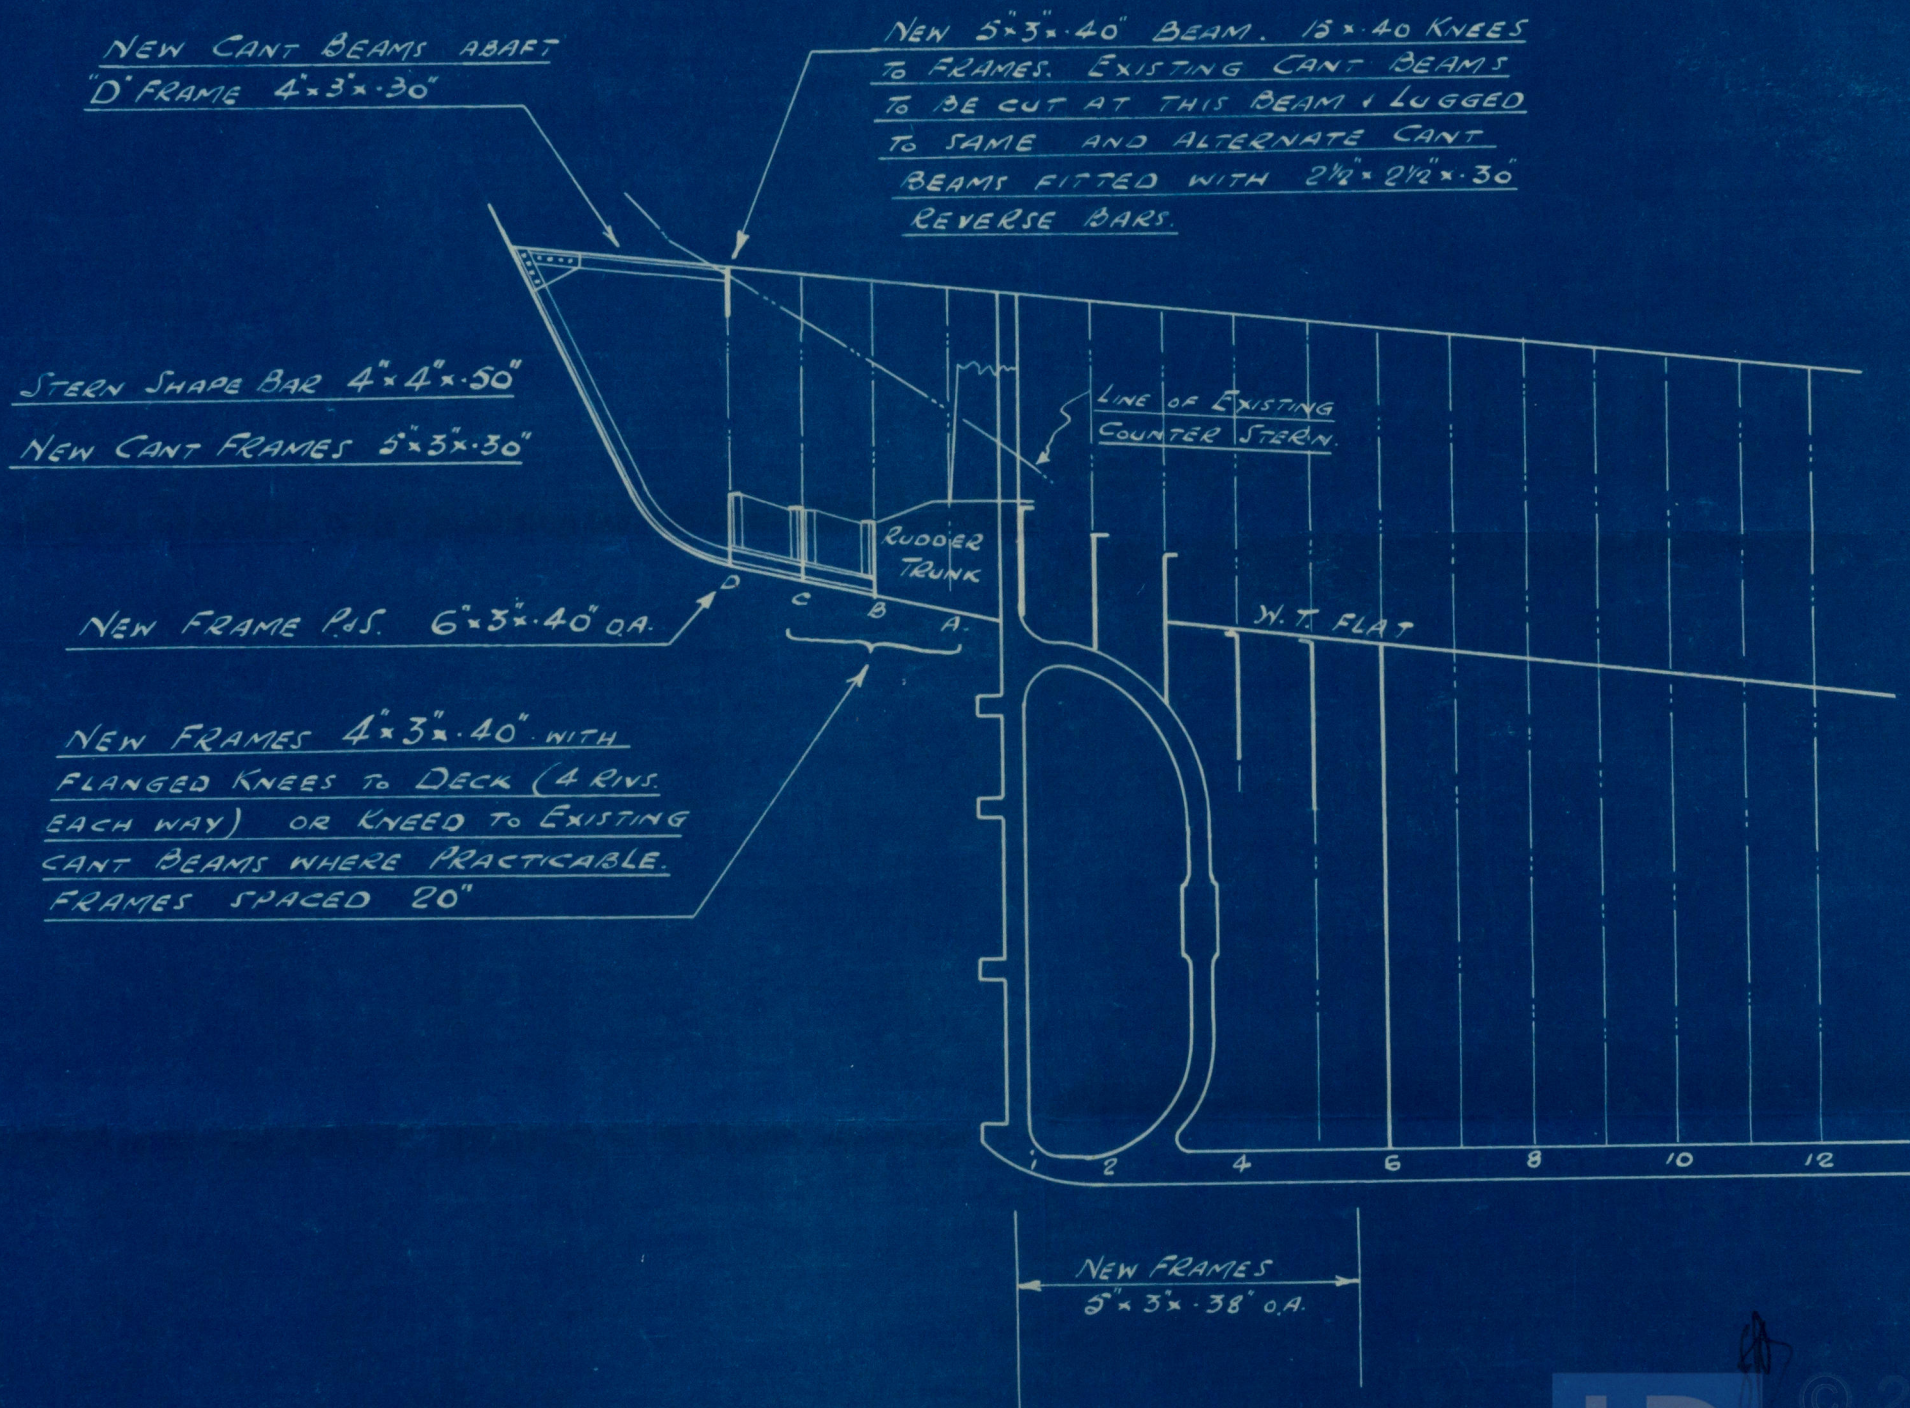

© 2020

Lloyd's Register

Foundation

002701-002710-0107

Steam Trawler
KINGSTON TORQUOISE.
Working etc in Cruiser
Stern

S.S.
MDB. RPT. No. 15845

© 2020

Lloyd's Register
Foundation

002701-002710-0107