

5/4 KINGSTON TURQUOISE

NEW FORE END FRAMING

ALL NEW FRAMES TO BE JOGGLED

FRAME SPACING FROM N^o 1 TO 69 = 20"


" " " N^o 69 TO 79 = 16"

" " " N^o 79 TO 86 = 20"

" " " N^o 86 TO STEM = 18"

CREW SPACE FLAT:

	GIRTH BETWEEN FLAT & MAIN DK	HEIGHT FROM FLAT TO DK AT SIDE
FR 69	8'-8"	8'-6"
FR 86	9'-10 1/4"	9'-6 1/8"

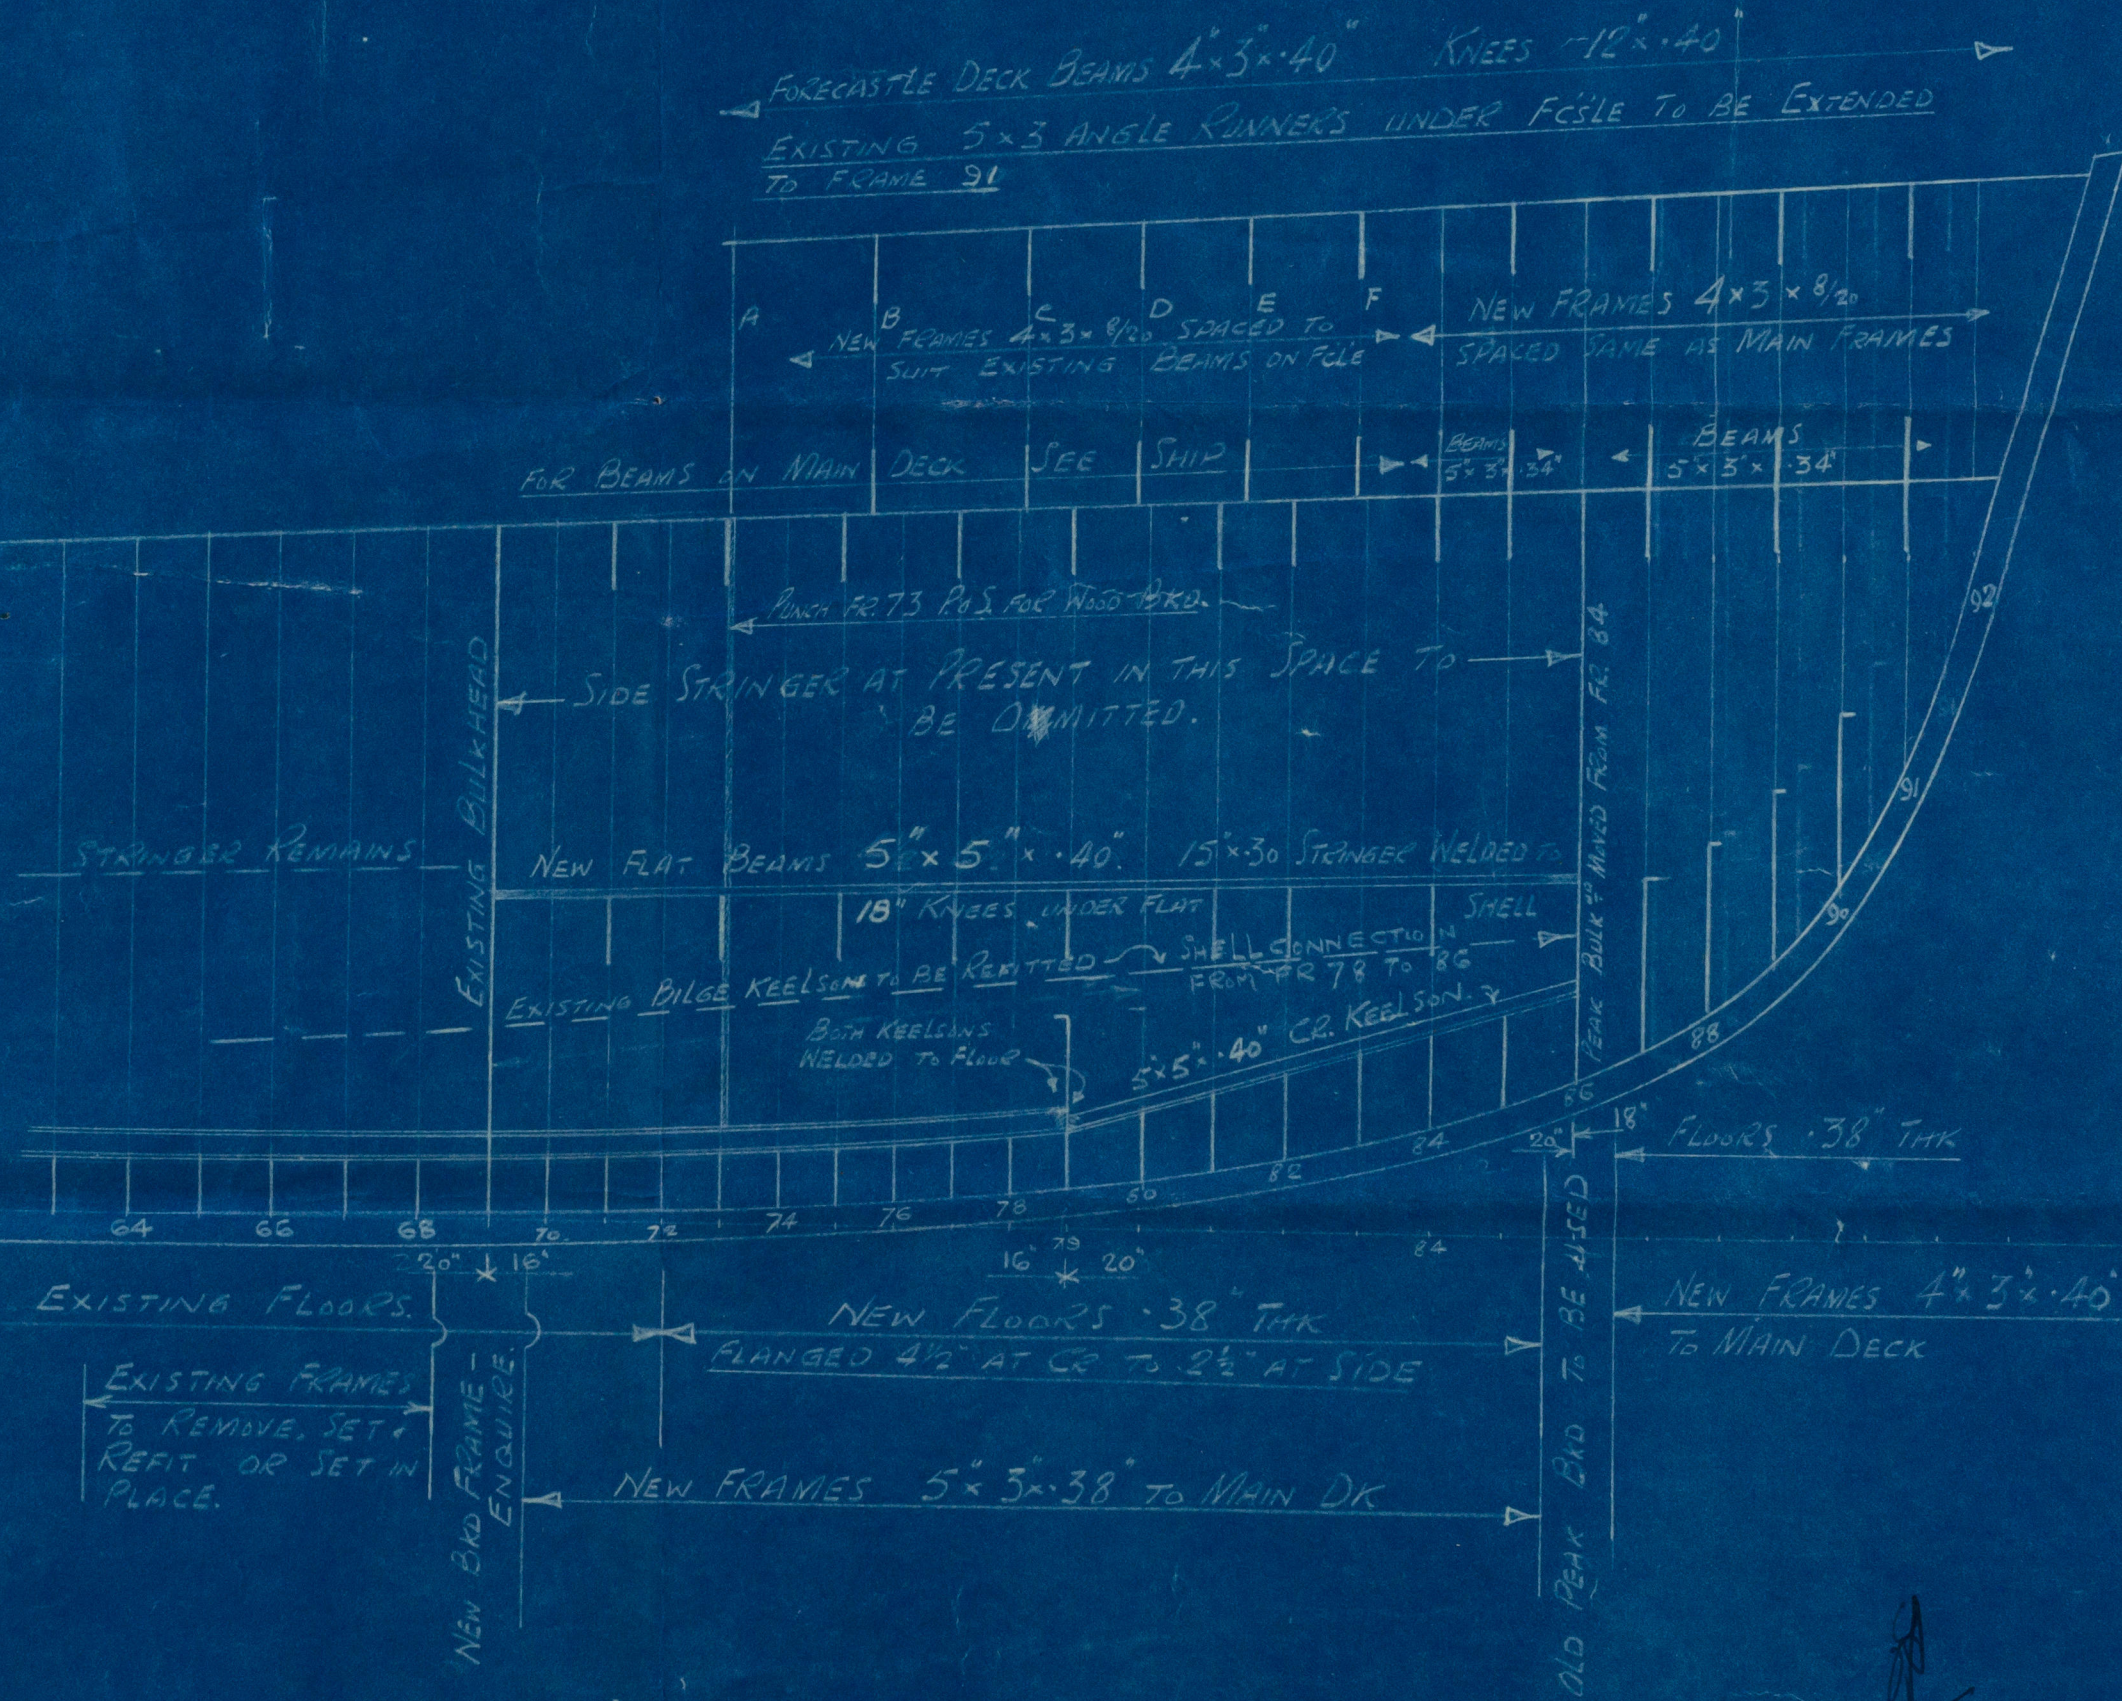

NOTE: ALL FRAMES CUT & BRACKETED AT MAIN DECK



© 2020

Steam Hawk

"KINGSTON TORQUOISE"

NEW FORE END FRAMING.

S.S.

MDB. RPT. No. 15-845



© 2020

Lloyd's Register
Foundation

002701-002710-0108