


COASTING VESSEL
DESIGNED FOR ARCTIC SERVICE
HUDSON BAY COMPANY

John Etherington Limited,
Shelburne, N.S.
Builders

149' 0" x 30' x 13'
 (See hull space sheet)

15 MAY 1948
 APPROVED
 27-5-48
 (Signature)

 

Length outside stem to outside stern 149'-0"
 Main Breadth 30'-0" Depth 13'-0" Top of Floor
 Scale: $\frac{3}{8}$ in = 1 ft.

APPROVED
 23/4/48
 MONTREAL
 LLOYD'S REGISTER
 FOUNDATION

5

Amnd. Profile

John Etherington, Ltd.

No. 2.

22.5.48.

" T.C. 2. 6. 48. "


Fort Heame ★

RECORDS DEPT.,
LONDON

2

15 MAY 1948


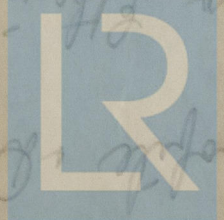

Lloyd's Register
Foundation

002701-002710-0186