
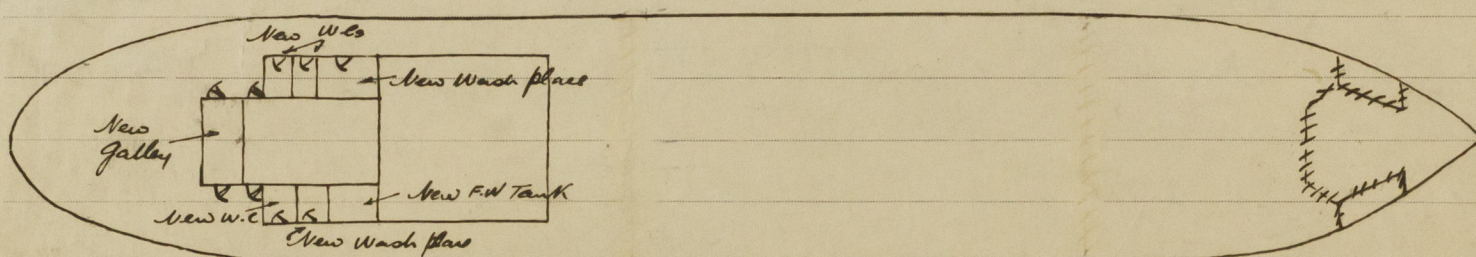



B.T. COPY

Official No.

DIAGRAMS SHEWING ALTERATIONS TO SUPERSTRUCTURE, BULWARKS & DECKHOUSES

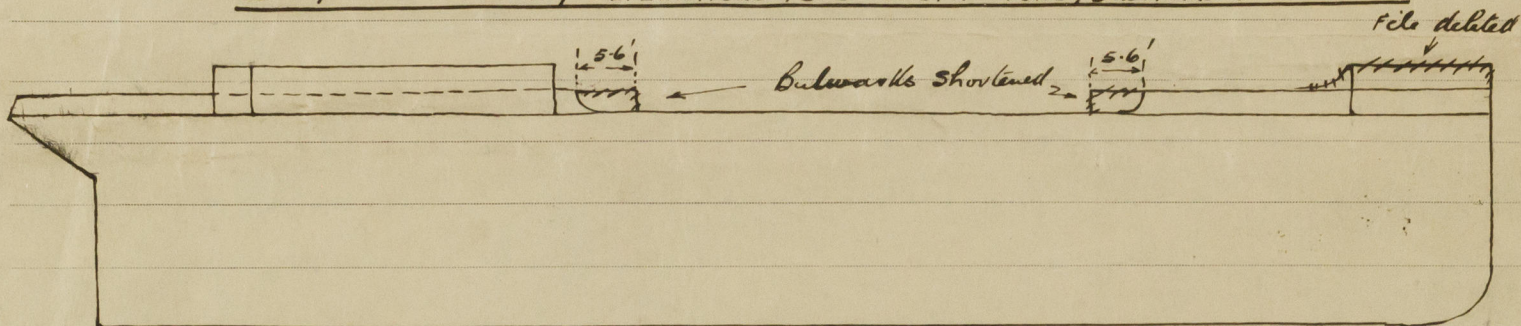

DIAGRAMS SHOWING ALTERATIONS TO HATCHWAYS, VENTILATORS, COMPANIONWAYS ETC.

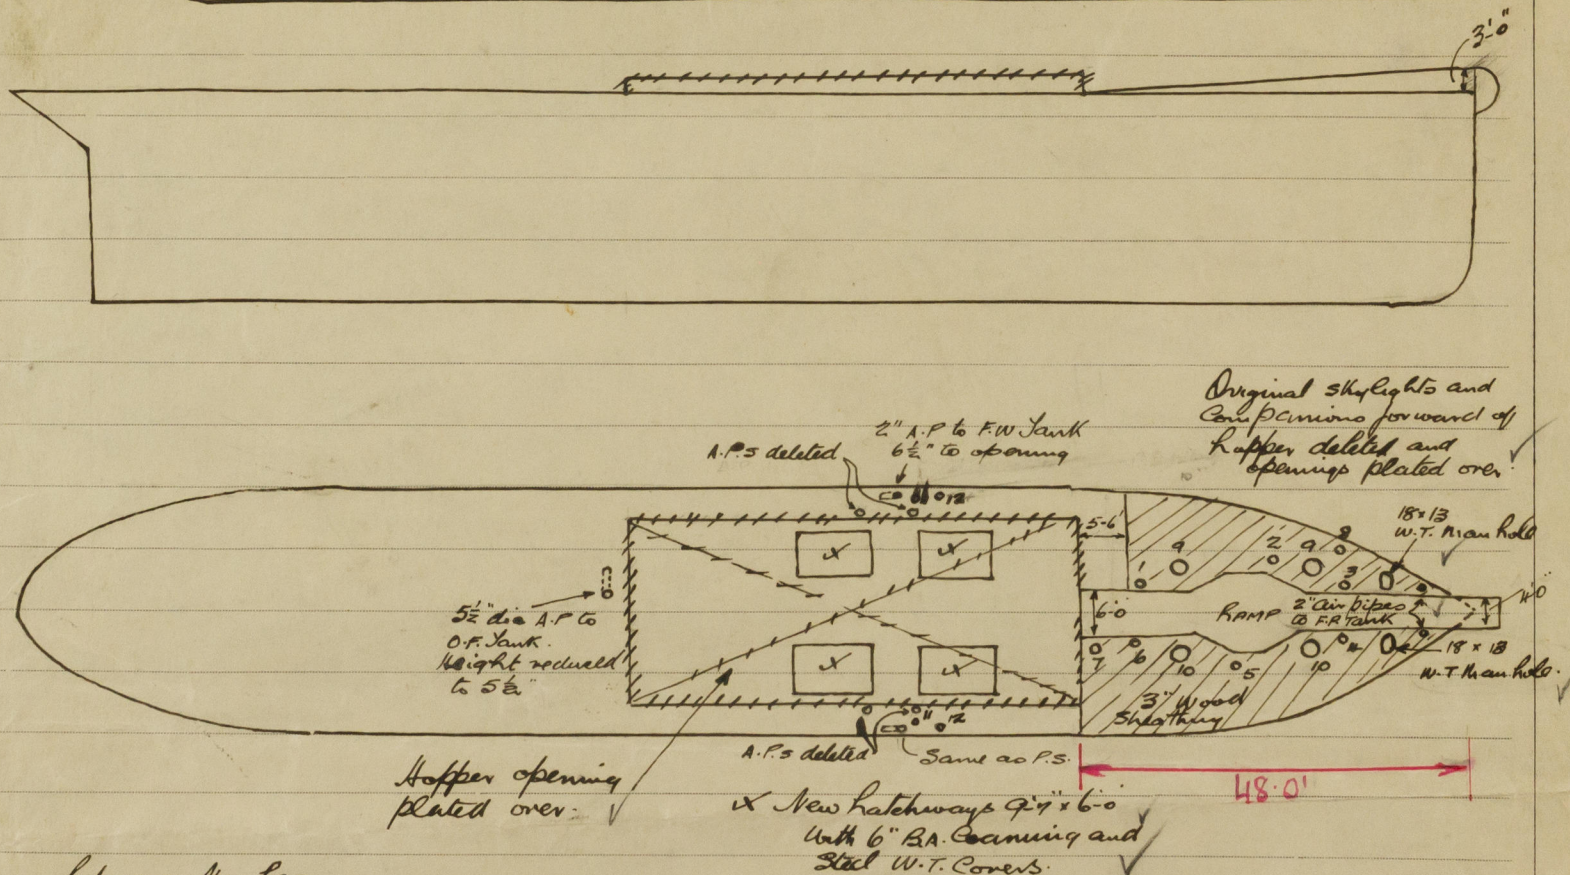

Reference Numbers
on diagram ↓

- | | | | | | |
|-----------|-----|----------------------------------|-----|---------|---------------------------|
| 1--6 | dia | Mushroom Vent | 9" | Coaming | |
| 2--12 | " | " | 12" | " | bolted to deck |
| 3--10 | " | chain pipe | | | |
| 4--10 | " | " | | | |
| 5--9 | " | Mushroom Vent | 12" | Coaming | bolted to deck |
| 6--6 | " | " | 9" | " | |
| ✓ 7--12 | " | " | 9" | " | bolted to deck |
| ✓ 8--9 | " | " | 12" | " | " " " |
| 9--24 | " | Steel W.T. Hatch | 9" | Coaming | Admiralty pattern |
| 10-- | " | " | 6" | " | " |
| 11--4 1/2 | " | Swan neck Vent | | | to Buoyancy Chambers P.S. |
| 12-- | " | " | | | " " |
| ✓ | | These were originally Cowl Vents | | | |

Air pipes provided
with closing
appliances.