Rpt. C. 11 (Contd.) Index No. 21621

Lloyd's Register of Shipping.

Ship's Name "FOREMOST 18" *Official No.*

Memorandum of alterations reported since ship was surveyed for assignment of Load Lines in

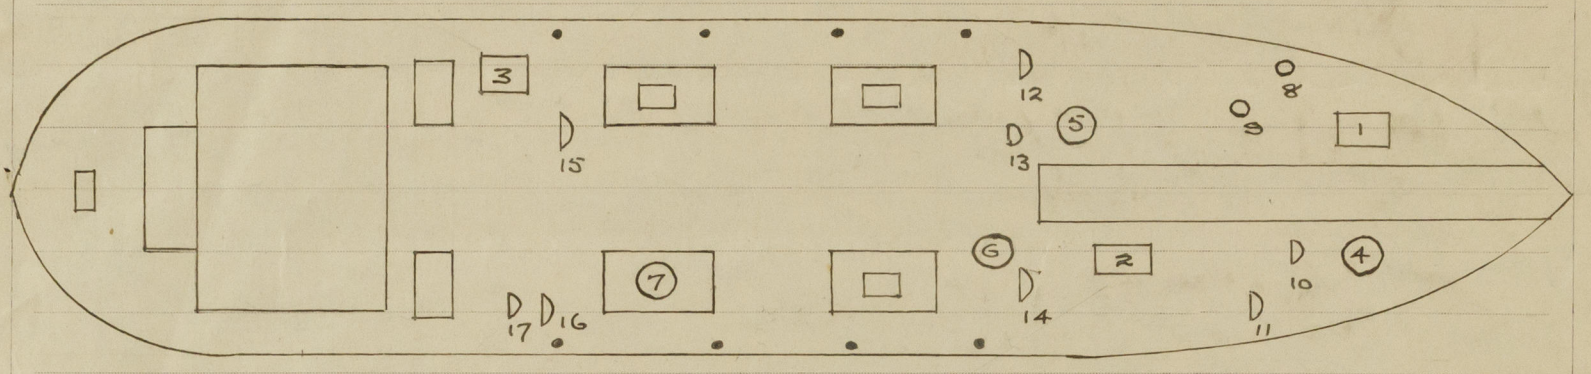

Nos 1-2-3 STEEL SCUTTLE HATCHWAYS. COAMING 5" HIGH. HINGED STEEL DOORS OPERATED BOTH SIDES.

Nos 4·5·6·7. STEEL W.T. HATCH. ADMILALTY PATTERN. COAMING 6" HIGH.

No 8 — 9" MUSHROOM VENT. COAMING 12" HIGH.

No 9 — 12" " " " " ".

No 10 — 11" VENTILATOR, COAMING 12" HIGH. WOOD PLUG & CANVAS COVER FITTED.

No 11 — 7" " " " " " " " " "

No 12 — 5½" " " 15" " " " " " "

No 13. — 7½" " " 12" " " " " " "

No 14 — 7½" " " 12" " " " " " "

No 15 — 10½" " " 12" " " " " " "

Nos 16-17 — 12" " " 12" " " " " " "

ALTERATIONS AND ADDITIONS CARRIED OUT AT WIVENHOE JUNE, 1942, ARE AS FOLLOWS:—

4 — 4½" AIR PIPES FITTED TO PORT & STARB. BUOYANCY TANKS.

Noted [signature] 29/6/42

[signature] 24-6-42.

5m.3,37. T.

002701-002710-0309

© 2020 Lloyd's Register Foundation