

21621

22 AUG 1949

Rpt. C. 11 (Contd.)


Index No.

Lloyd's Register of Shipping.

Ship's Name "FOREMOST 18"

Official No. 132554.

Memorandum of alterations reported since ship was surveyed for assignment of Load Lines in

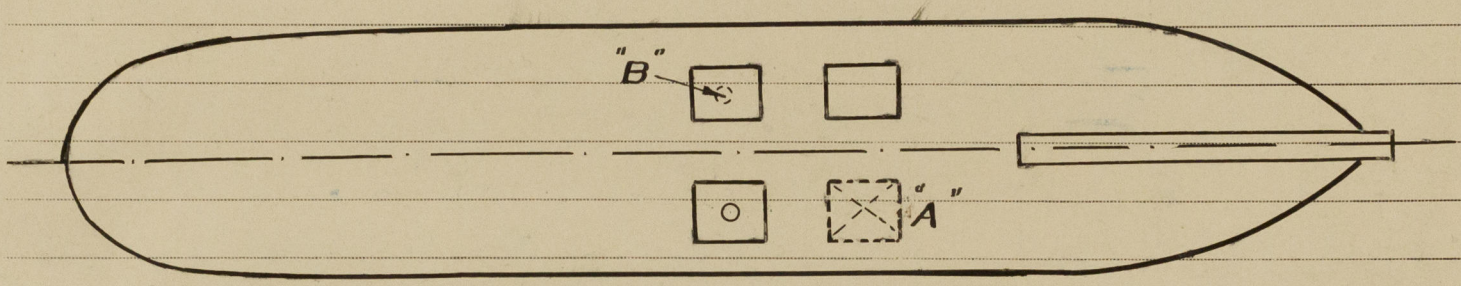

"A" The Forward Starbd. Main Hatch Cover and coaming removed, beams fitted and opening plated over.
"B" Circular Hatch removed from Port After Main Hatch and opening plated over.

A copy of this Report has been placed aboard the ship.

Geo. Smart.
19 AUG 1949.

23 AUG 1949