


28/7/19

Notes: Mr. J. Bullock approved to Rules and Tables in force prior to amendments adopted in May 1918. See note in Rules page 36 of the Rules. If the vessel is to have a Passenger Certificate the Rules should be in accordance with the Rules as at present printed.

 

PROFILE AND DECK PLANS.

S.S. No 505

and 627M, 628M + 629M


SCALE 1" = ONE FOOT.

TO CLASS 100A LLOYDS SHELTER DECK

DIMENSIONS 40' 0" B.P. 52' 2" M.D. 24' 6" M.D.

APPROVED
LLOYDS REGISTER OF SHIPPING

In No 627M, 628M + 629M

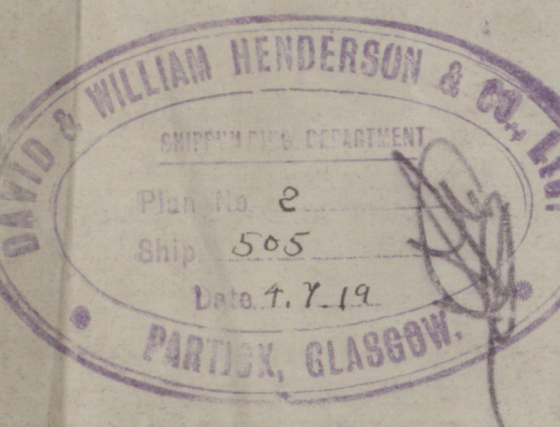

Sectional Section
18 Buck Plans

Sectional Section
12 505-6-7

BENVANNOCH

EX

627 "Dorelian"

511

Dakarlian

✱

GLS. 41501.

N.M. BIRCHBANK

GLASGOW REPORT No. 42757

506

ss. "Dakotian"

NIN INDUS MARU

"Birchbank"

GLASGOW REPORT No. 41663

W.S. 697

7/2 Darian

507

GLASGOW REPORT No. 4197

508

GLASGOW REPORT No. 42265

Daytonian

511

GLASGOW REPORT No. 42532

Davonian

512

"Delilian"

GLASGOW REPORT No. 42643



© 2020
Lloyd's Register
Foundation