

S.S. "DAVISIAN."

WILLIAM HENDERSON & CO., LTD.
SHIPBUILDING PARTNERS
Plan No. 264
Ship S.S. Danianian
Date 8-3-23.
PARTICK, GLASGOW.

[illegible]

FRAMES 9° 33' 46.8" BETWEEN PEAK BULKHEADS SPACED 26' APART
7° 33' 44.8" IN PEAKS SPACED 26' APART.
FRAMES TO EXTEND TO UPPER AND LOWER DECKS ALTERNATELY
EXCEPT IN WAY OF RIDGE PEAK WHERE ALL FRAMES EXTEND TO LOWER DECK AND IN WAY OF 25
AFTER PEAK WHERE ALL 3A FRAMES EXTEND TO UPPER OR IN WAY OF BRIDGE FRAMES TO EDGE (SHOULDER DMS ALTERNATELY).
INTERMEDIATE FRAMES OF 33° 44' 40" ANGLE BETWEEN 1/4" PORT AND COLLISION END AND AFT OF AFTER 1/4" TO AFT PEAK AND
IN AFTER PEAK. ANGLE FRAMES 6° 33' 38" BETWEEN UPPER & SHOULDER DMS. ON EVERY FRAME BUILT TO UPPER DECK.
NO INTERMEDIATE FRAMES BETWEEN 1/4" L. FORWARD AND AFTER 1/4" L.
INTERMEDIATE FRAMES SCARRED AT UPPER DECK.

<u>RUDDER POST 9' 7 1/2"</u>	<u>PROPELLOR POST 10 1/2' 7 1/2"</u>	<u>STEM 10' 3" 10' 1/2"</u>
<u>RUDDER AS PER RULE</u>	<u>BULKHEADS AS PER PROFILE.</u>	<u>RIVETS TO BE OF IRON.</u>

BRIDGE DECK PLATE BUTTS OVERLAPPED & DOUBLE RIVETED.
SHEATHES (HARDOR) _____ FOR 2/3 REMAINDER SINGLE
MAIN DECK _____ SINGLE - EXCEPT STAYE MENTHATHES TO BE 2R
ALL DECK LANDINGS TO BE SINGLE RIVETED.

TANK TOP CENTRE STRAKE BUTTS OVERLAPPED 3R FOR 1/2 REMAINDER 2R.
 PLATING BUTTS OVERLAPPED 2R FOR 1/2 REMAINDER 1R 3R IN 8 SPACES
 MARGIN PLATE BUTTS OVERLAPPED 3R FOR 1/2 REMAINDER 2R.
 CENTRE GIRDER 3R THROUGHOUT.



IN BUTTS OF KEEL PLATE RIVETS TO BE 3/8 DIA WHERE OVER .88" / DIA ELSEWHERE.

" " " SHELL " " " 7/8 " " " .48 AND 3/4 WHERE .48 UNDER.

" " " SHEERSTRAKE " " " 6/6 " 7/8 " OVER .48, 3/4 ELSEWHERE.

LANDINGS OF REEL 6" x 6" 5/8 GRV. RESPECTIVELY PER FRAME SPACE (EXCLUDING RIV IN FRMS).
IN LANDINGS OF SHELL PLATES WHERE OVER 66 TO BE (DIA. LAND'G NIDE 6 GRV PER FR SPACE (EXC. RIV IN FR).
48" 7/8" 5/4" 7" 6 GRV IN FRM
48" 7/8" 4 1/2" 8" 7" 7"

5 1/2 DIA THRU FRAMES & SHELL IN DEEP TANKS PEAK BALLAST TANKS & BOTTOM FOR 1/6 LENGTH

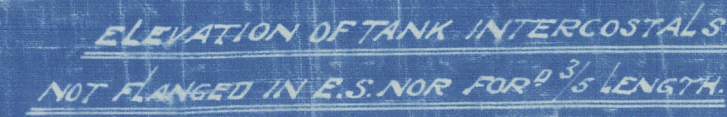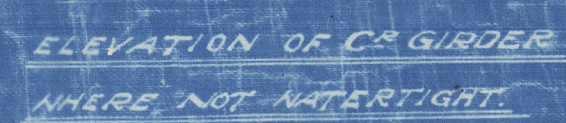

S. S. "Davision"
J. W. Henderson Esq.
No. 511.

Midship Section
Vessel as built

"
"Davision"
"

Prpt No 42532.
42832.

Transferred to
Indus Marine *

W.S. 697



© 2020

Lloyd's Register
Foundation

002711-002716-0127