


# "LOCH DEE" S.S. N° 578. DECK PLANS.

409'-0" L.B.P. x 58'-6" B.M.P. x 38'-7" D.M.P. UPPER DECK.  
28'-0" " SECOND "


COMPLETE SUPERSTRUCTURE TYPE.

CLASS 100A1 LLOYDS.

SCALE 1/8" = 1 FOOT.

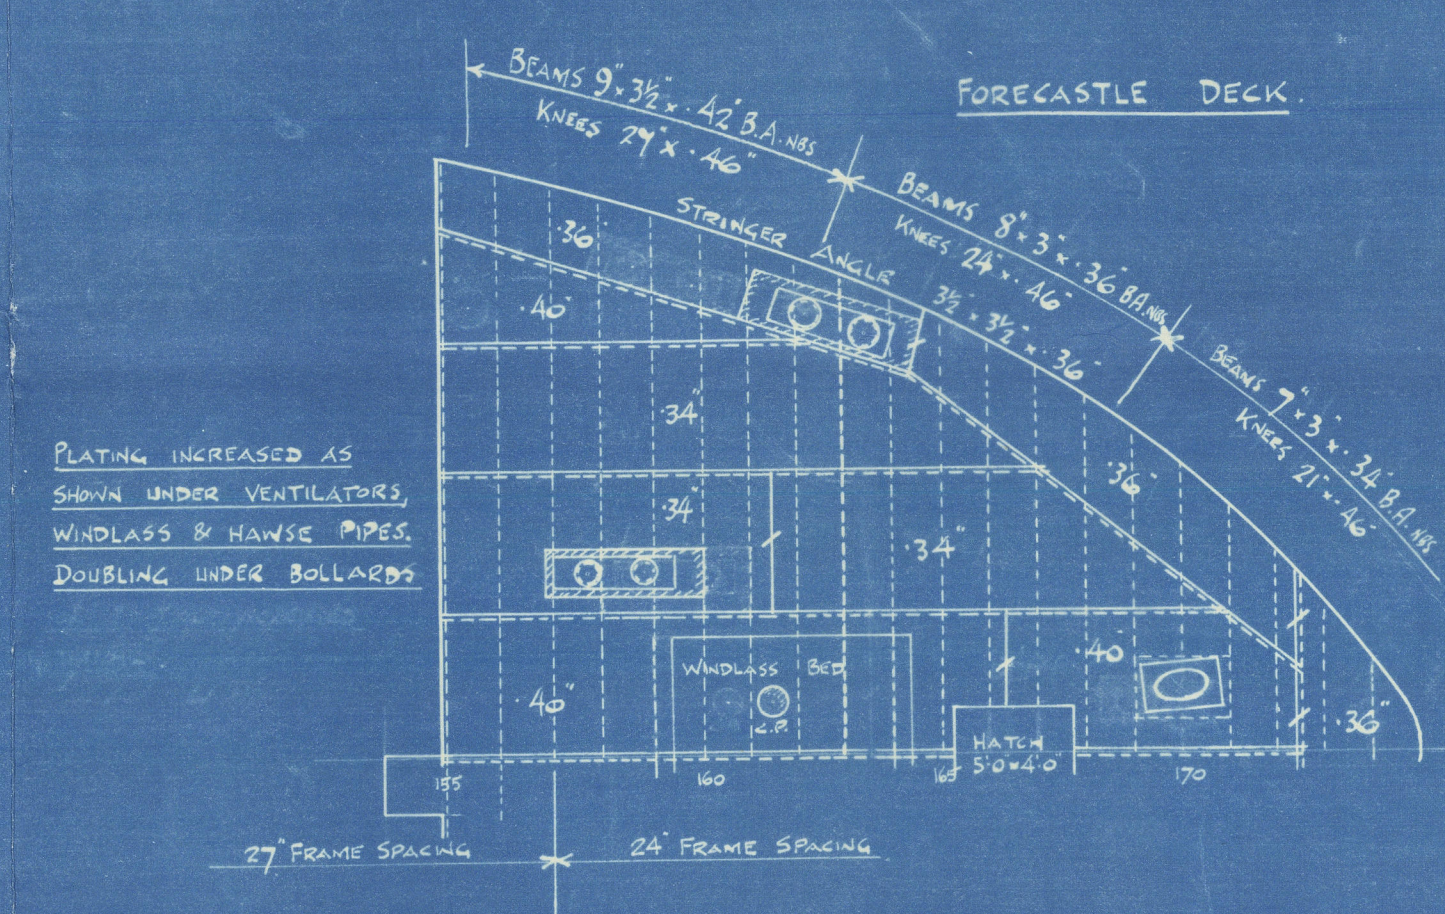


## UPPER DECK.

 


## SECOND DECK.


## SECOND DECK

 


## 3<sup>rd</sup> STRINGER BELOW 2<sup>nd</sup> DECK

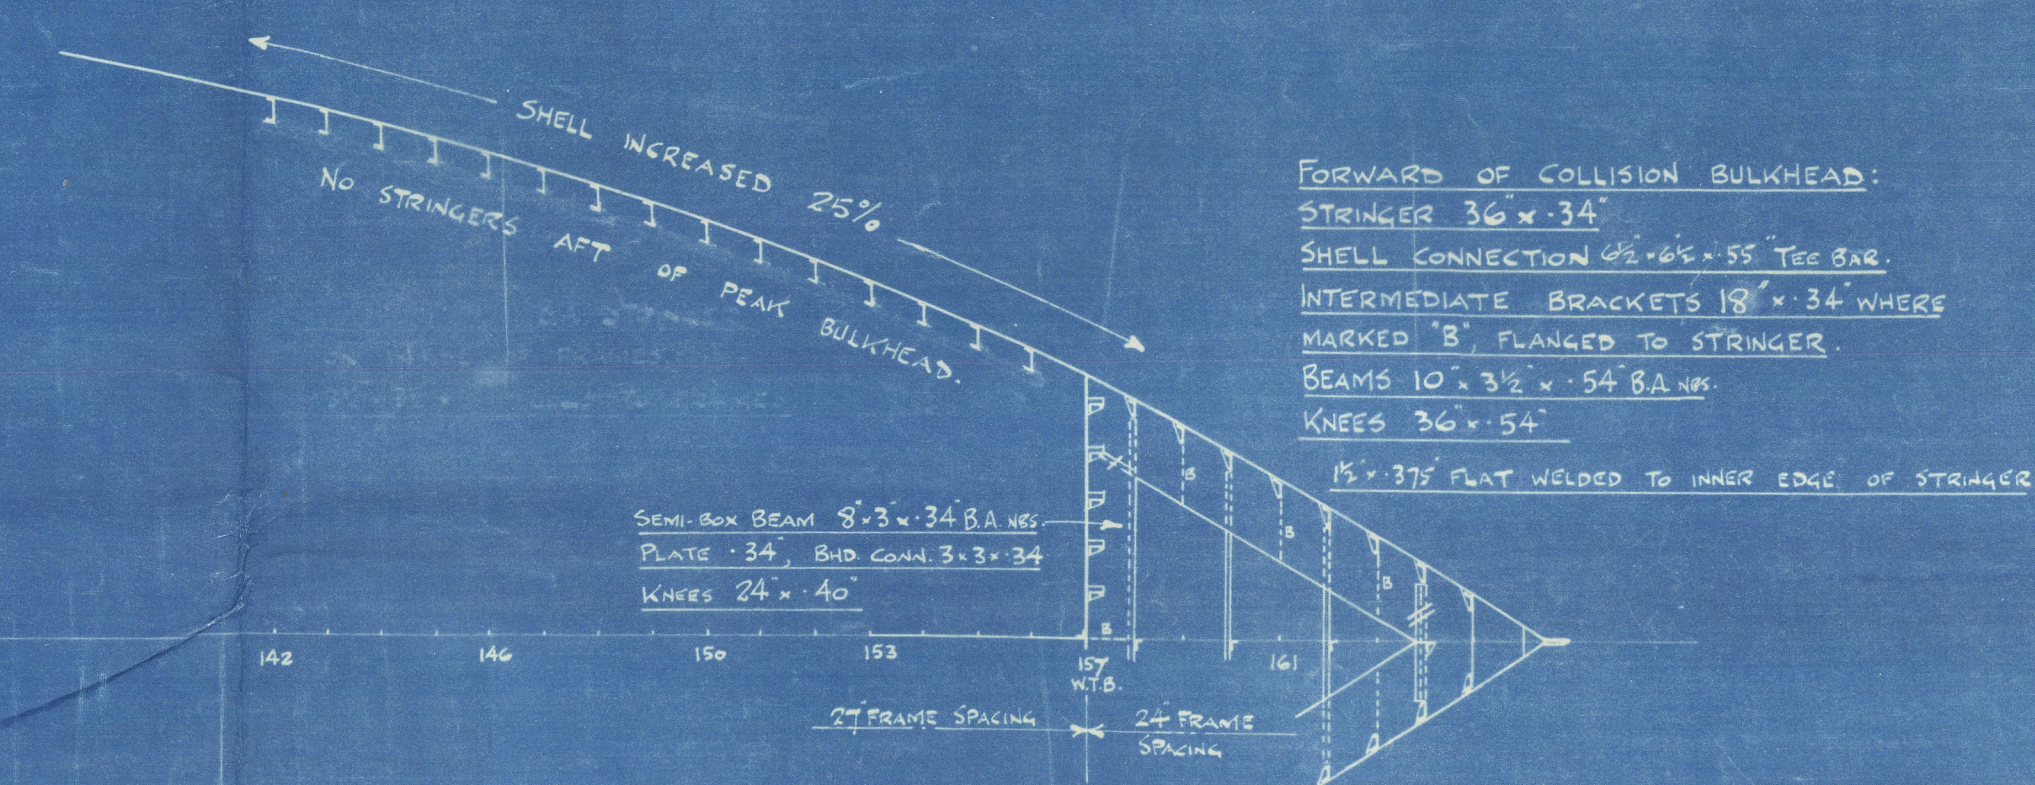


## 2<sup>nd</sup> STRINGER BELOW 2<sup>nd</sup> DECK

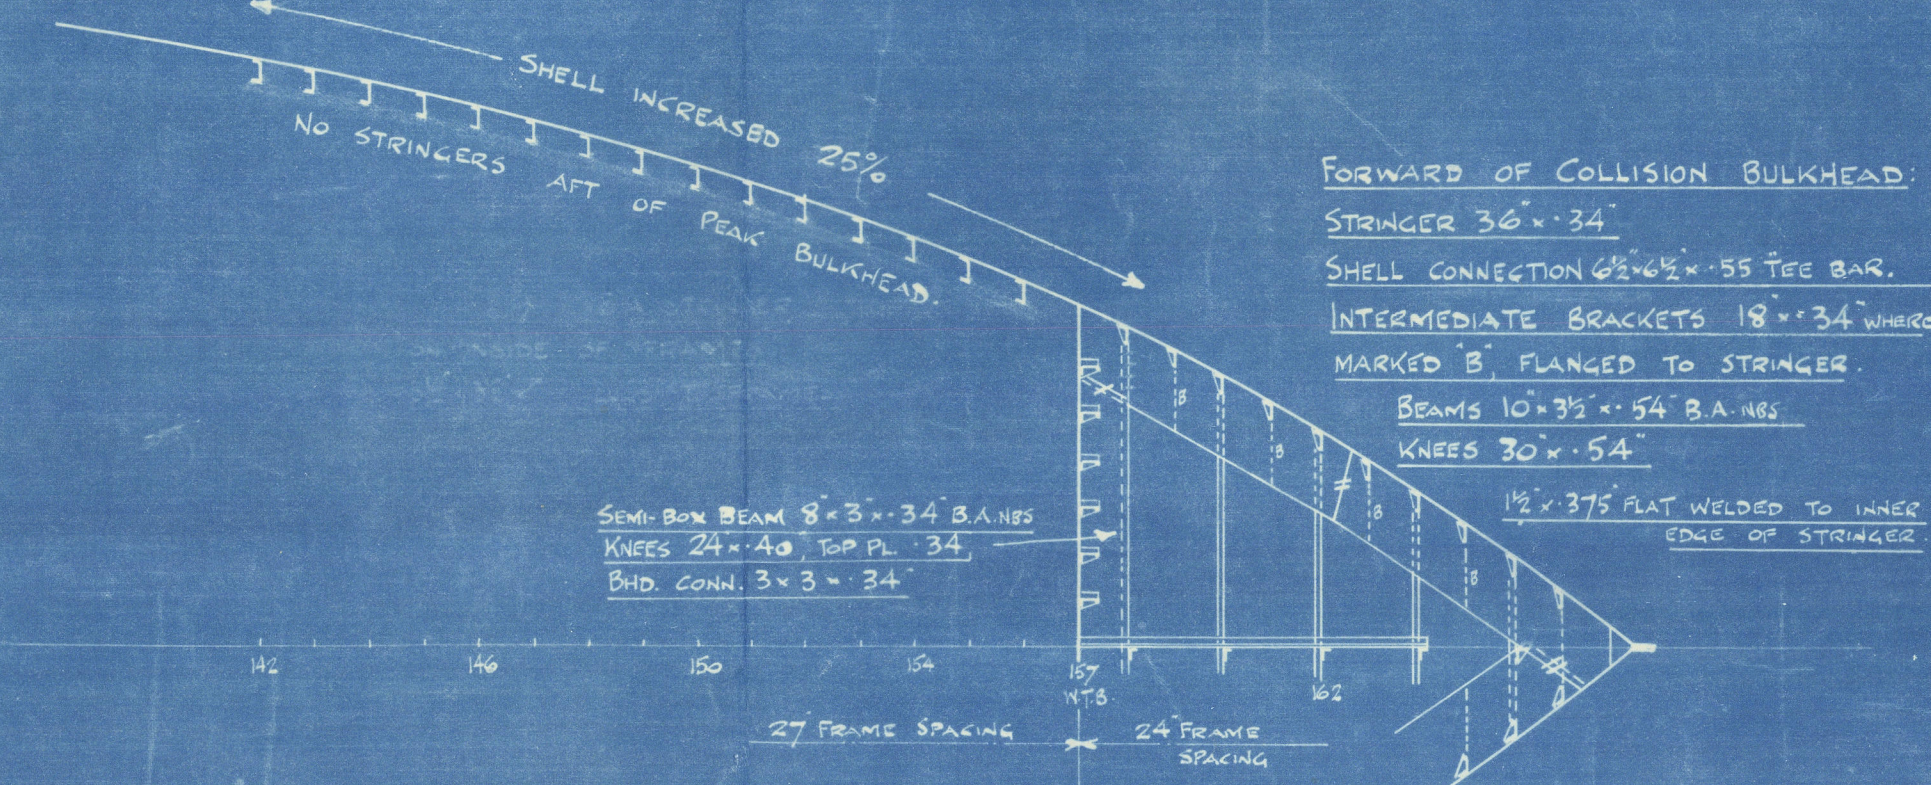

## SKETCH SHOWING OPENINGS FOR VENTILATORS IN 2<sup>nd</sup> DK. STRINGER.

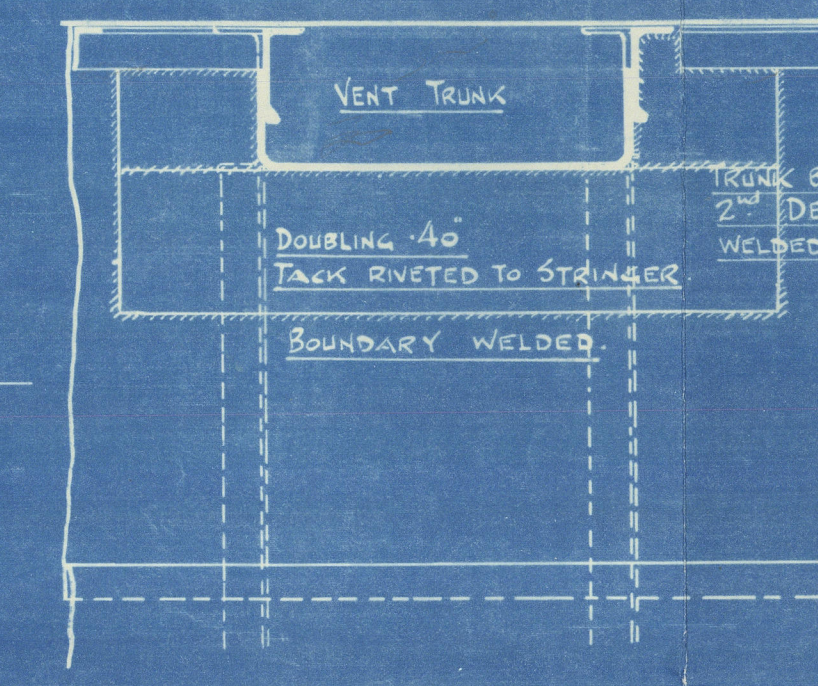

## 1<sup>st</sup> STRINGER BELOW 2<sup>nd</sup> DECK

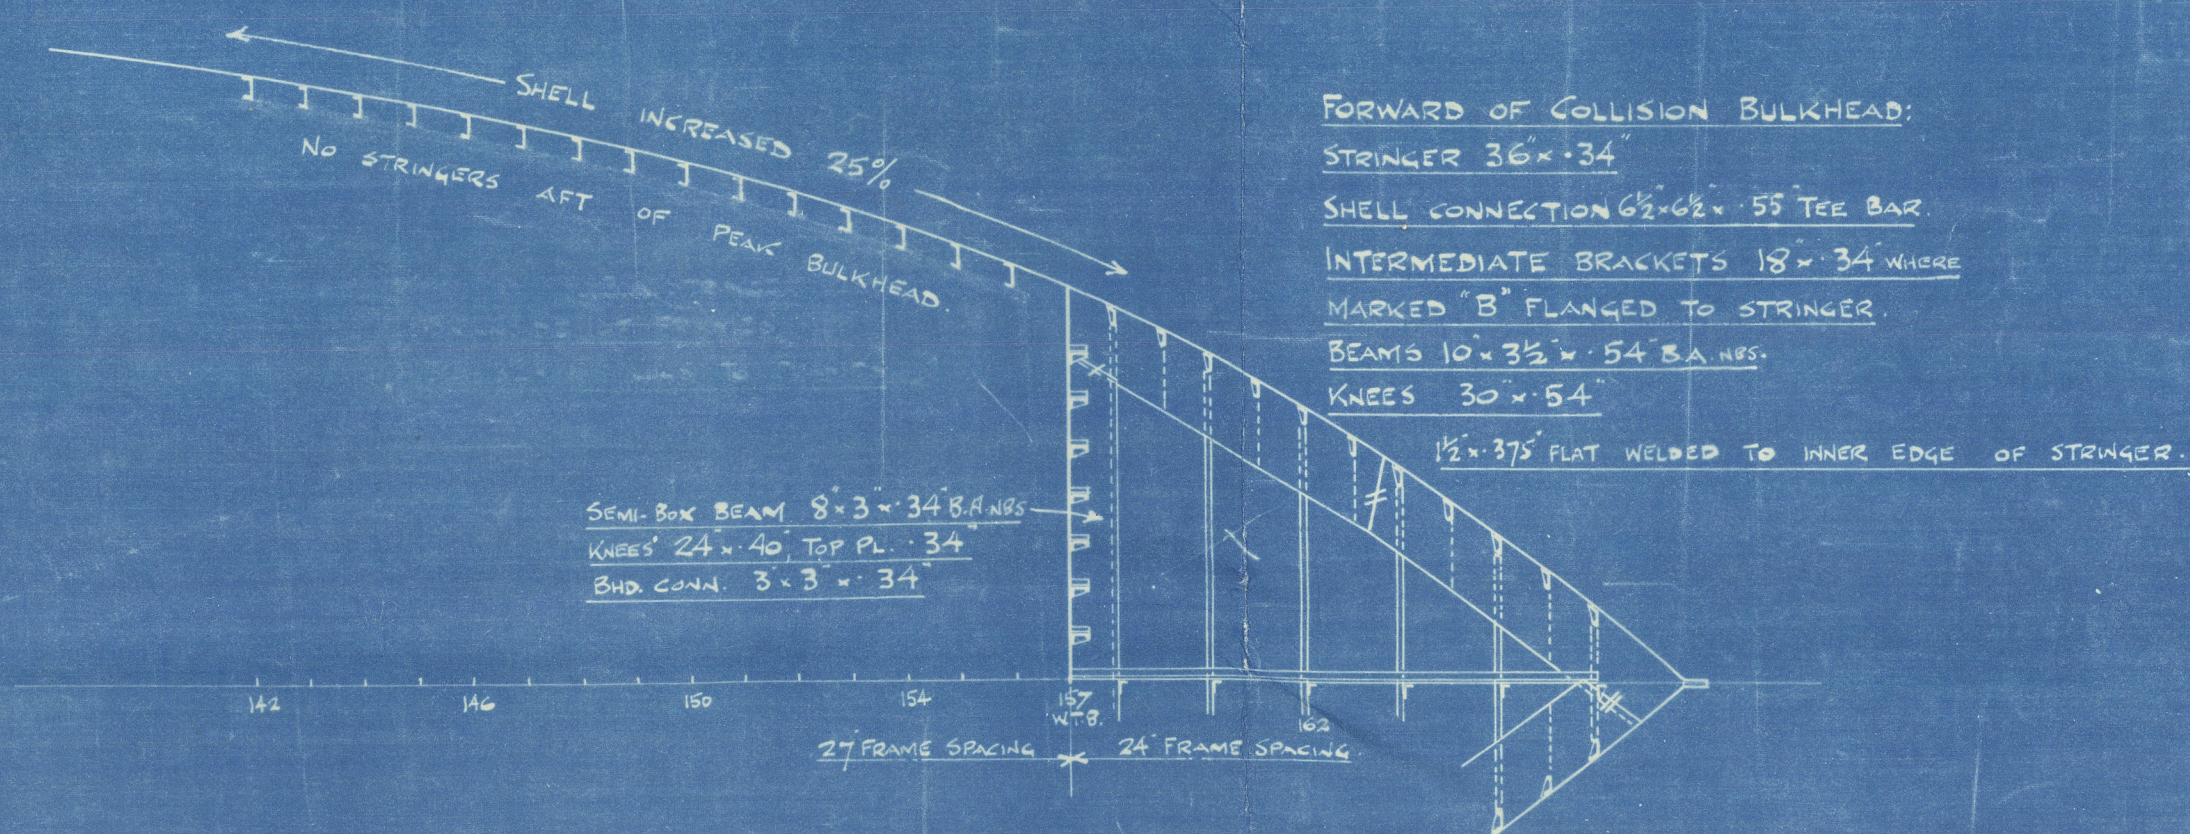



SUNDERLAND.

Messrs. J. & L. Thompson & Sons, Ltd.,  
SS No 578.

S.S. "LOCH-DEE"

Profile DECKS

As Built.



S.S. "LOCH-DEE"

SUNDERLAND REG NO 32094.



© 2020

Lloyd's Register  
Foundation

002711-002716-0177