

36613

14 OCT 1953

Index No.

Lloyd's Register of Shipping.

N^o 36899


Ship's Name *ZONNEWIJK.*

Official No. -

Memorandum of alterations reported since ship was surveyed for assignment of Load Lines in white building

Small entrance hatches for access to holds have been made on foreward deck as shown on sketch below. The following particulars regarding these hatches are correct:

| Hatch N ^o | 1. | 2. | 3. and 4. |
|--------------------------------|--------------------|---------------------|---------------------|
| Dimensions | 750 x 610 mm | 810 x 540 mm | 750 x 650 mm |
| Height above deck | 620 mm. | as N ^o 1 | as N ^o 1 |
| Thickness covering | 11 mm | " | " |
| Bearing surface for hatchcover | 65 mm | " | " |
| Hatchcover mat. | Pine | " | " |
| Thickness. | 2 1/2" | " | " |
| Cleats (spacing) | not exceeding 24" | " | " |
| Patterns | as per Rules. | " | " |
| Wedges | supplied acc. R.R. | " | " |
| Tarpaulins | 2 each hatch | " | " |

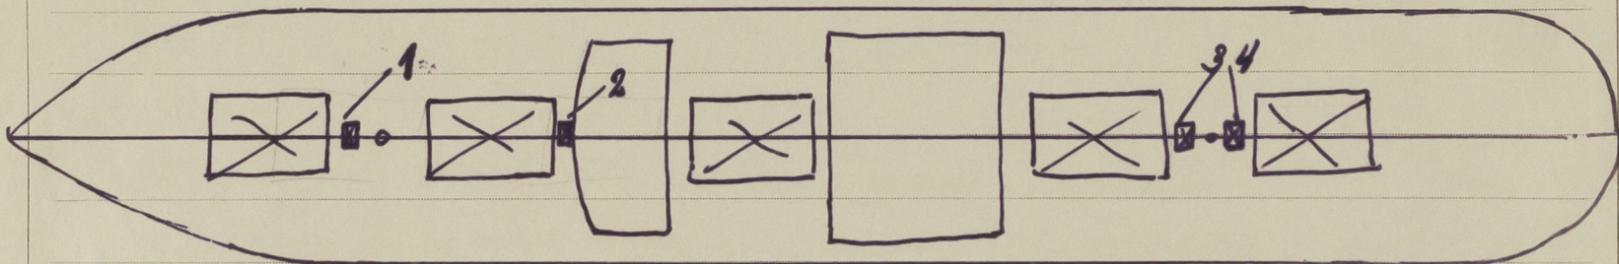

A. B. Muller




© 2020

Lloyd's Register Foundation

1361120 91


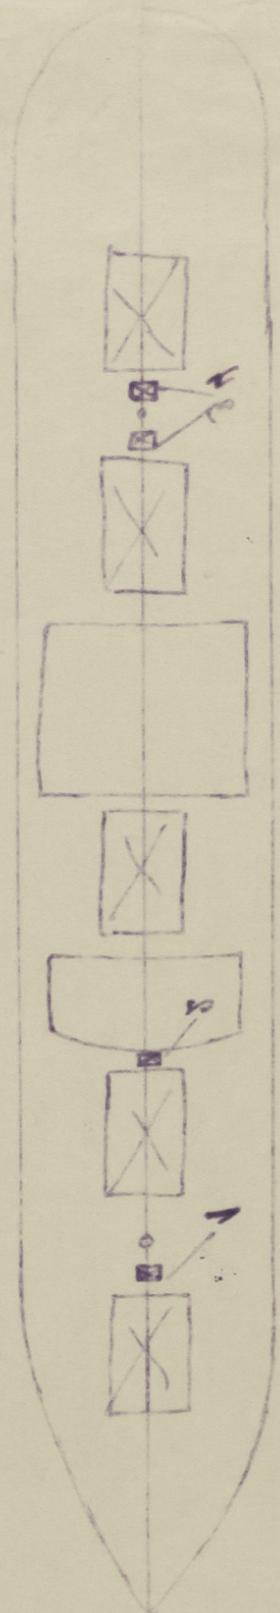


