

20-12-32

Burntisland S.B.Co's No. 176

Adopted Alternative Arrangement of  
Frame Bracket Connection

6- $\frac{3}{4}$ " R. all for a.


~~7- $\frac{3}{4}$ " R. for a.~~

~~spacing closed up  
as shown~~

6 R.

x

Single run (No 8) on  
upper end of connecting  
angles inside + outside  
margin plate

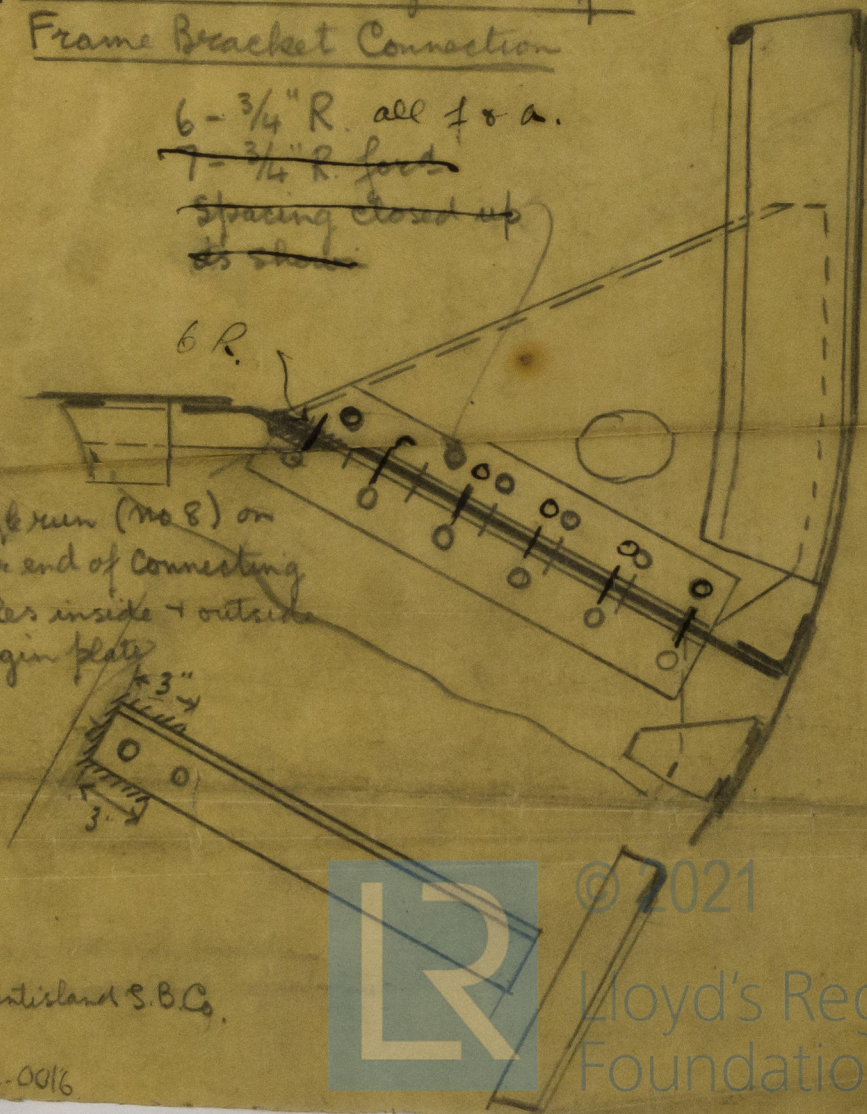

1 Copy to Burntisland S.B.Co.

007736-007742-0016



© 2021

Lloyd's Register  
Foundation