


SHIP N° 176.

# PROFILE & DECKS.

SCALE  $\frac{1}{8}$ " = ONE FOOT.


DIMENSIONS: LENGTH L.W.L. 193'-0" BREADTH MLD 32'-1" DEPTH MLD U.D.K. 15'-12"  
TO CLASS B.S.\*

ENGINE & BOILER CASING COAMING: 34" x 18"  
SIDES: 28" TOPS: 25"  
STIFFS: 4" x 2' x 26" @ 30" APART

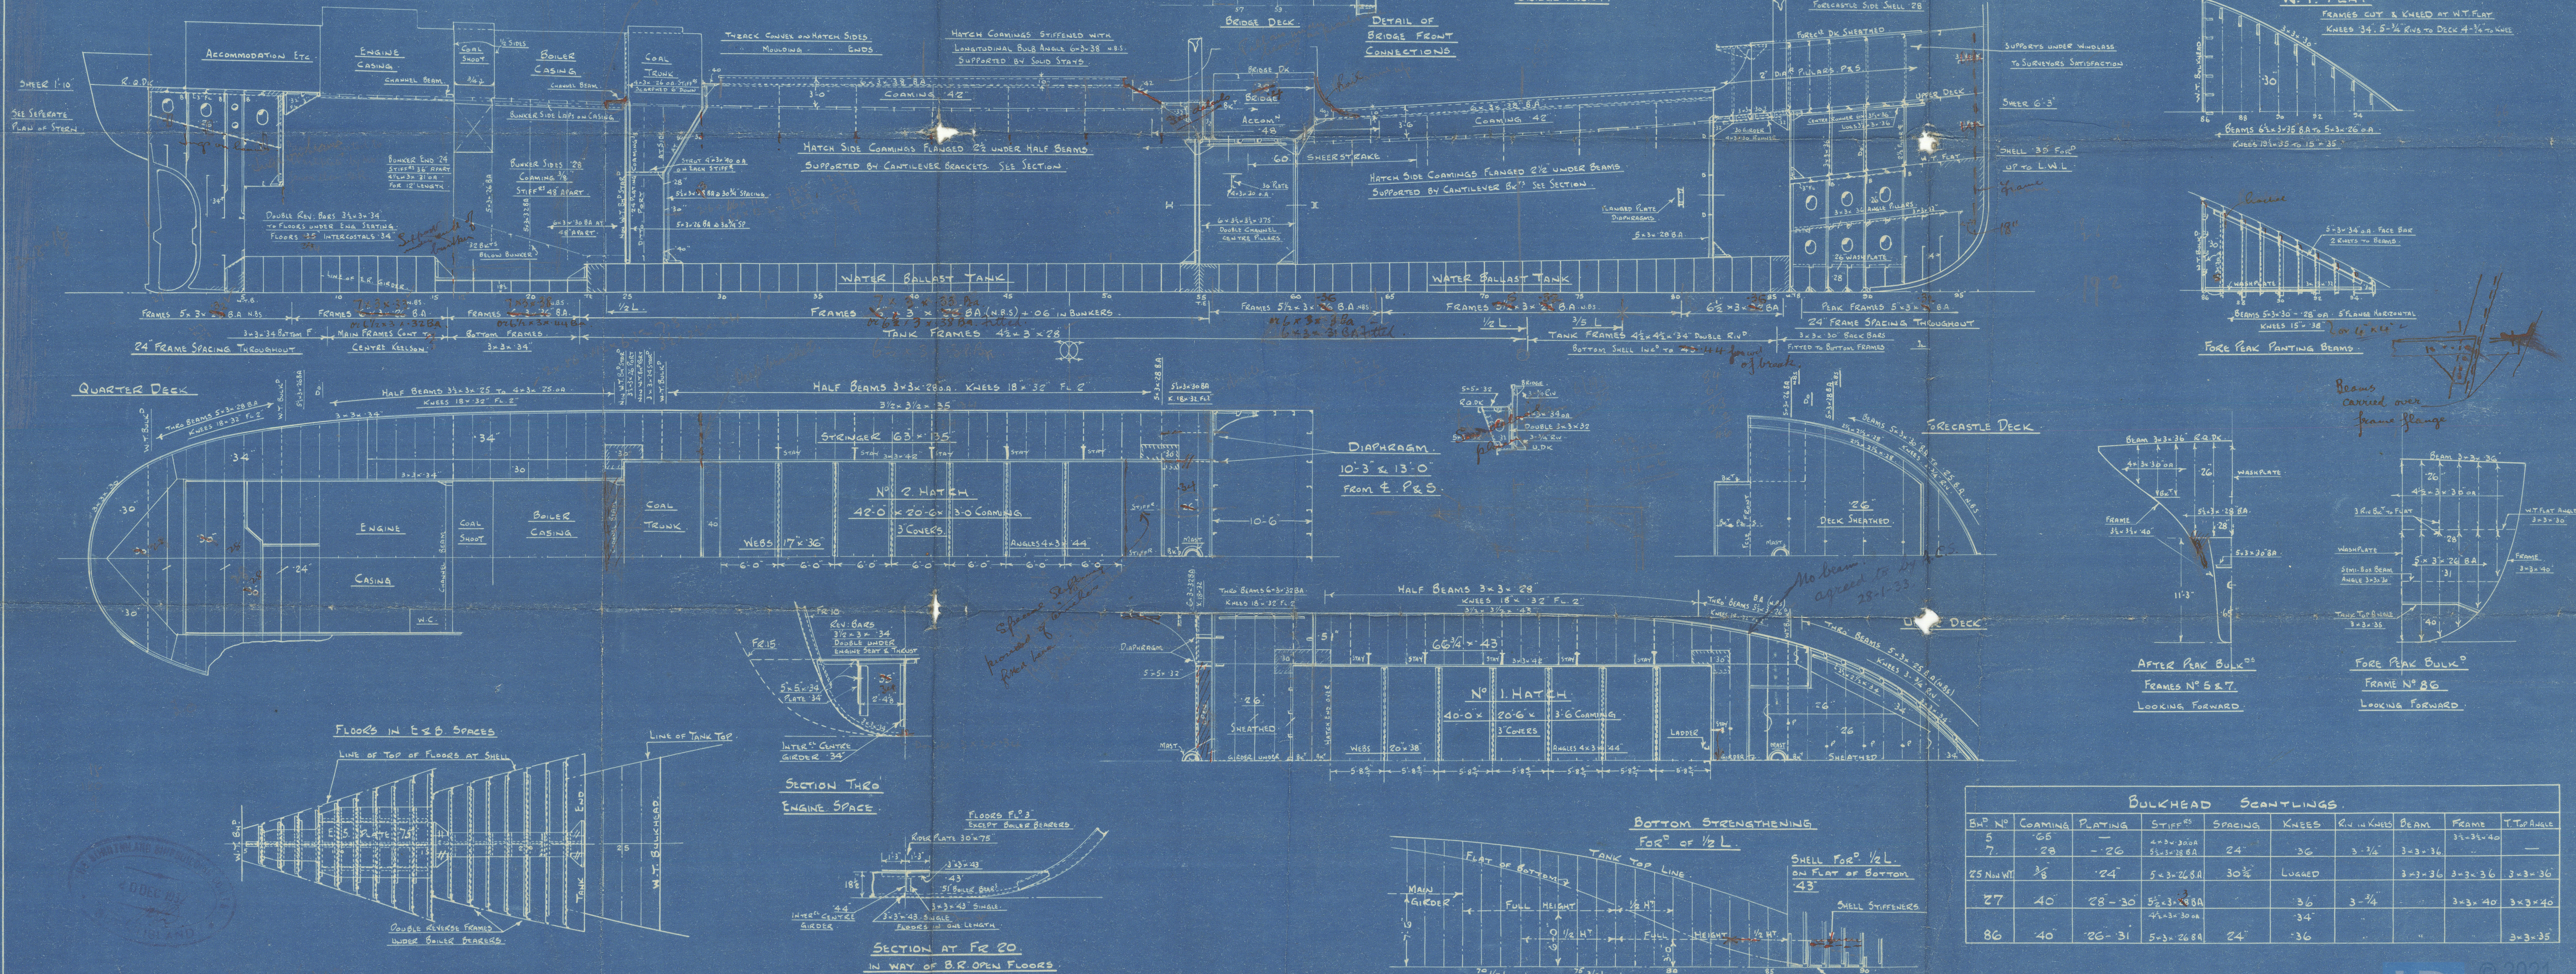

31 DEC 1932

Approved  
23.12.32

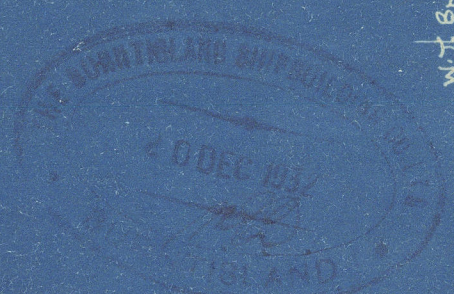



8

Latest Profile & Deck.

B.C. SKETCH OF  
PROP. BREAK AT  
R.Q. DECK.  
ATTACHED.

Quintisland S.B. Co.

No. 176.

T.C. 1-3-33.

22-12-32.

$\frac{3}{4}$ " CEDARWOOD

Bag



© 2021  
Lloyd's Register  
Foundation

002736-002742-0017