



Burnt Island Shipbuilding Coy. No. 176.

Proposed Arrangement at Break of R.Q.D.

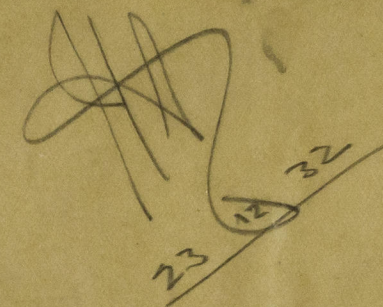


R. Q. D. Scarph Bracket at Line of Hatch Coaming

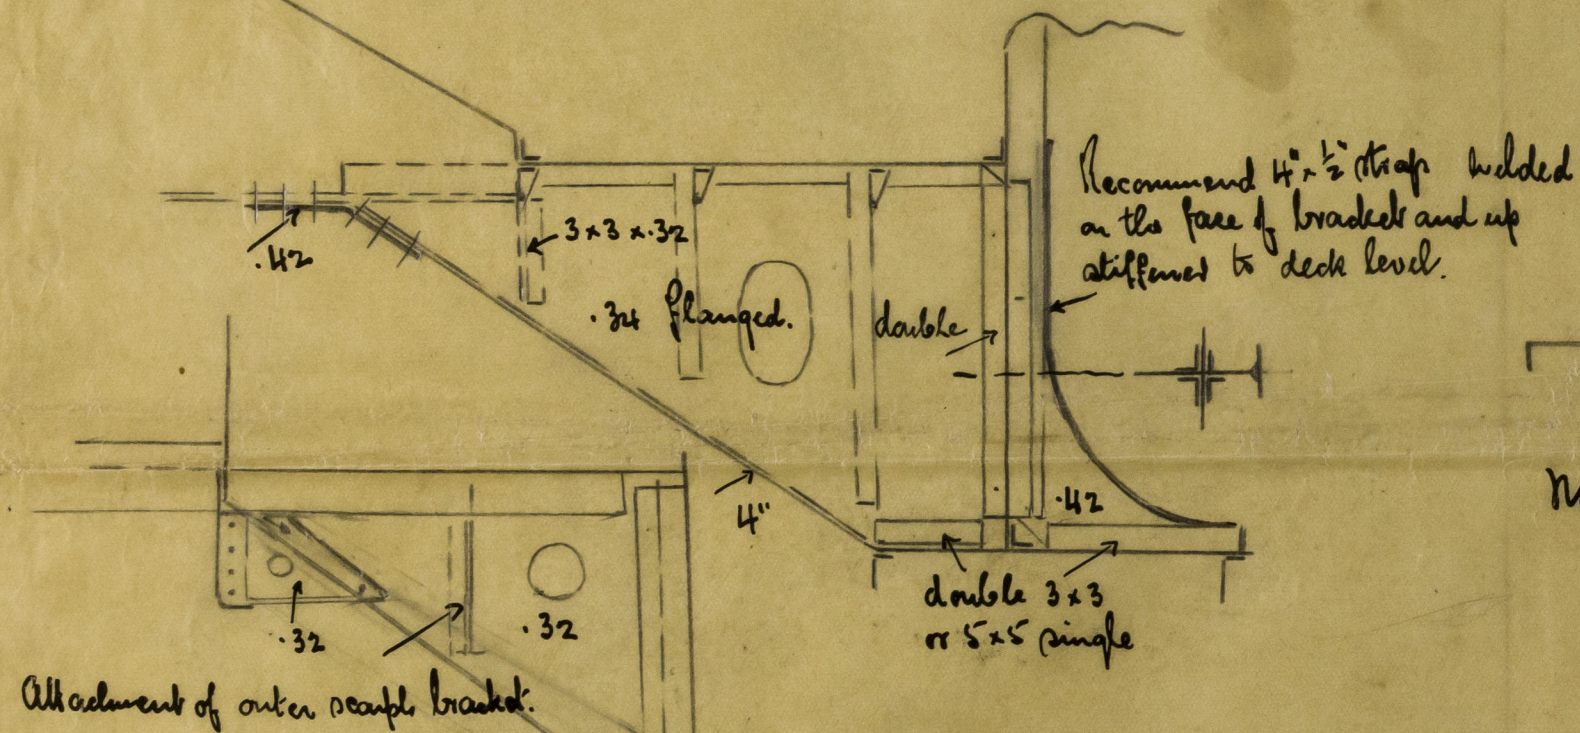


Cantilever Bracket at Hatch end

Centre Line Bracket

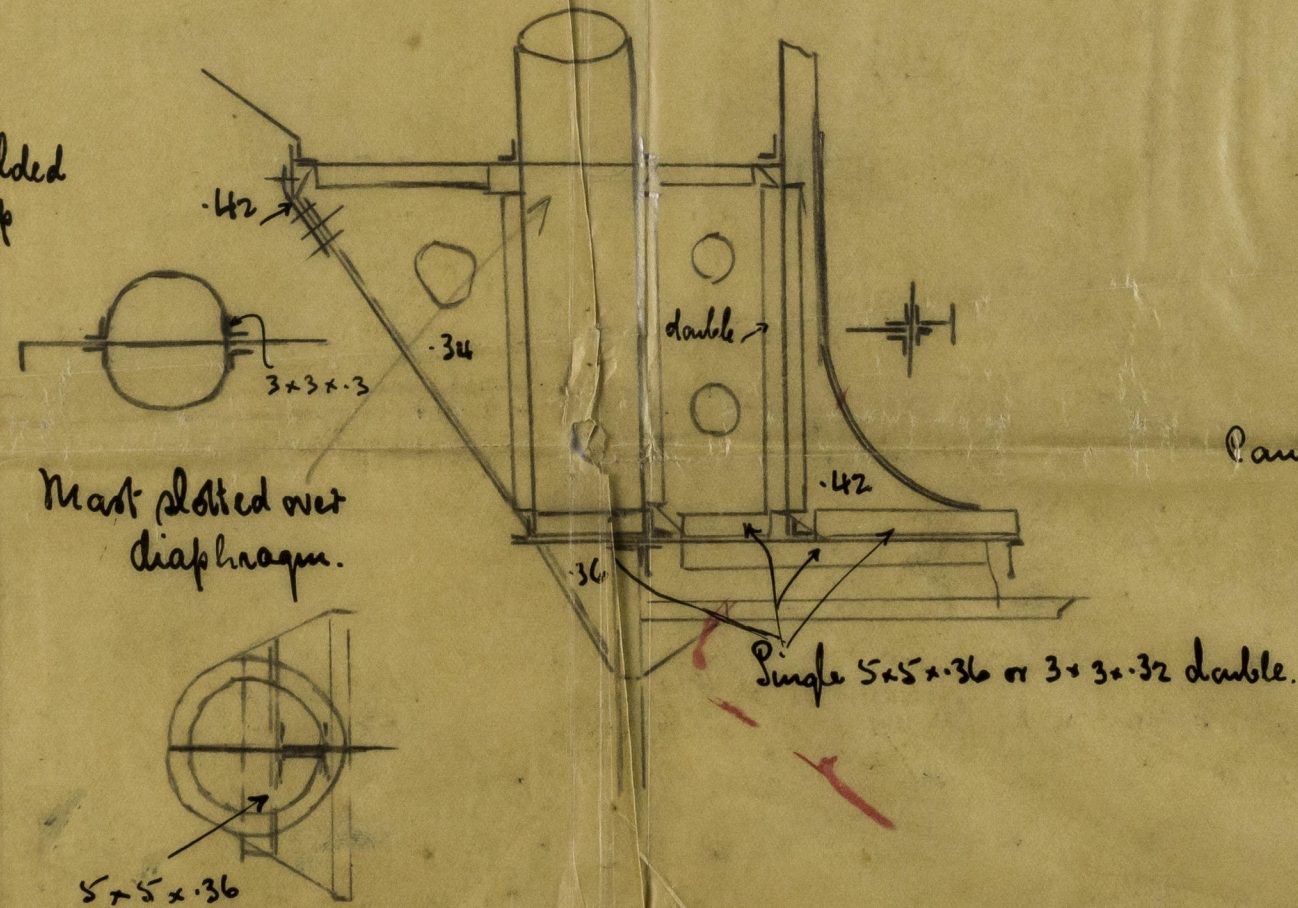

Outer R. Q. D. Break Bracket

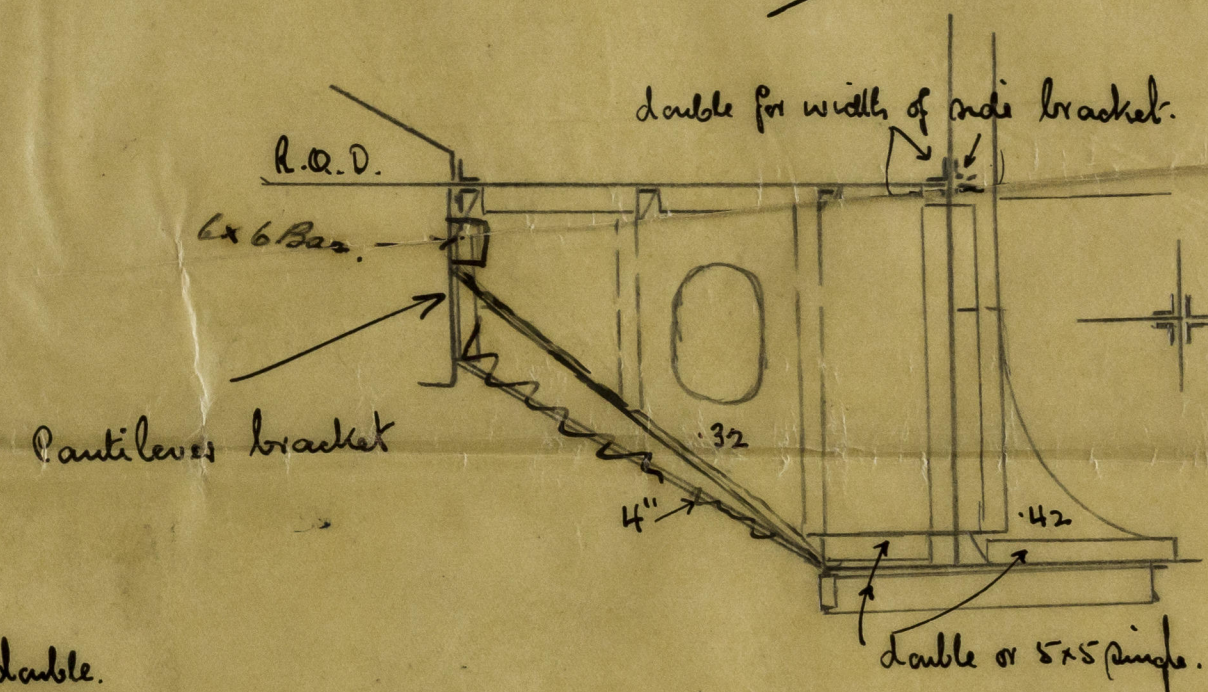

© 2021
Lloyd's Register
Foundation

002736-002746-0018