

Lloyd's Register of Shipping.

Ship's Name "CEDARWOOD" Official No. 160737

Memorandum of alterations reported since ship was surveyed for assignment of Load Lines.

on


Exposed machinery casings on R.Q.D. now fitted with hinged steel weathertight doors capable of being closed from both sides. It is noted that gangways at forward and after ladders have been dispensed with and lifelines substituted.

N. A. Adamson

Surveyor to Lloyd's Register
of Shipping,
West Hartlepool.
8-10-56.


Nos 1 & 2 Hatches now reconstructed to take new Rose type Hatch Beams.

Coaming :-

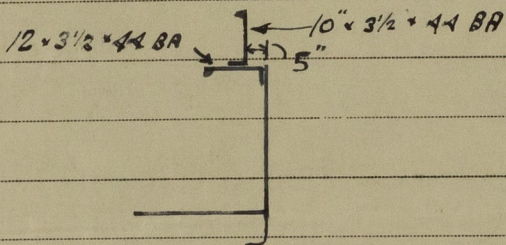

Height of Coamings
4'-8" above Upper Dk.
3'-5" above R.Q. Dk.

Hatch Beams :-

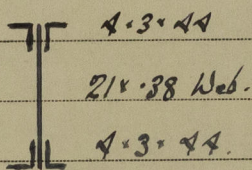

	Upper Dk.	R.Q. Dk.
Number of Beams	5	6
Spacing	6'-0"	5'-9"

N. A. Adamson

20th May 1957.

