

14 DEC 1955

LLOYD'S REGISTER OF SHIPPING

UNITED WITH THE BRITISH CORPORATION REGISTER

F-3161

Ship's Name "SYDNEY BREEZE" (EX. "STAR OF ADEN" 9,55) Official No. 143604

Memorandum of alterations reported since ship was surveyed for assignment of Load Lines
in Alteration.

Bridge Deck - Starb'd - Trimming Hatch forward of Engineers Deckhouse now reduced in
length to 4'-0" x 4'-0" and deck opening forward plated over.

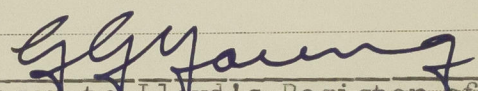
Upper Deck in Bridge

Trimming Hatches Port & Starb'd.

Frames 82-86) B.A. Coamings removed and deck opening
92-96) plated over.

Coal Hatch Forward of Boiler Room Casing

Frames 92-94 - Coaming removed and deck opening plated over.


Surveyor to Lloyd's Register of
Shipping.

KOBE: 12th November, 1955.

Noted D.M. 29 DEC 1955



© 2020

Lloyd's Register
Foundation

002743-002749-0052