

PROFILE AND DECK PLANS

DIMENSIONS - 110'-0" B.P. x 53'-6" M.D. 35'-4" S.D.  
29'-4" U.D.

SCALE 8" = ONE FOOT


5 CLASS B S

MINIMUM SCANTLING REQUIRED


MOULDED DRAFT 24'-0" M.D. BLOCK COEFF. APPROX .75

STW " 25'-0" B.K.

NORMAL SHEER

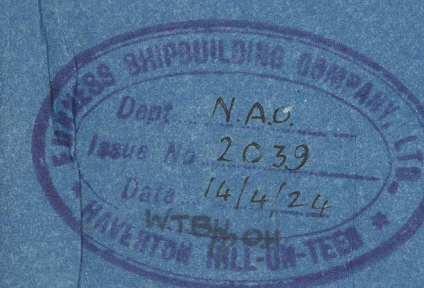

Detail plan of Hatch girders  
Laid and beams etc to be submitted

 



Jurness

77

Profile & decks

See

SEE LATER

Jurness S. boy.


44

Profile & decks

14.4.24.

5

002743-002749-0147

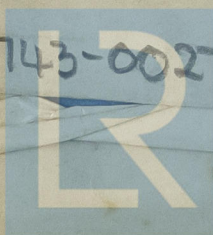

© 2020  
Lloyd's Register  
Foundation