

18

# FORE END SECTIONS


DIMENS. L.B.P. 485'0" x B.D. MAX 74'40" (22.14m)  
UPPER DECK 75' 8 1/2" (2.30m) X DECK 112' 37' 0" (34.25m)  
(147.375m)

THE BRACKETLESS SYSTEM (PATENT)


SCALES - PROFILE & DECK 1/100 SECTION & PLAN VIEW OF STRINGER 1/100

ALL BULB ANGLES ARE NEW GERMAN STANDARD SECTIONS


NOTES FOR CONSTRUCTION TO BE WELL BOUNDED AT CORNERS AND ROUNDED PUNCHED POSITIONS OR SHOWN ARE ONLY APPROXIMATE. THE FILE DIPS IN CONCRETE LINES MAY BE OF OTHER SECTION THAN SHOWN IF US EQUIVALENT OR IF HORIZONTAL SPACING EXCEEDS 100% SUPPORTS ARE TO BE FITTED AT APPROPRIATE SPACINGS. THE SPACING OF STRINGS SHALL BE TO RULE. ALL SECTIONS AND DECKS CORRECTED FORWARD.

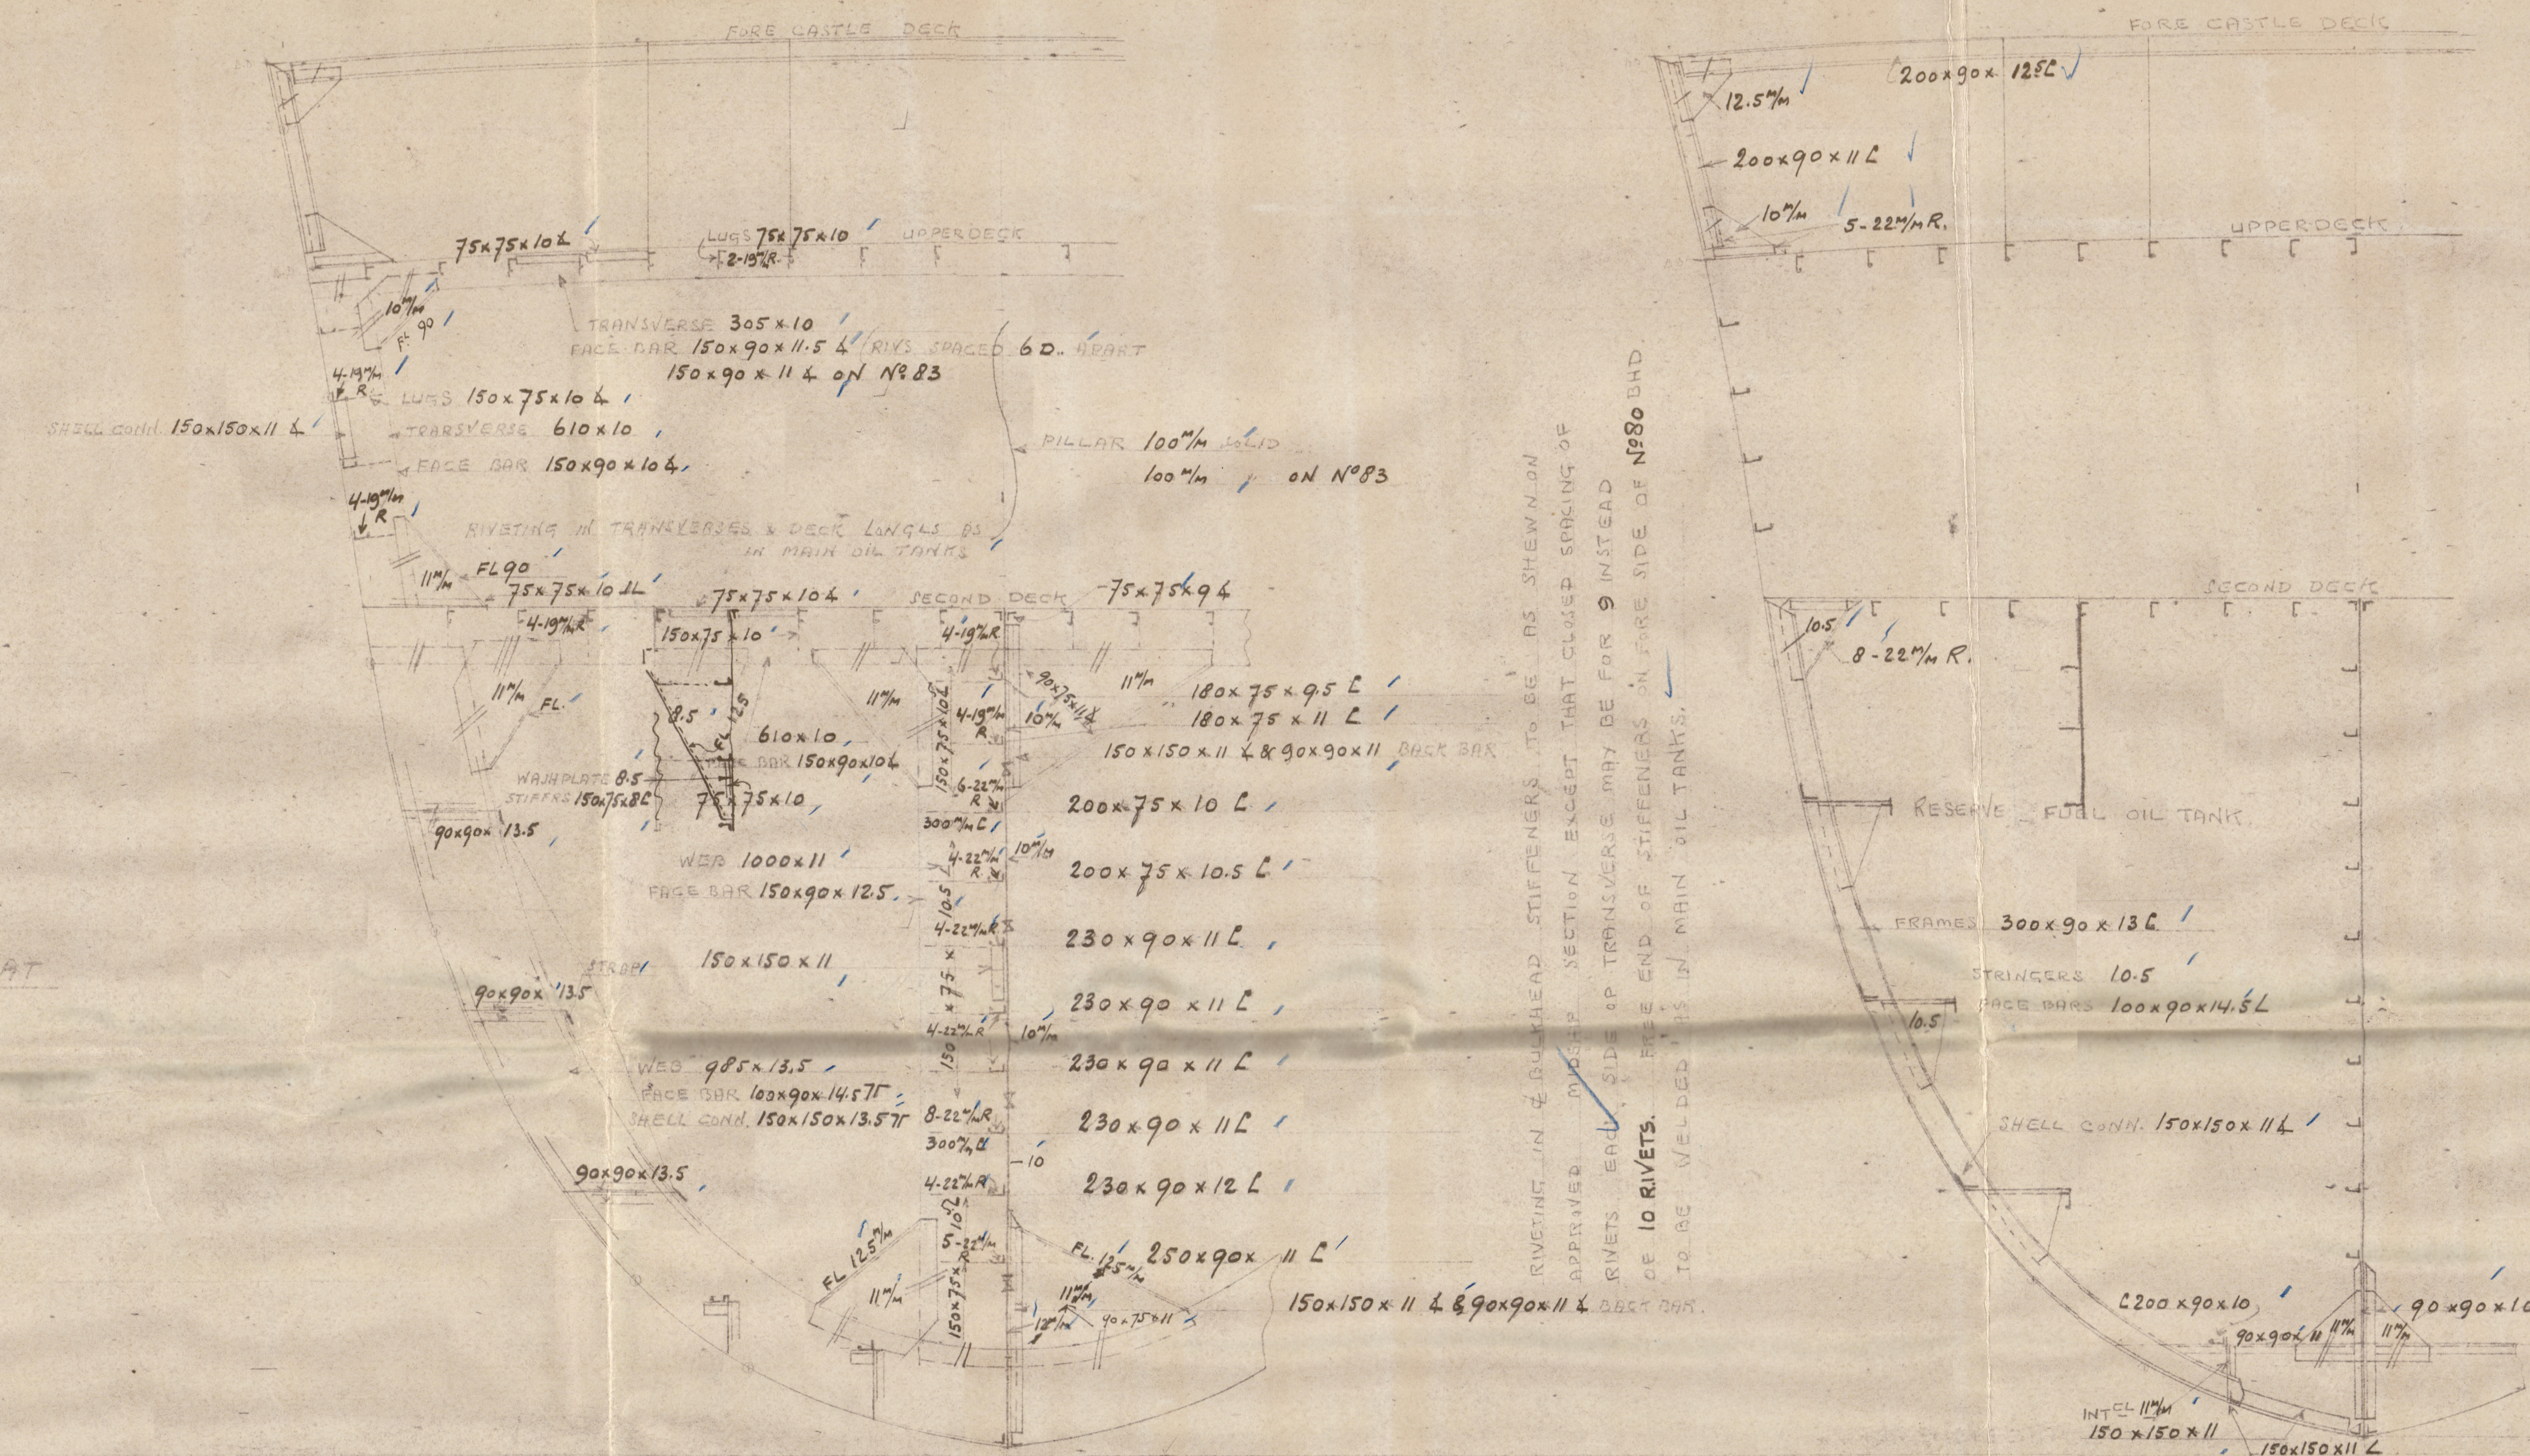

TRANSVERSE No 86 & 82  
No 86

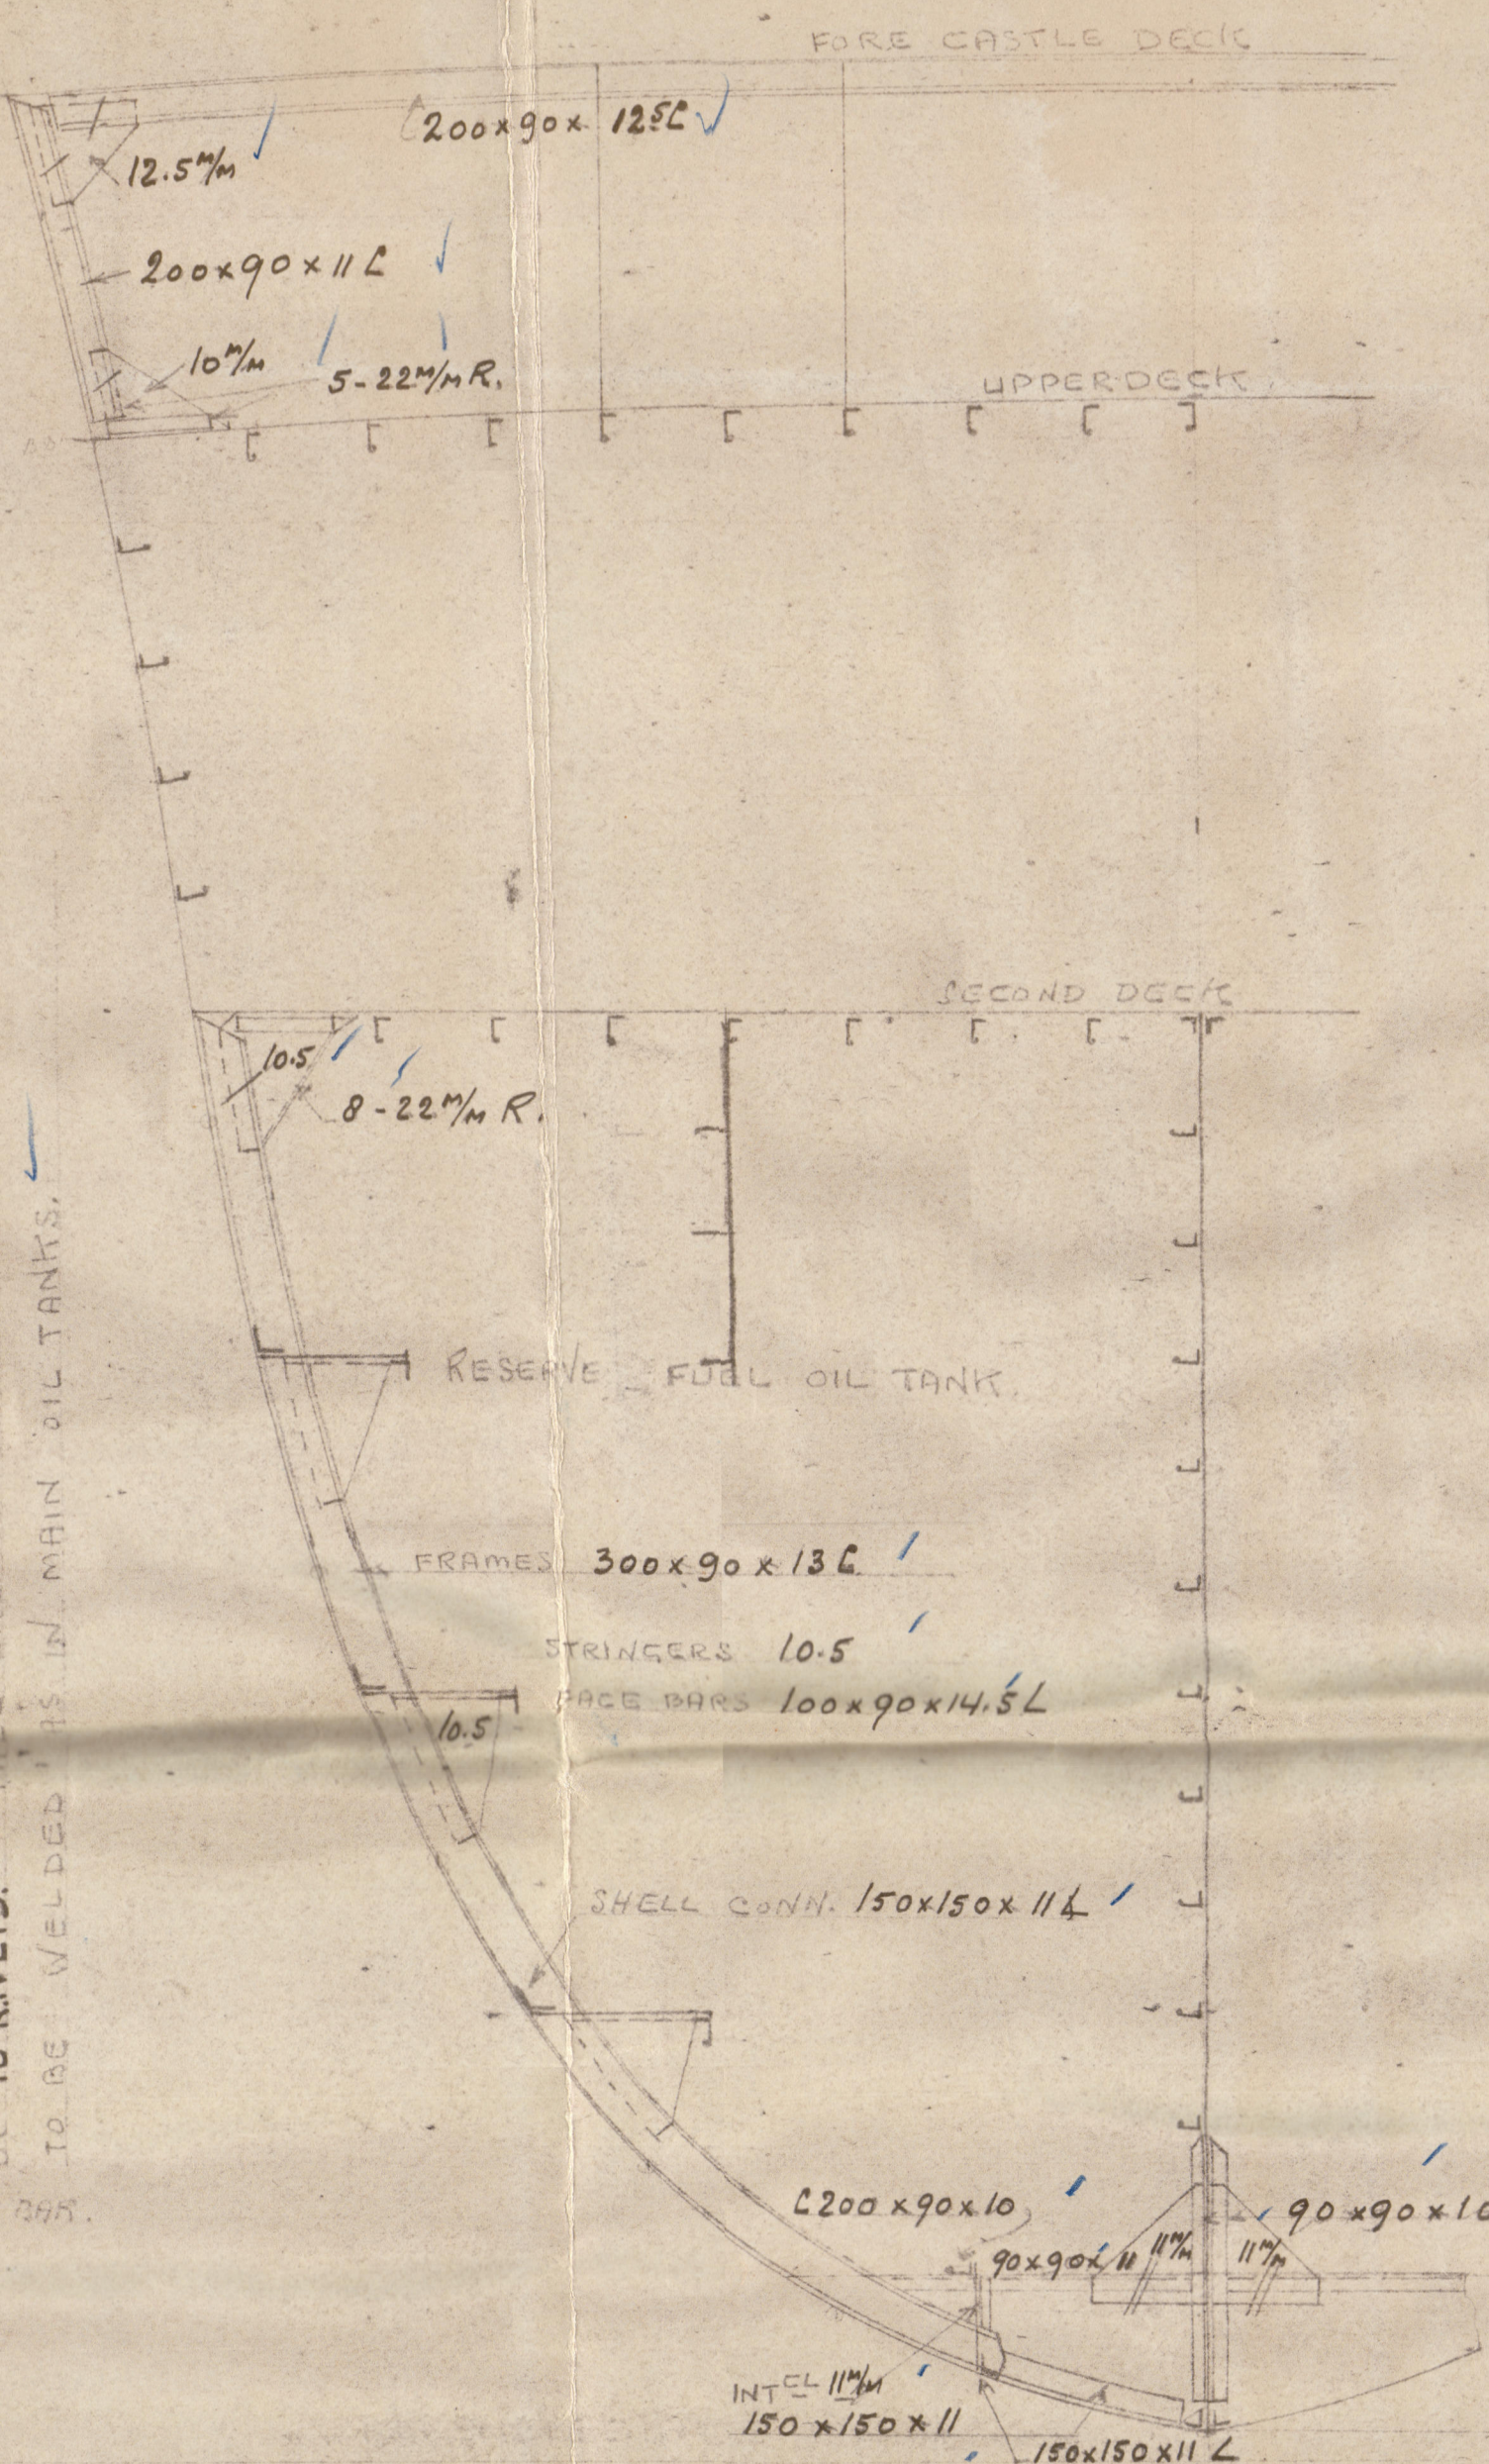


TRANSVERSE No 90

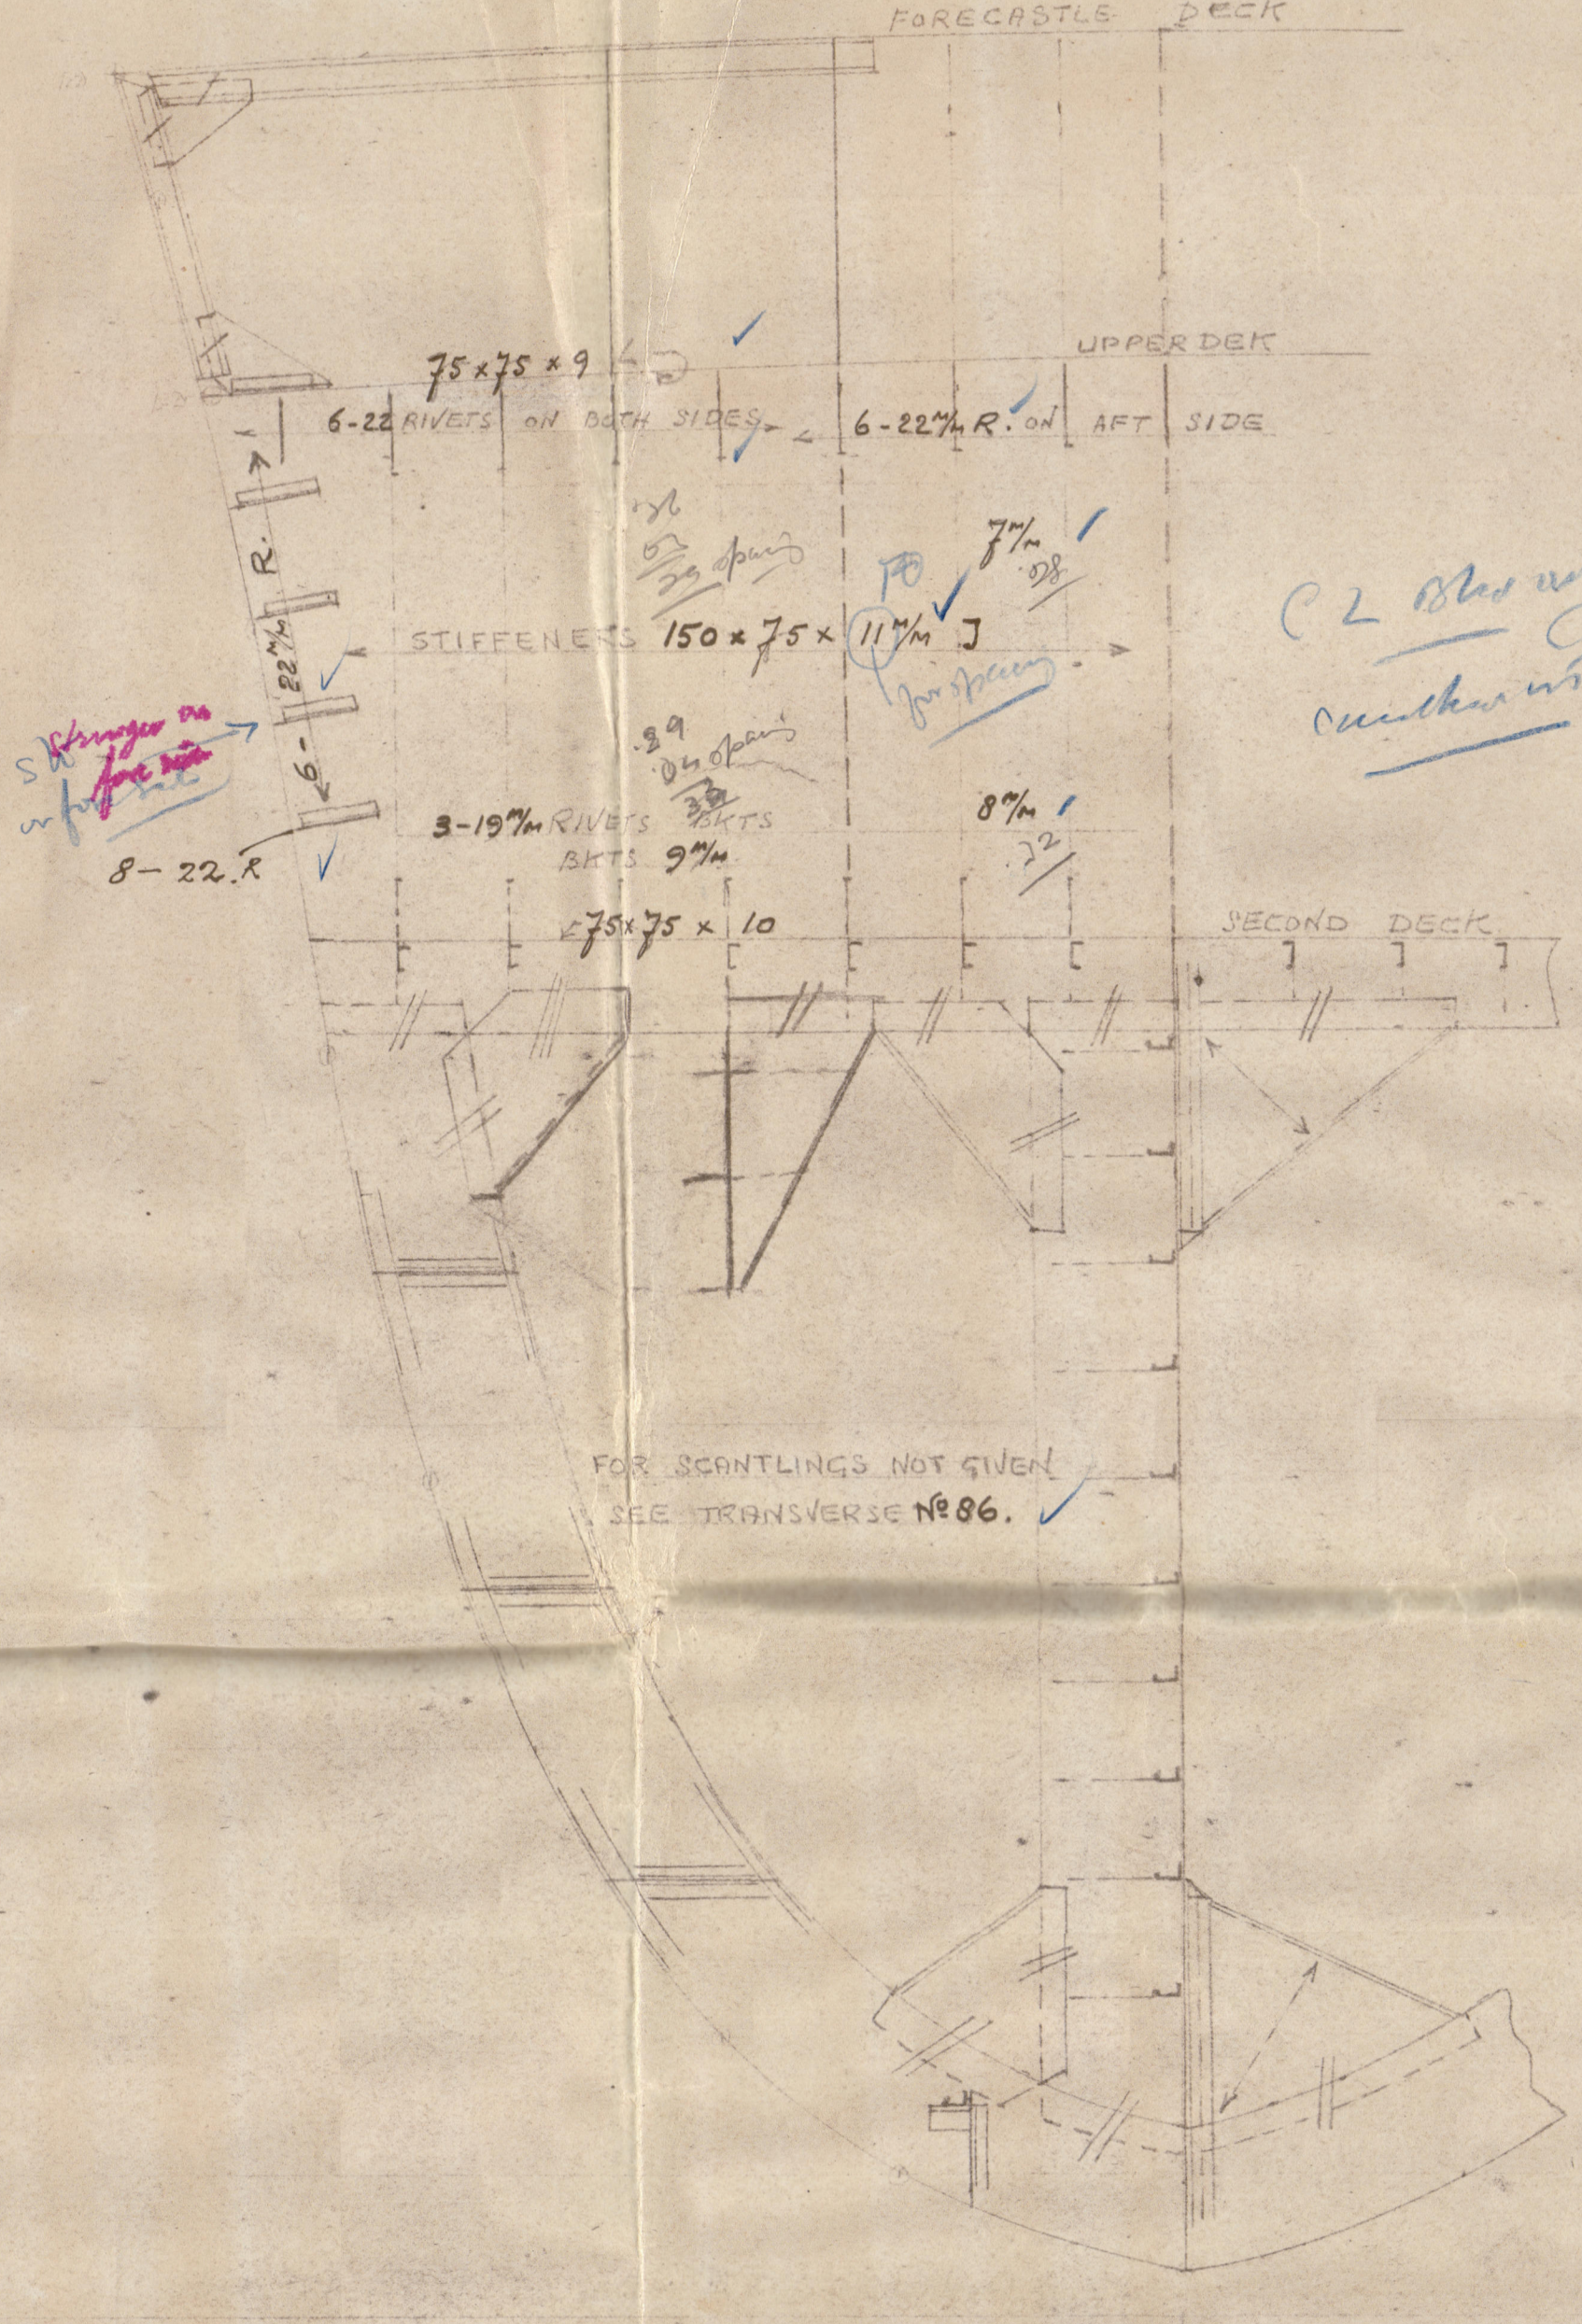

TRANSVERSE No 90



FORE PEAK BULKHEAD No 94

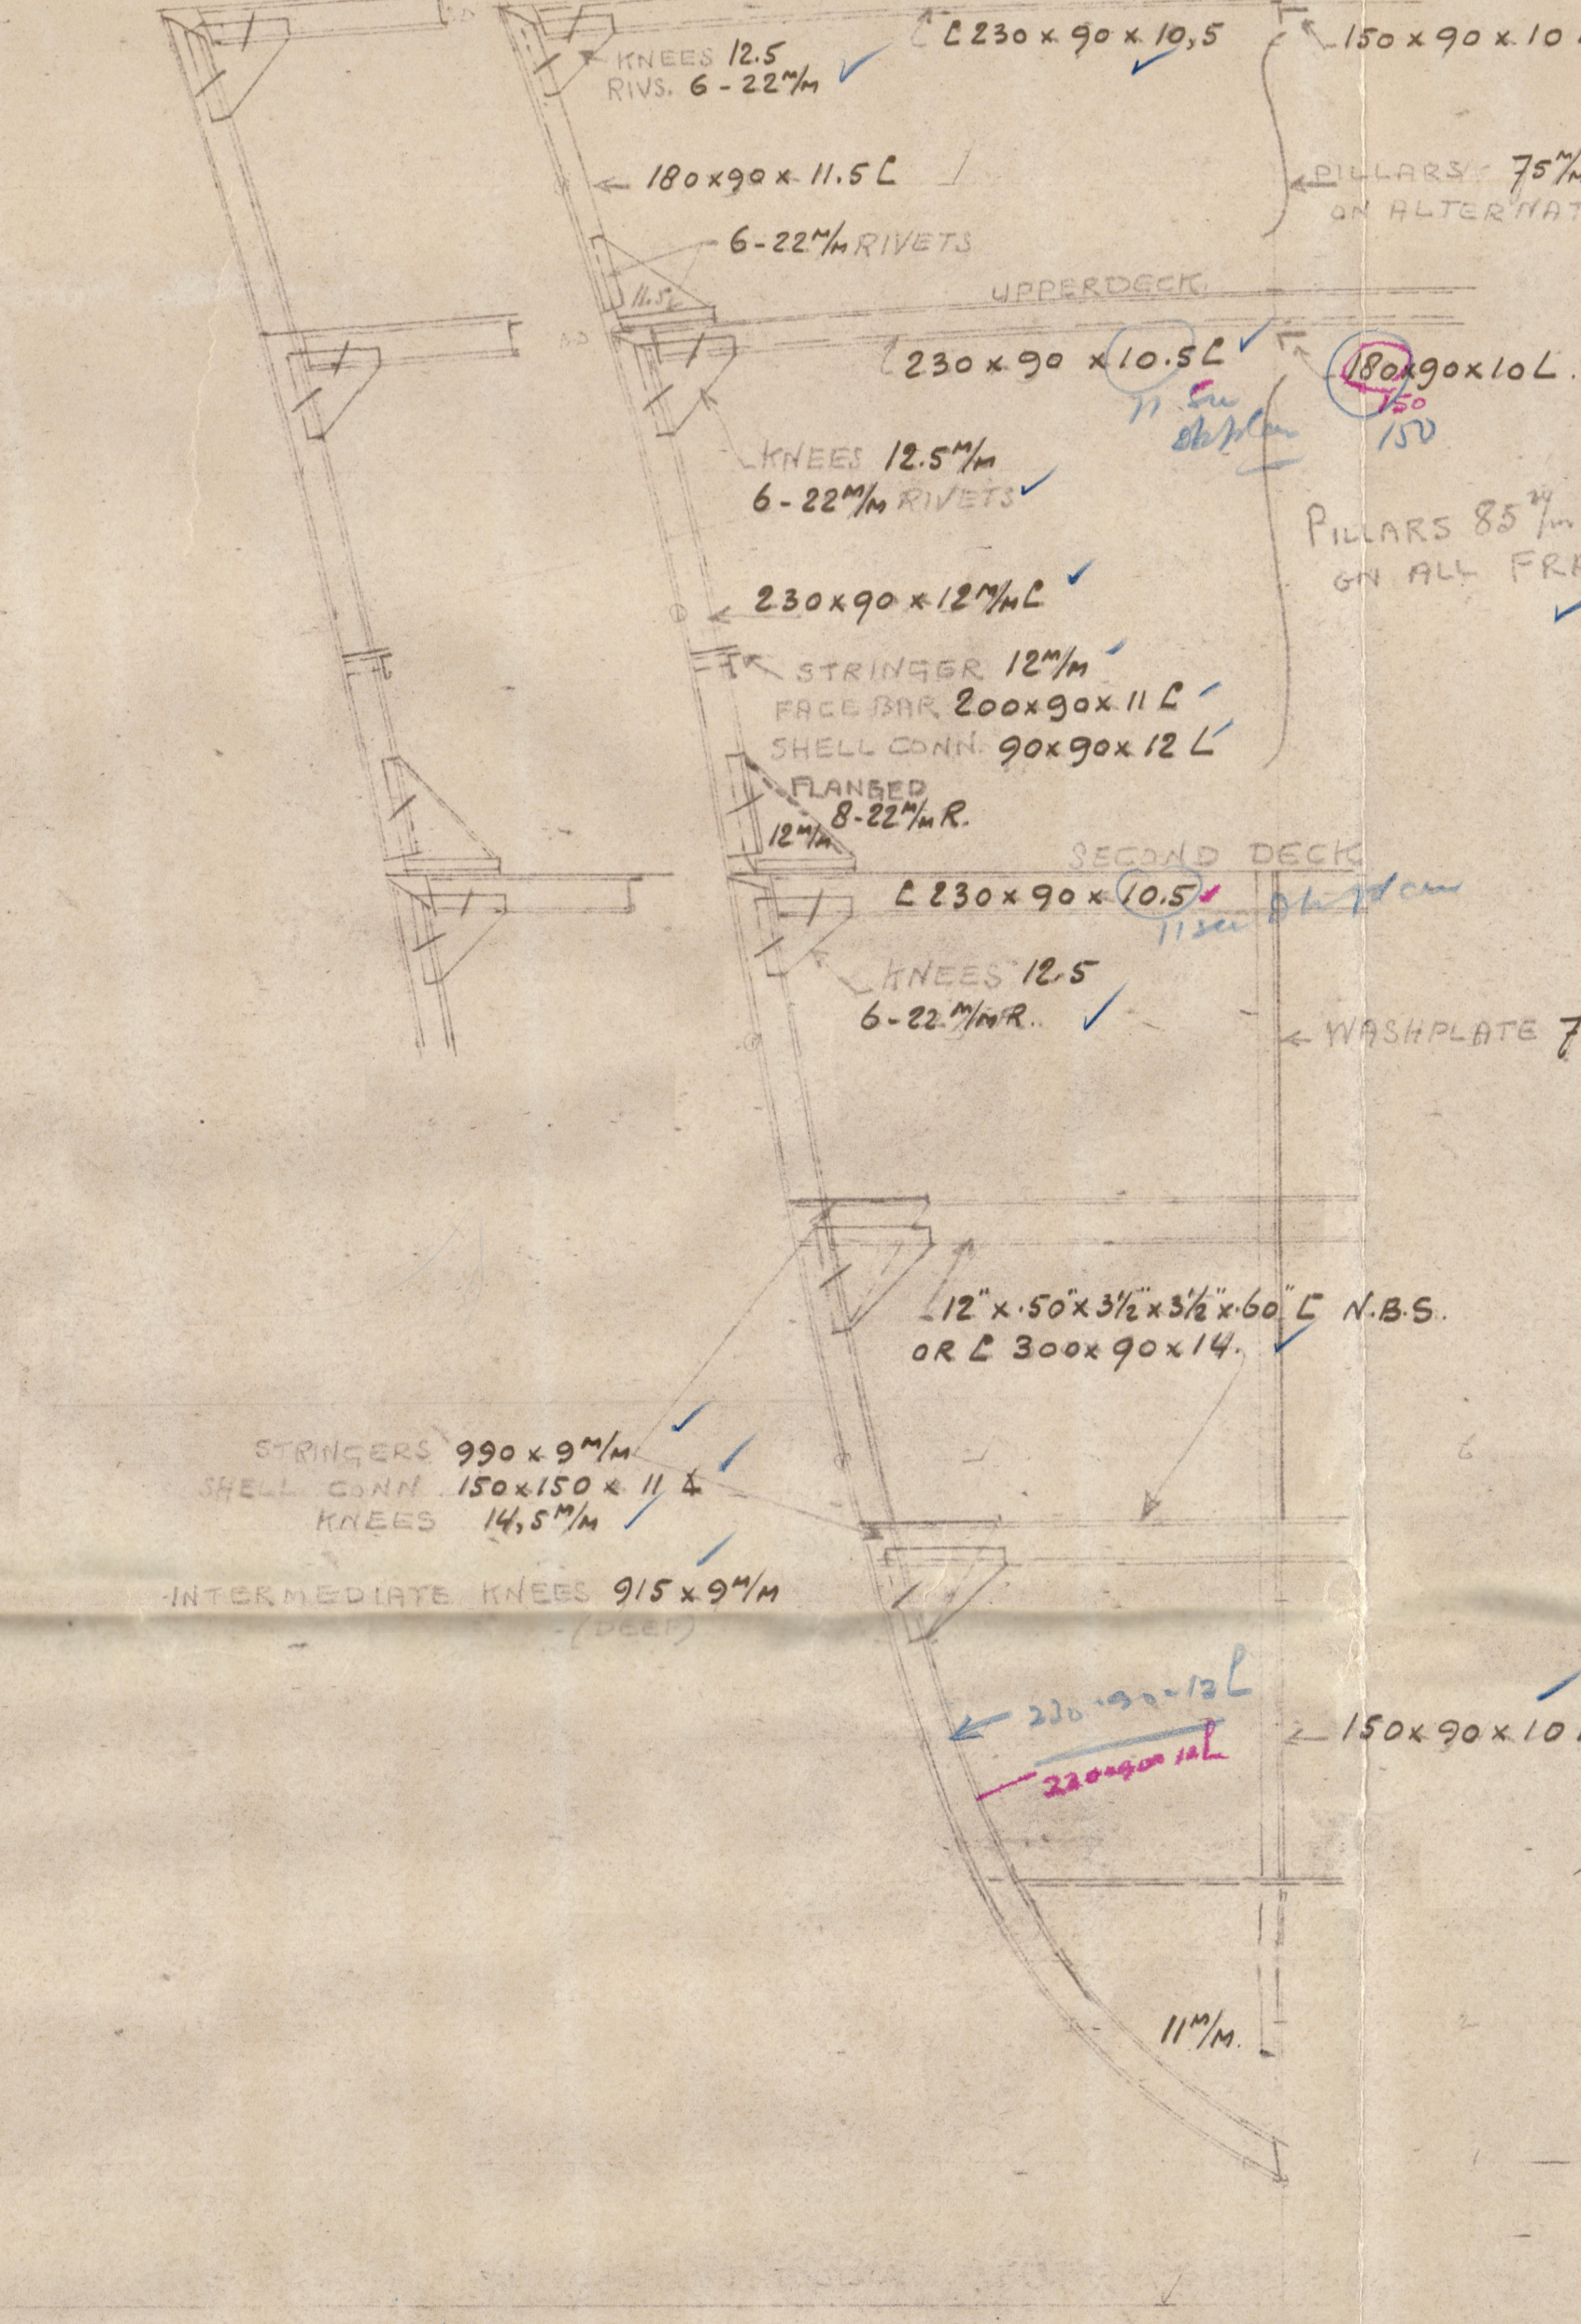


SECTION THROUGH FORE PEAK




SECTION THROUGH FORE PEAK




SECTION THROUGH FORE PEAK

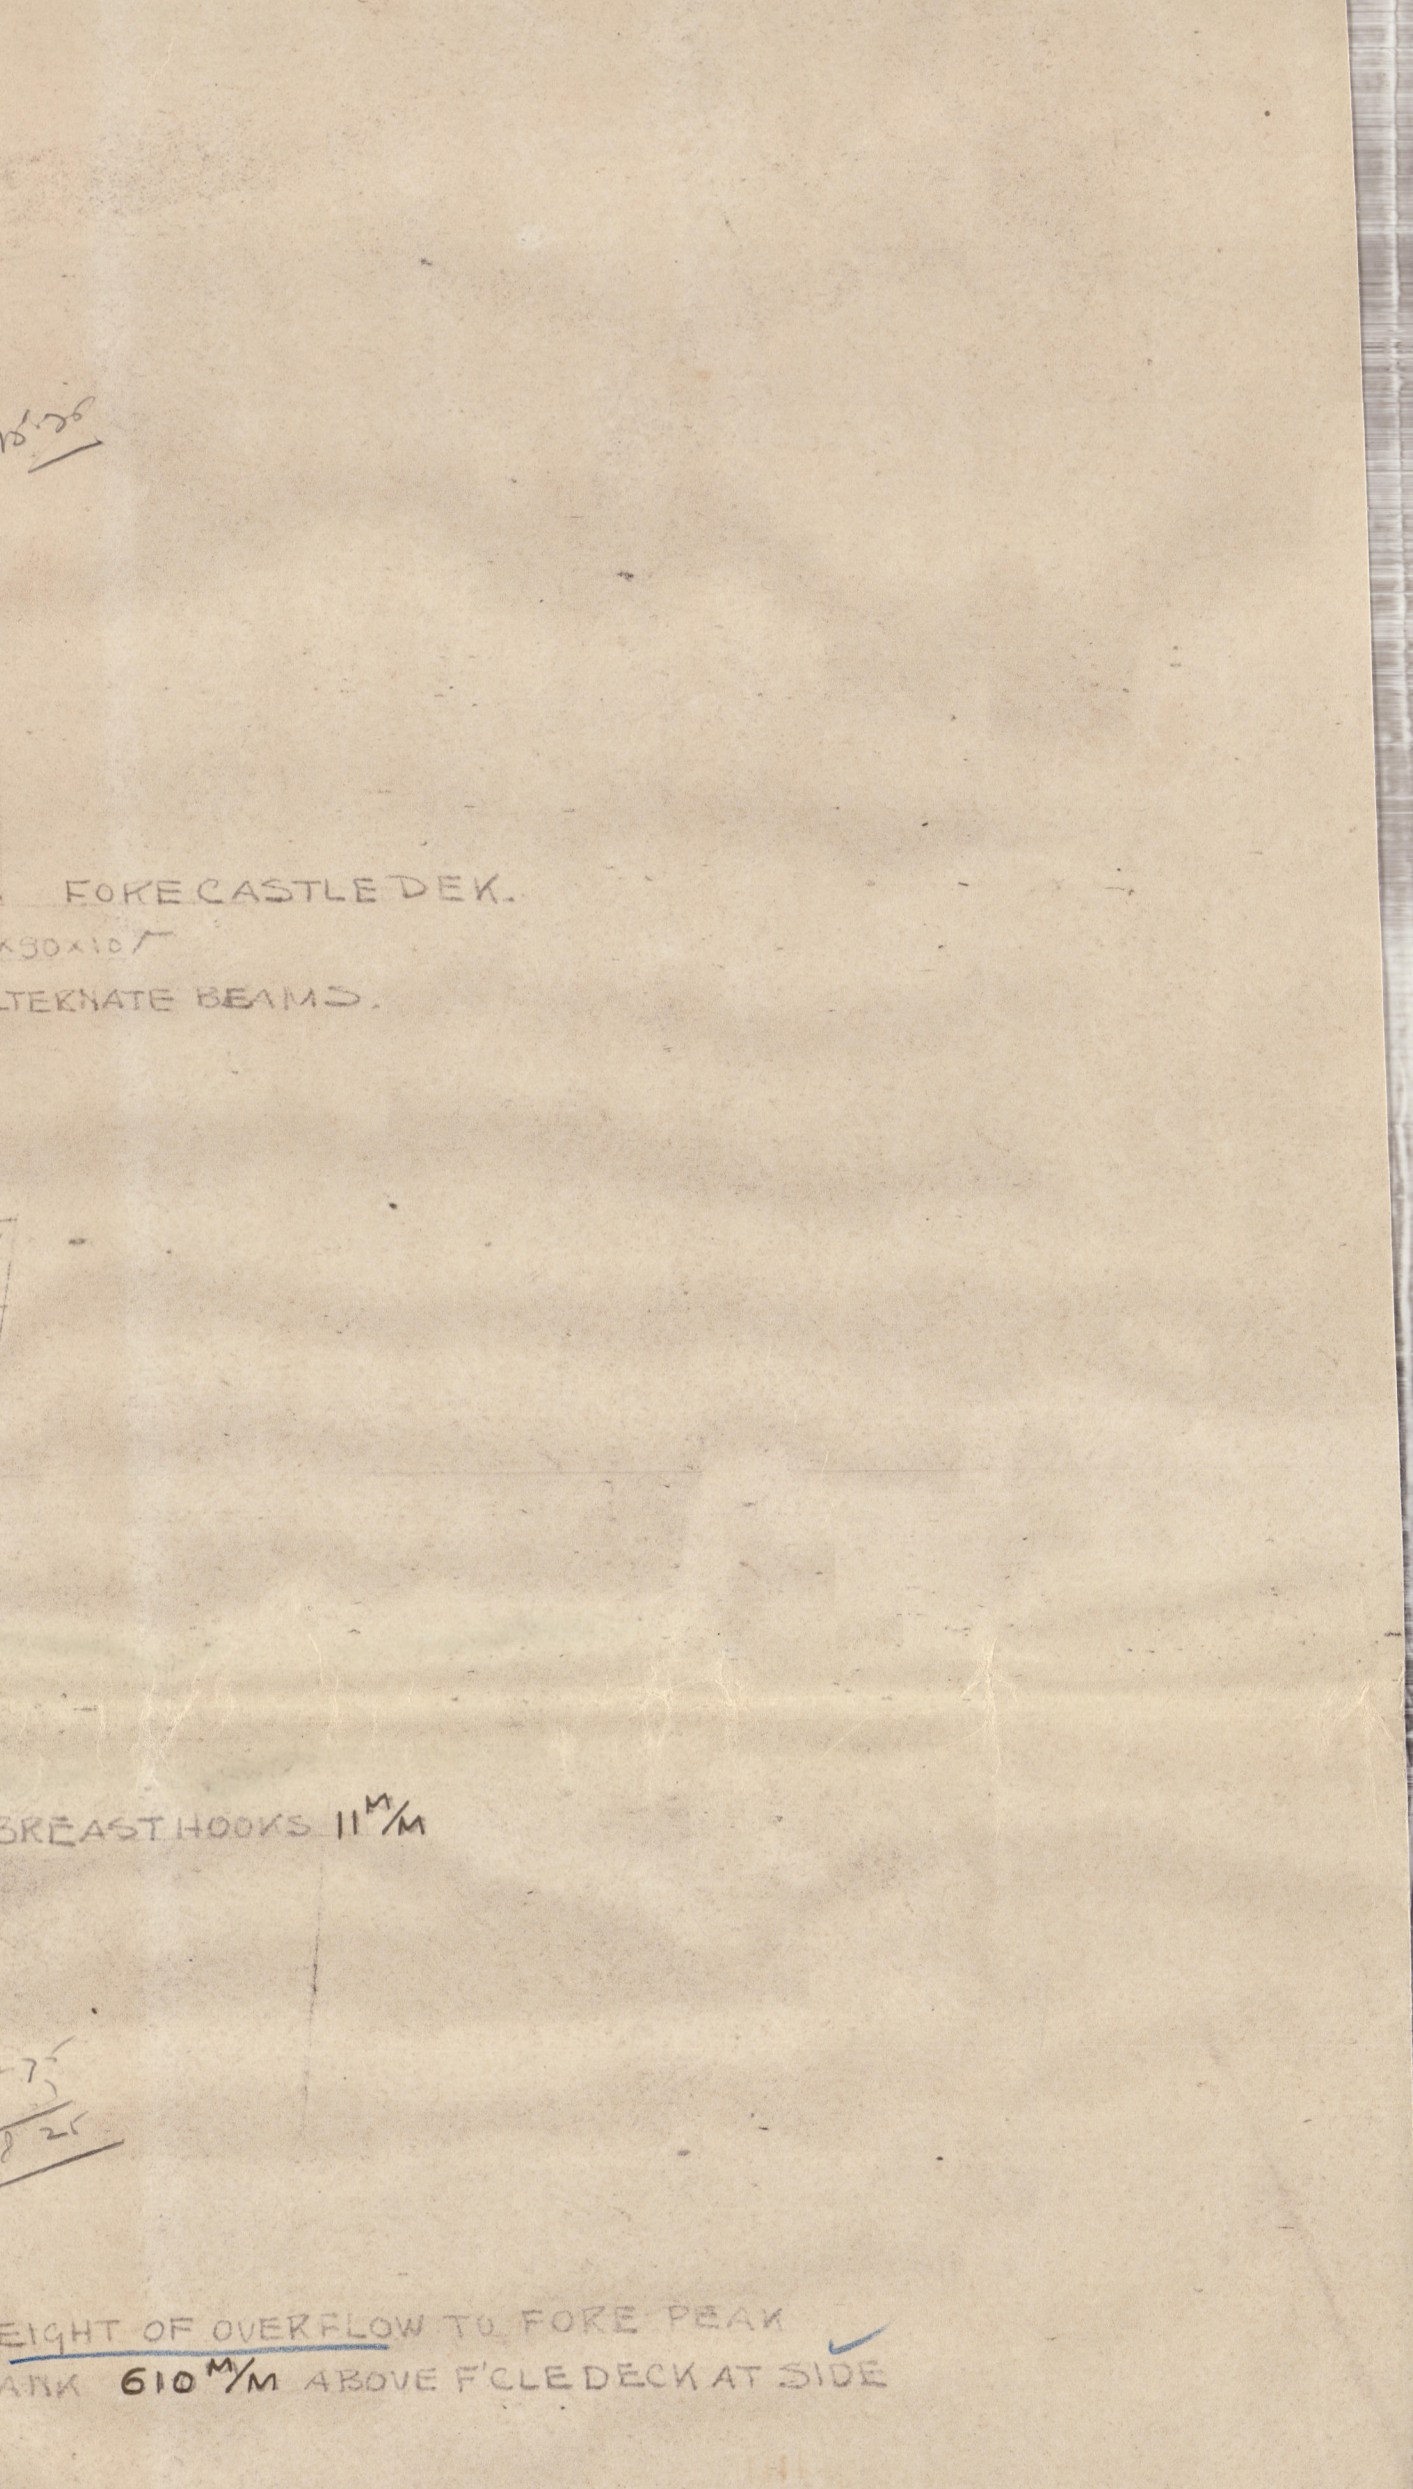

SECTION THROUGH FORE PEAK

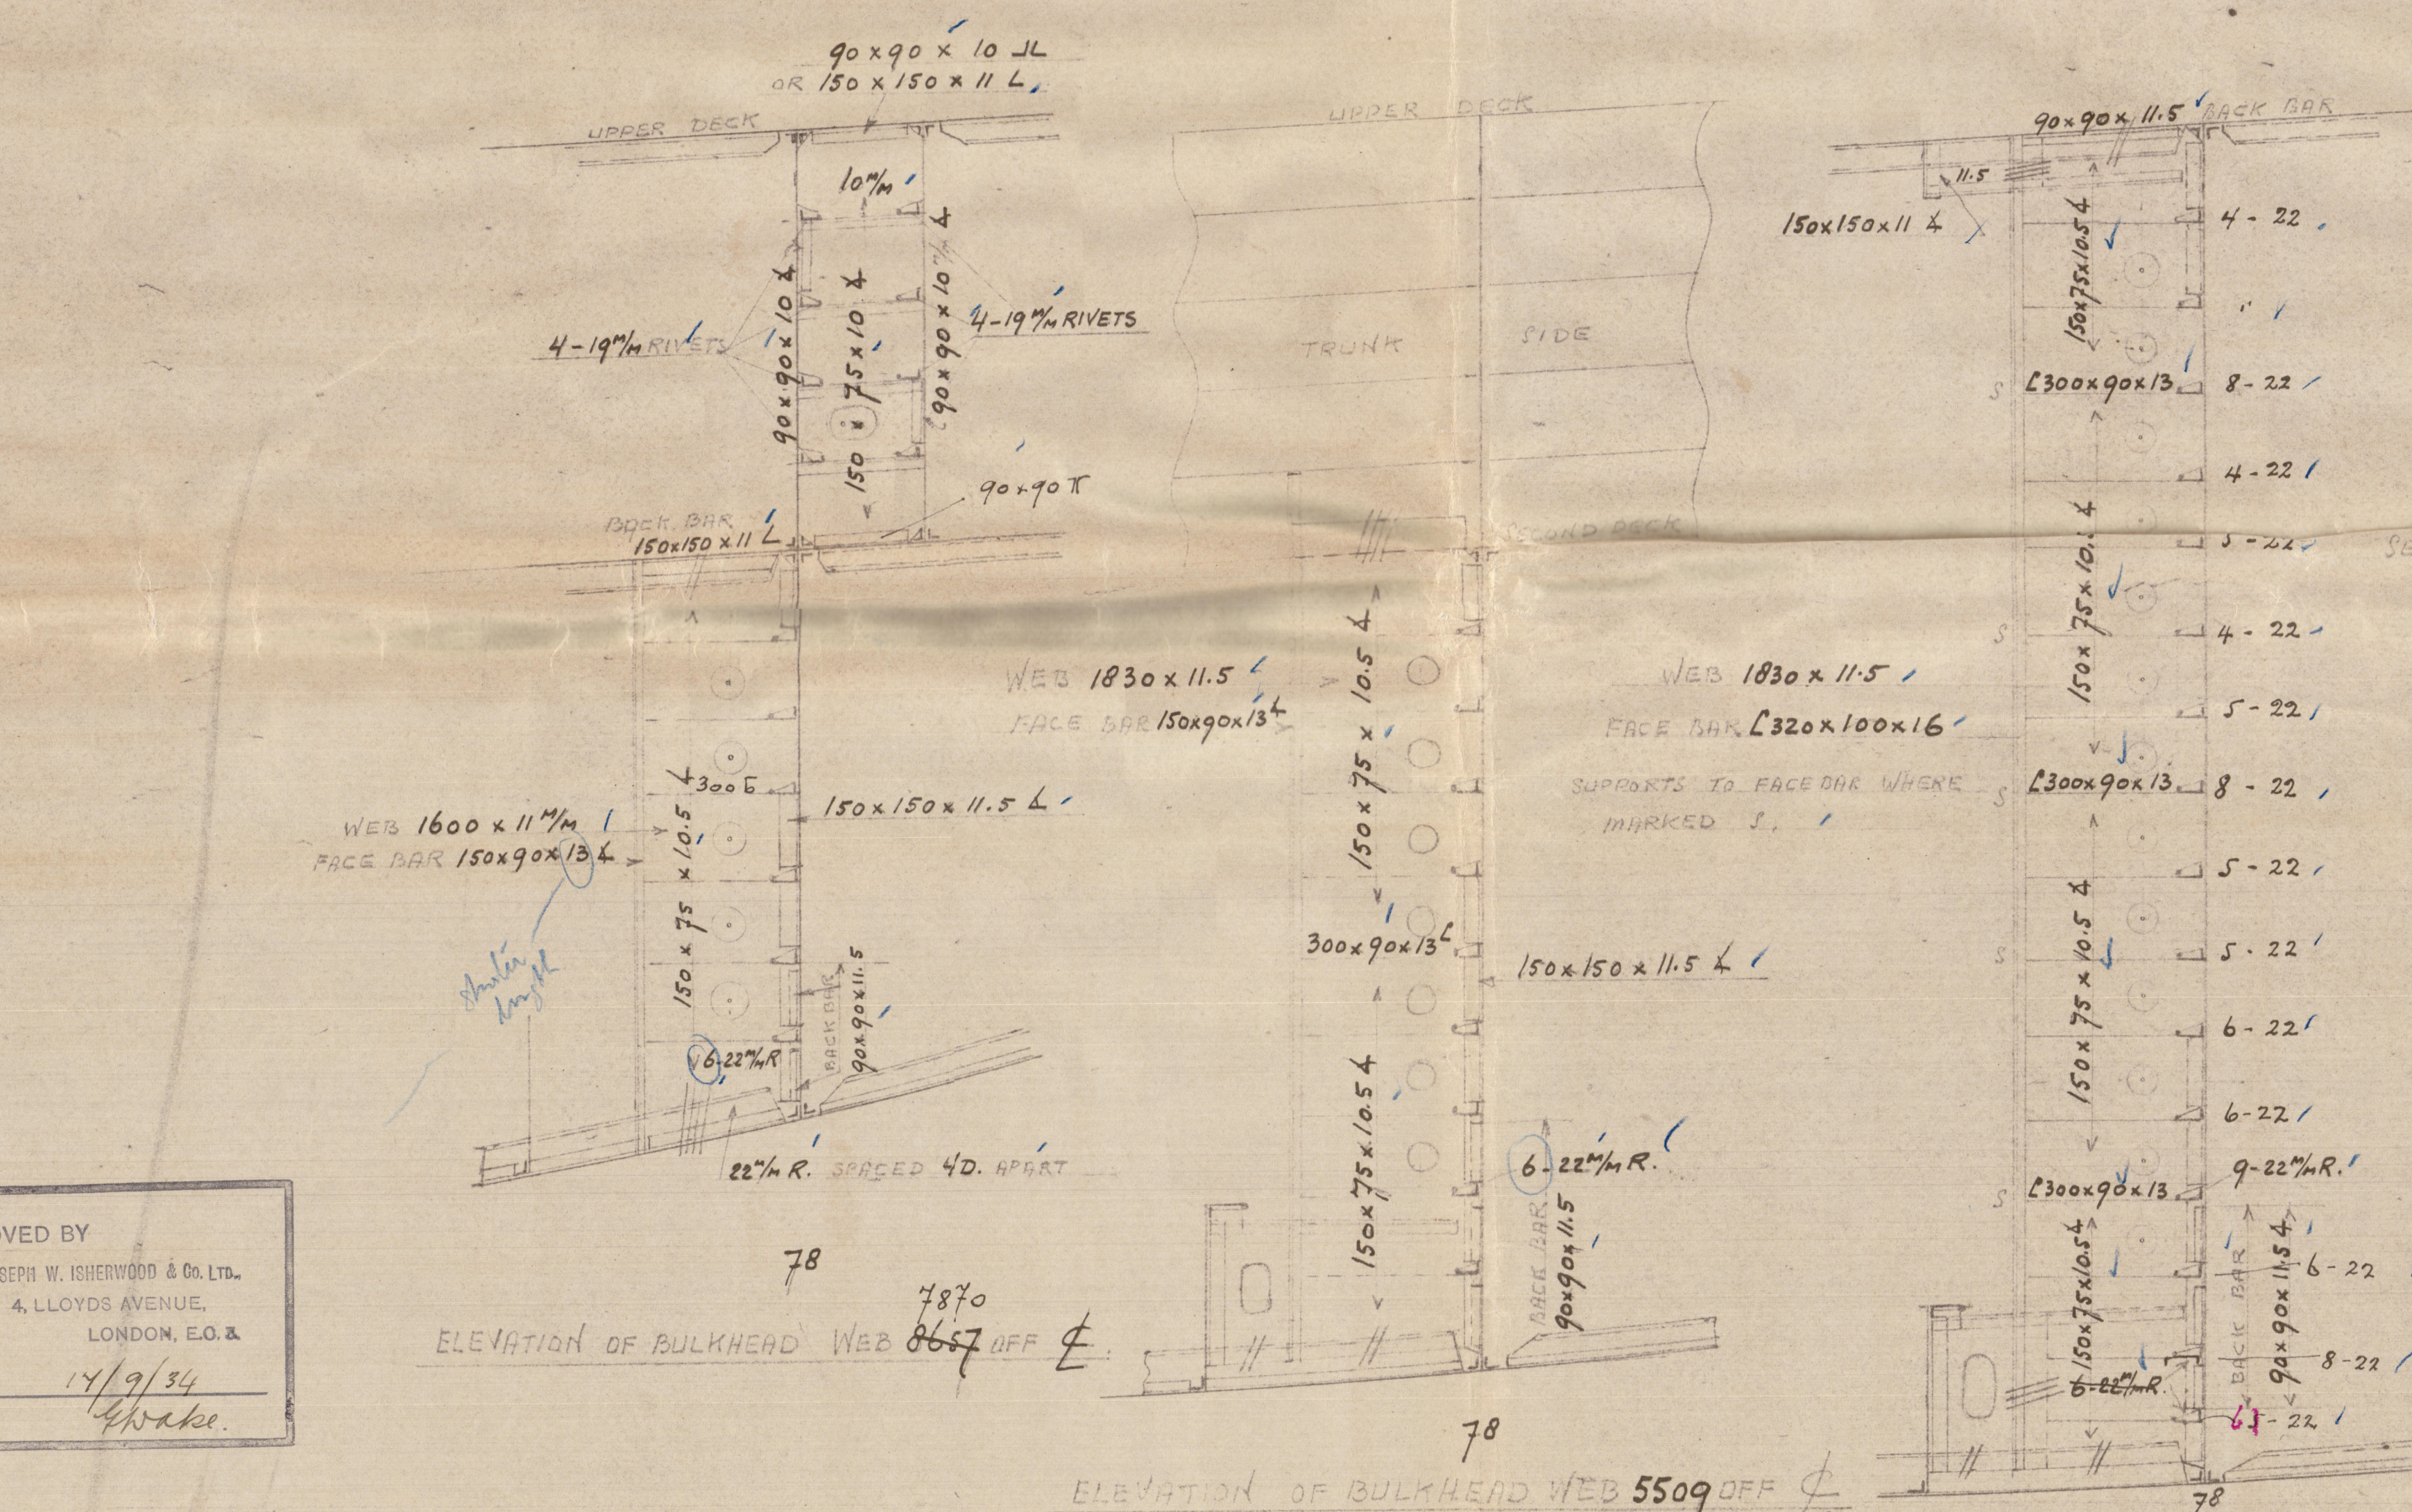

ELEVATION OF BULKHEAD No 667

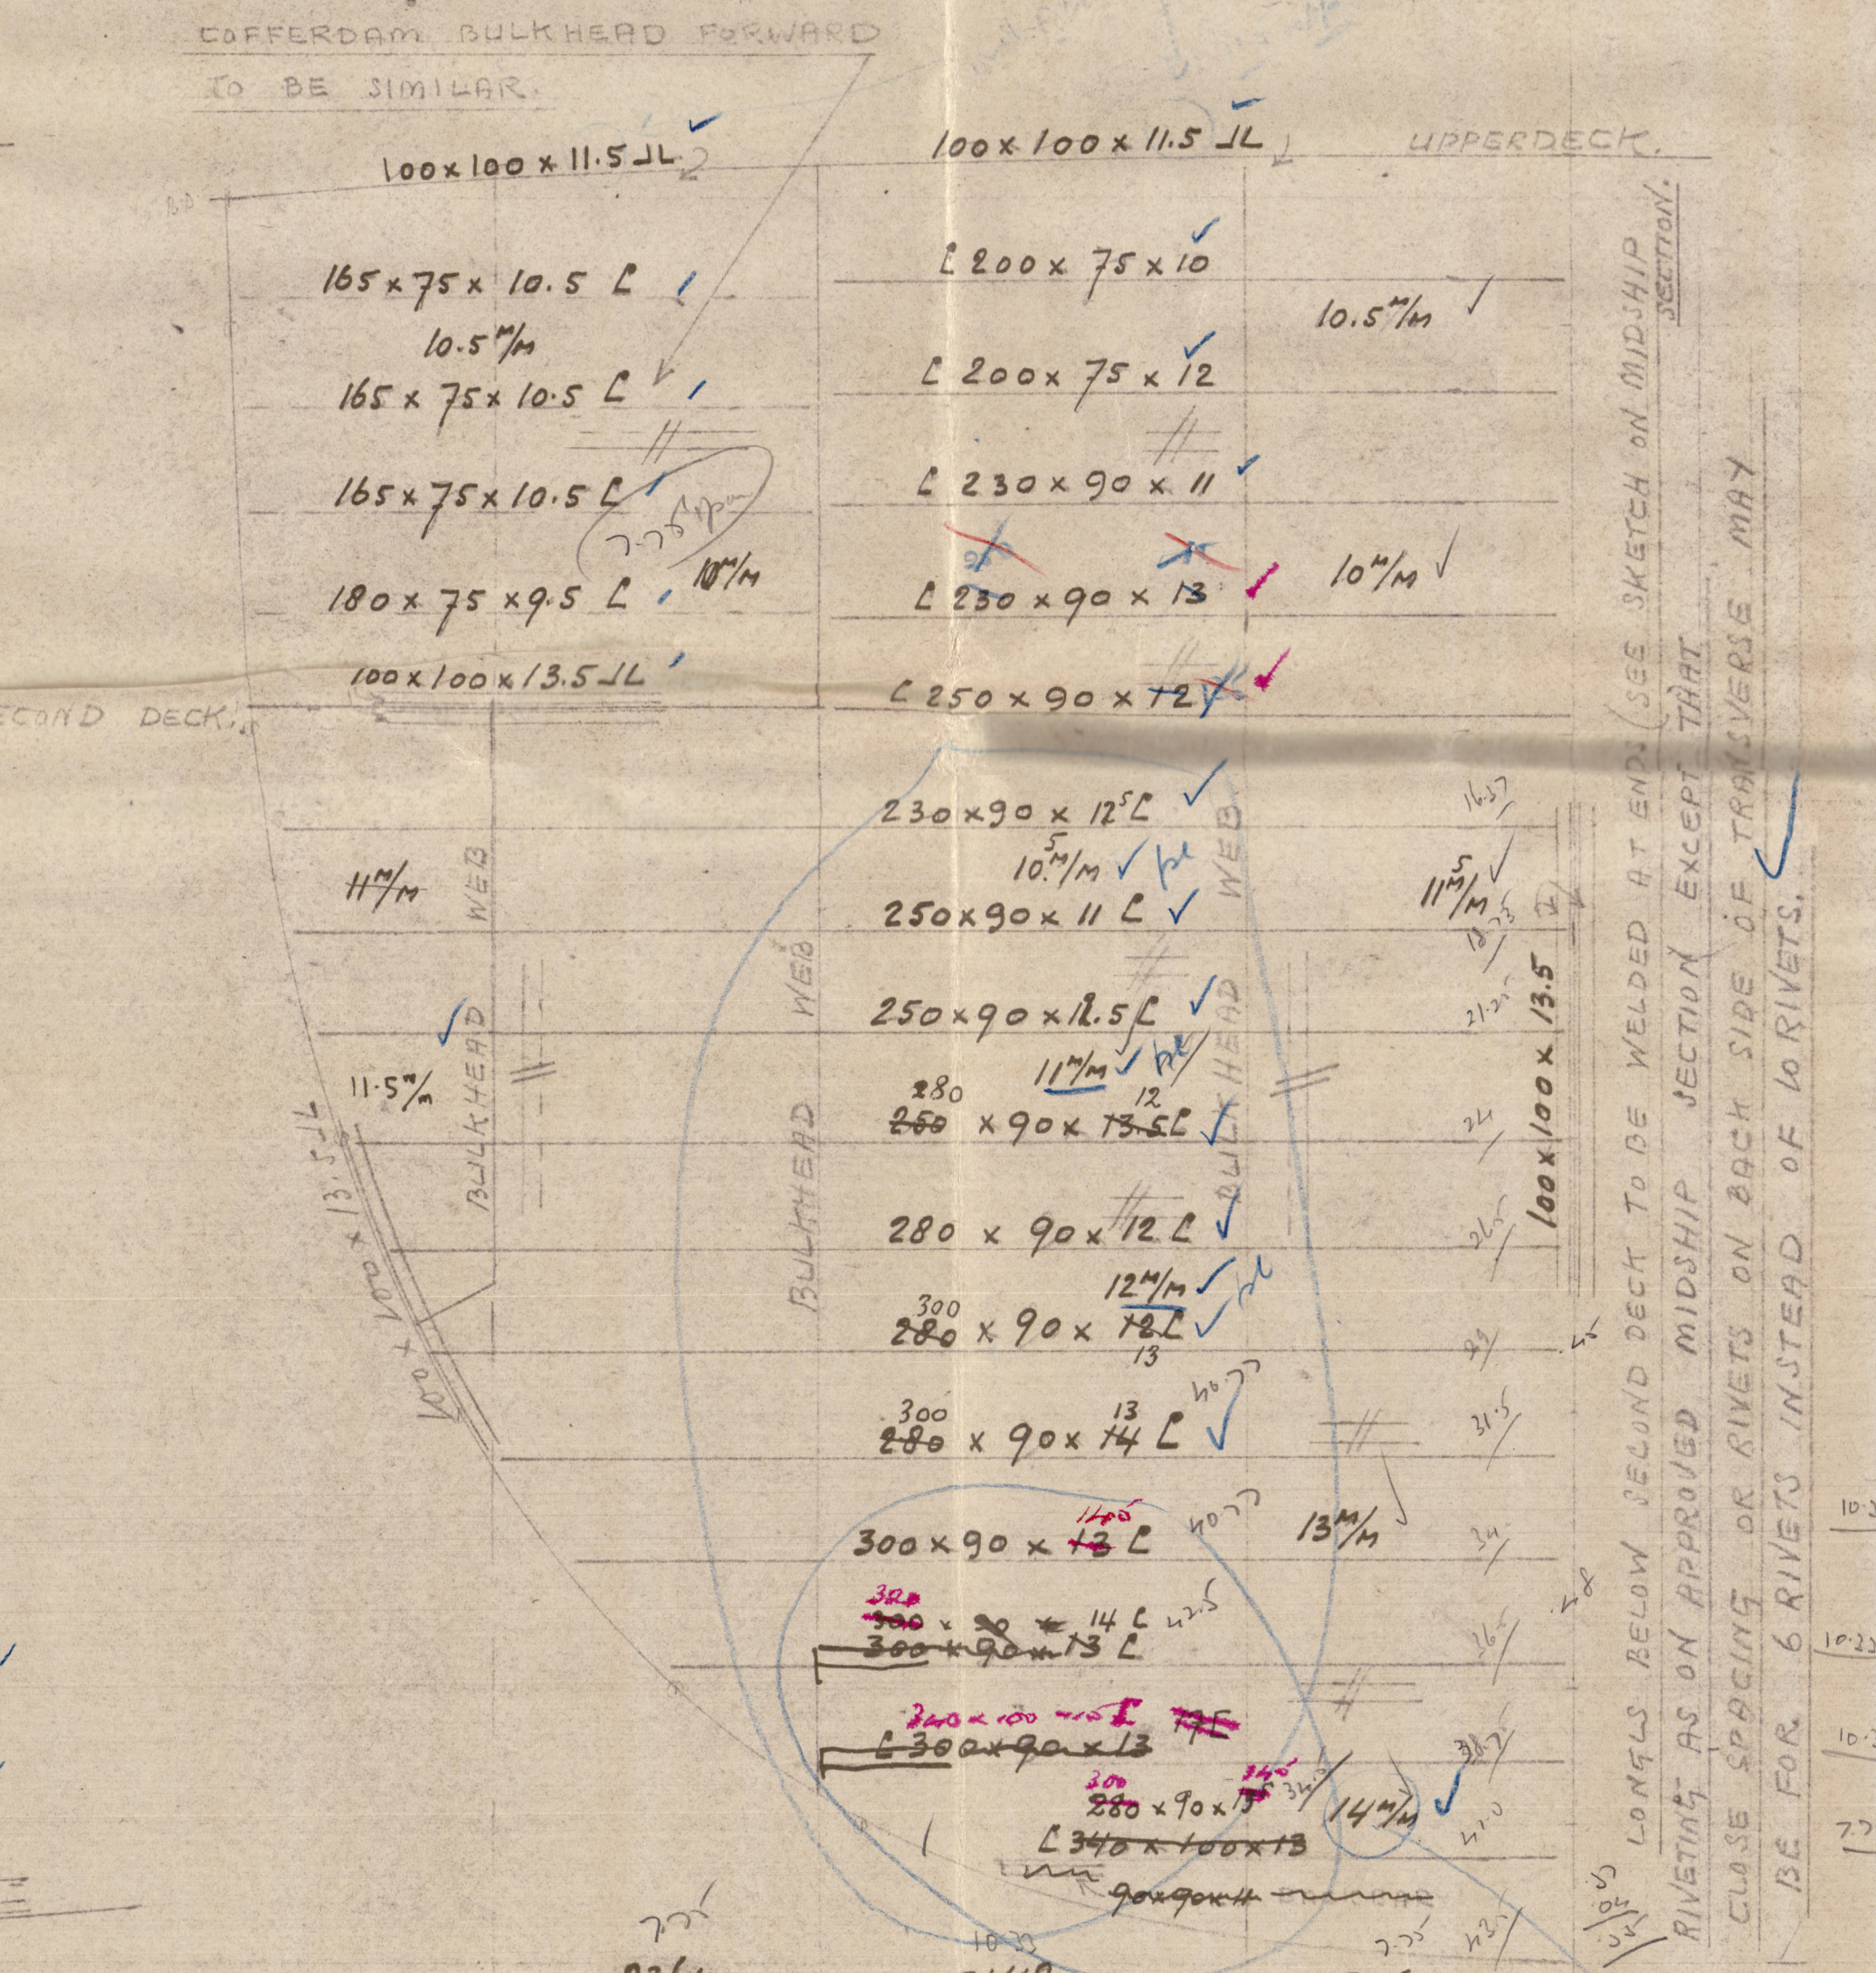

ELEVATION OF BULKHEAD No 559




ELEVATION OF BULKHEAD No 2361




TRANSVERSE No 78




TRANSVERSE No 79

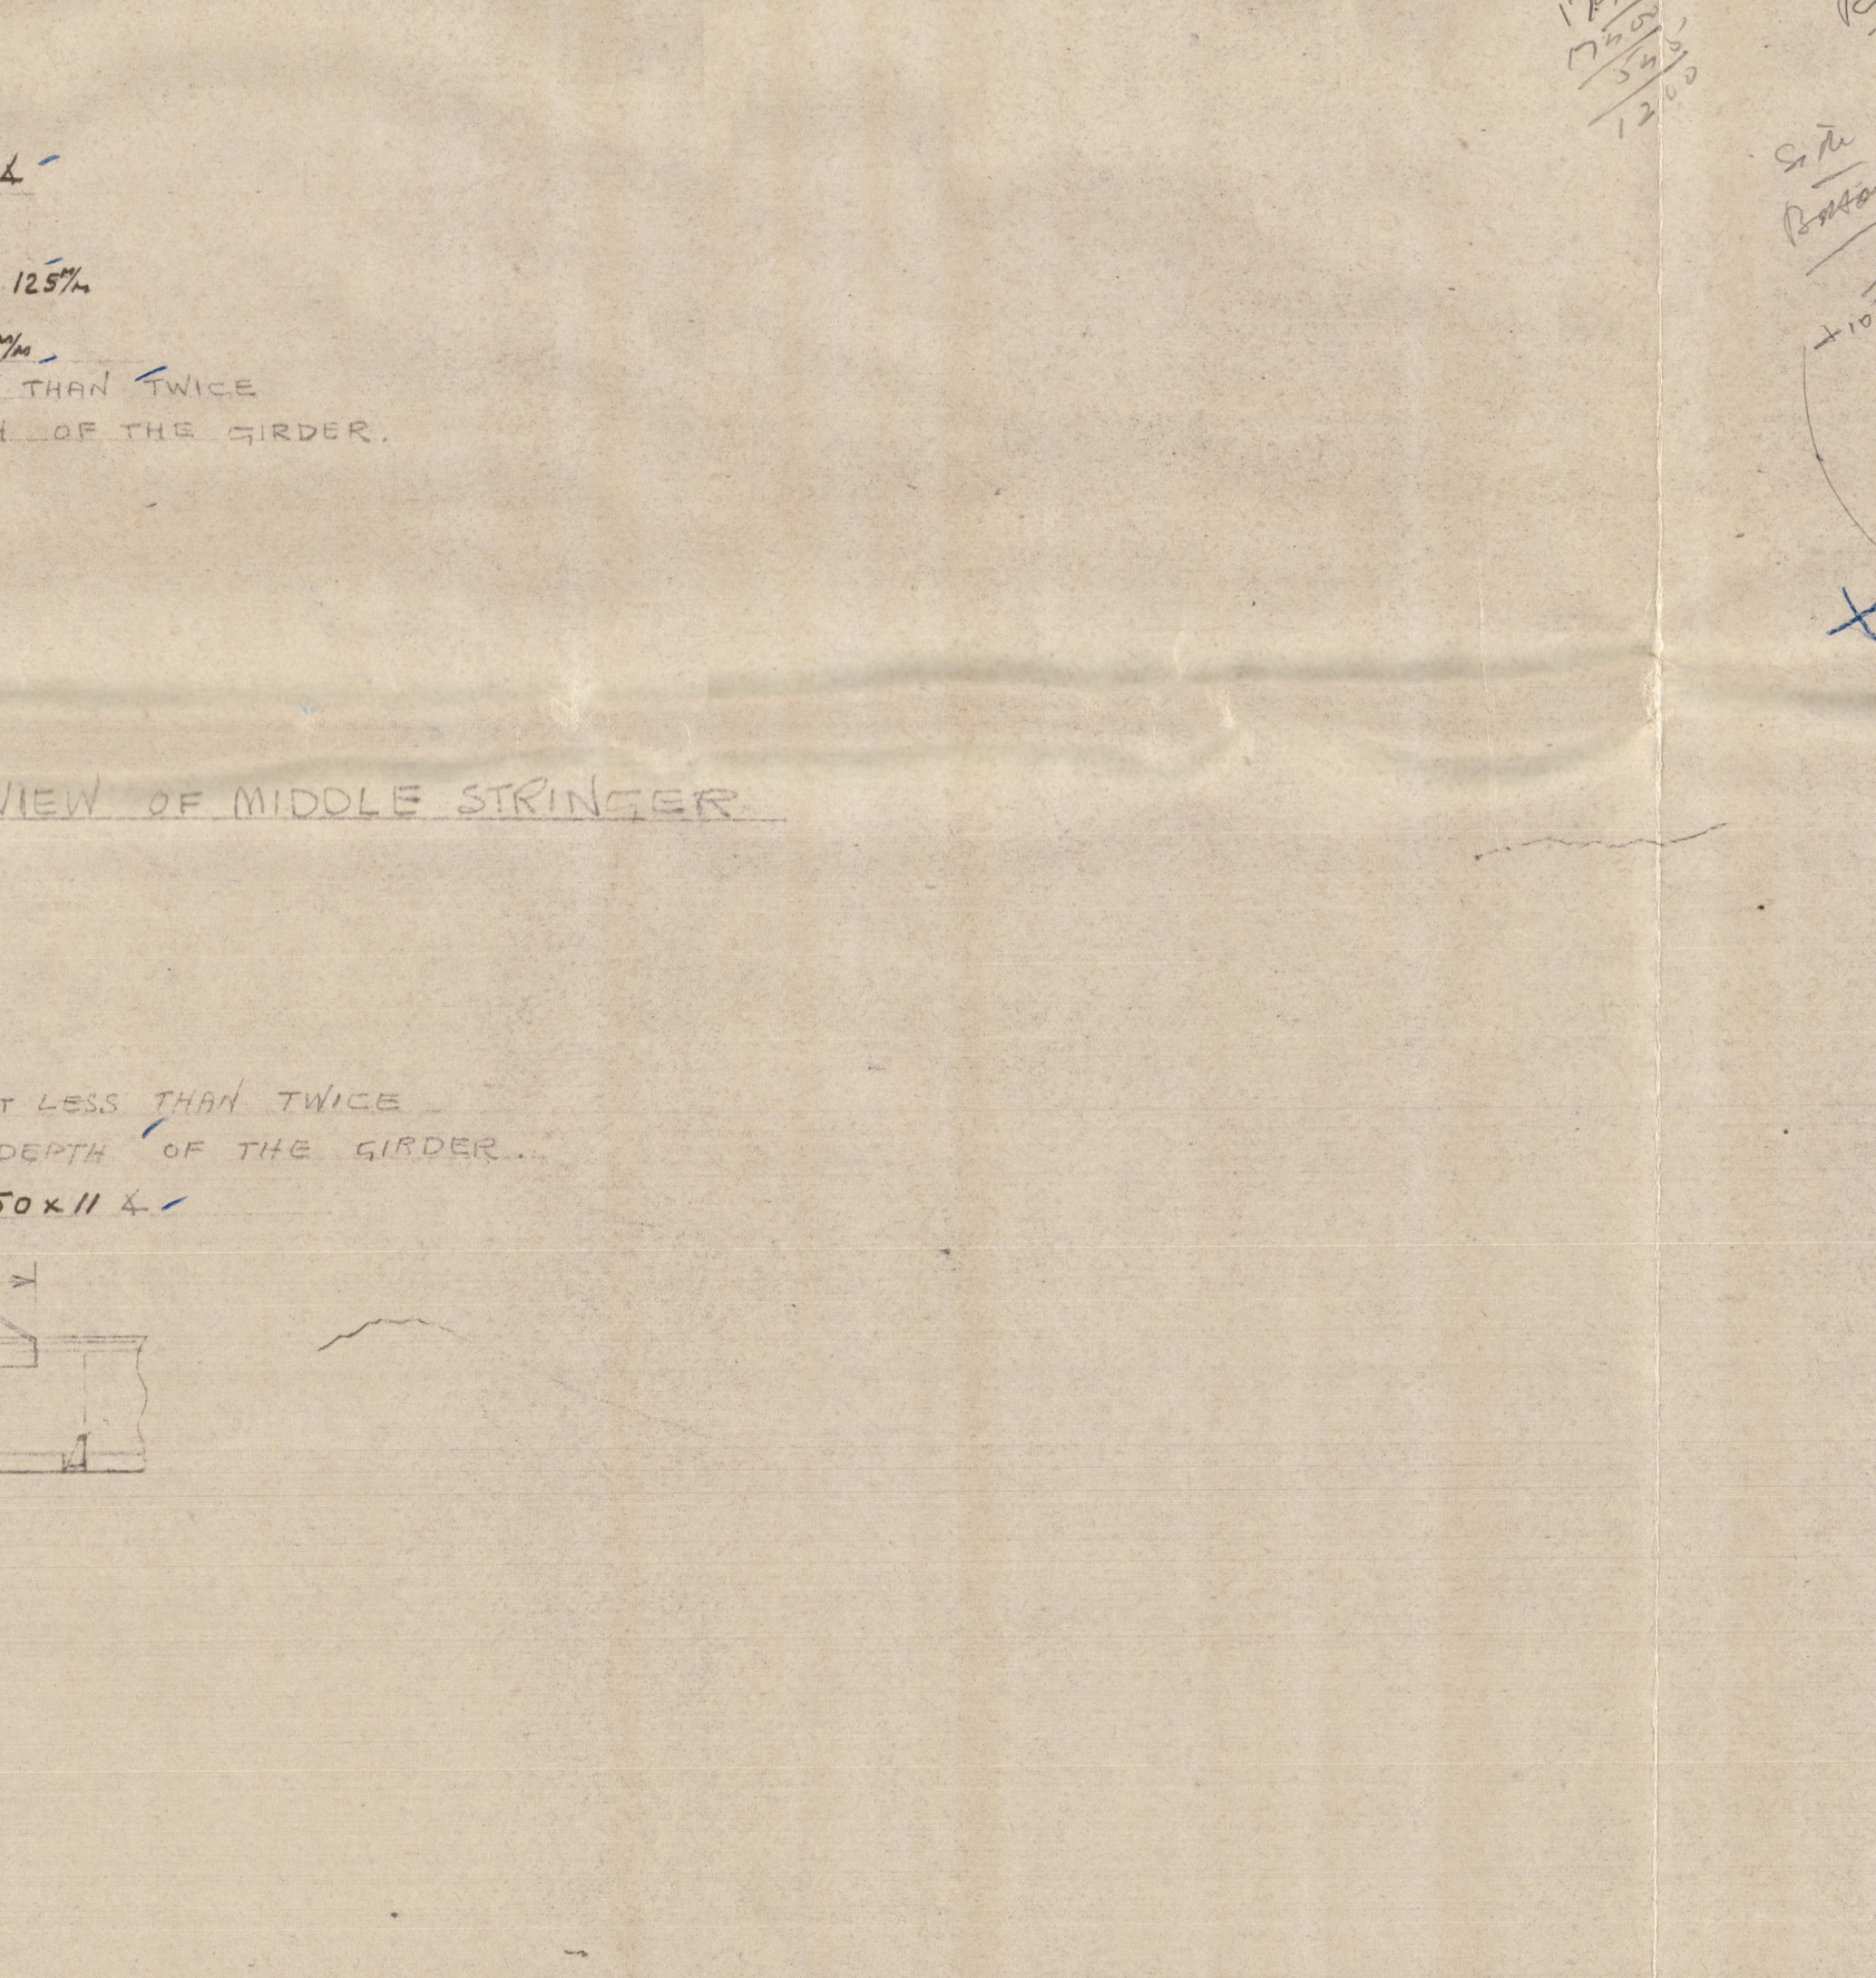


TRANSVERSE No 80

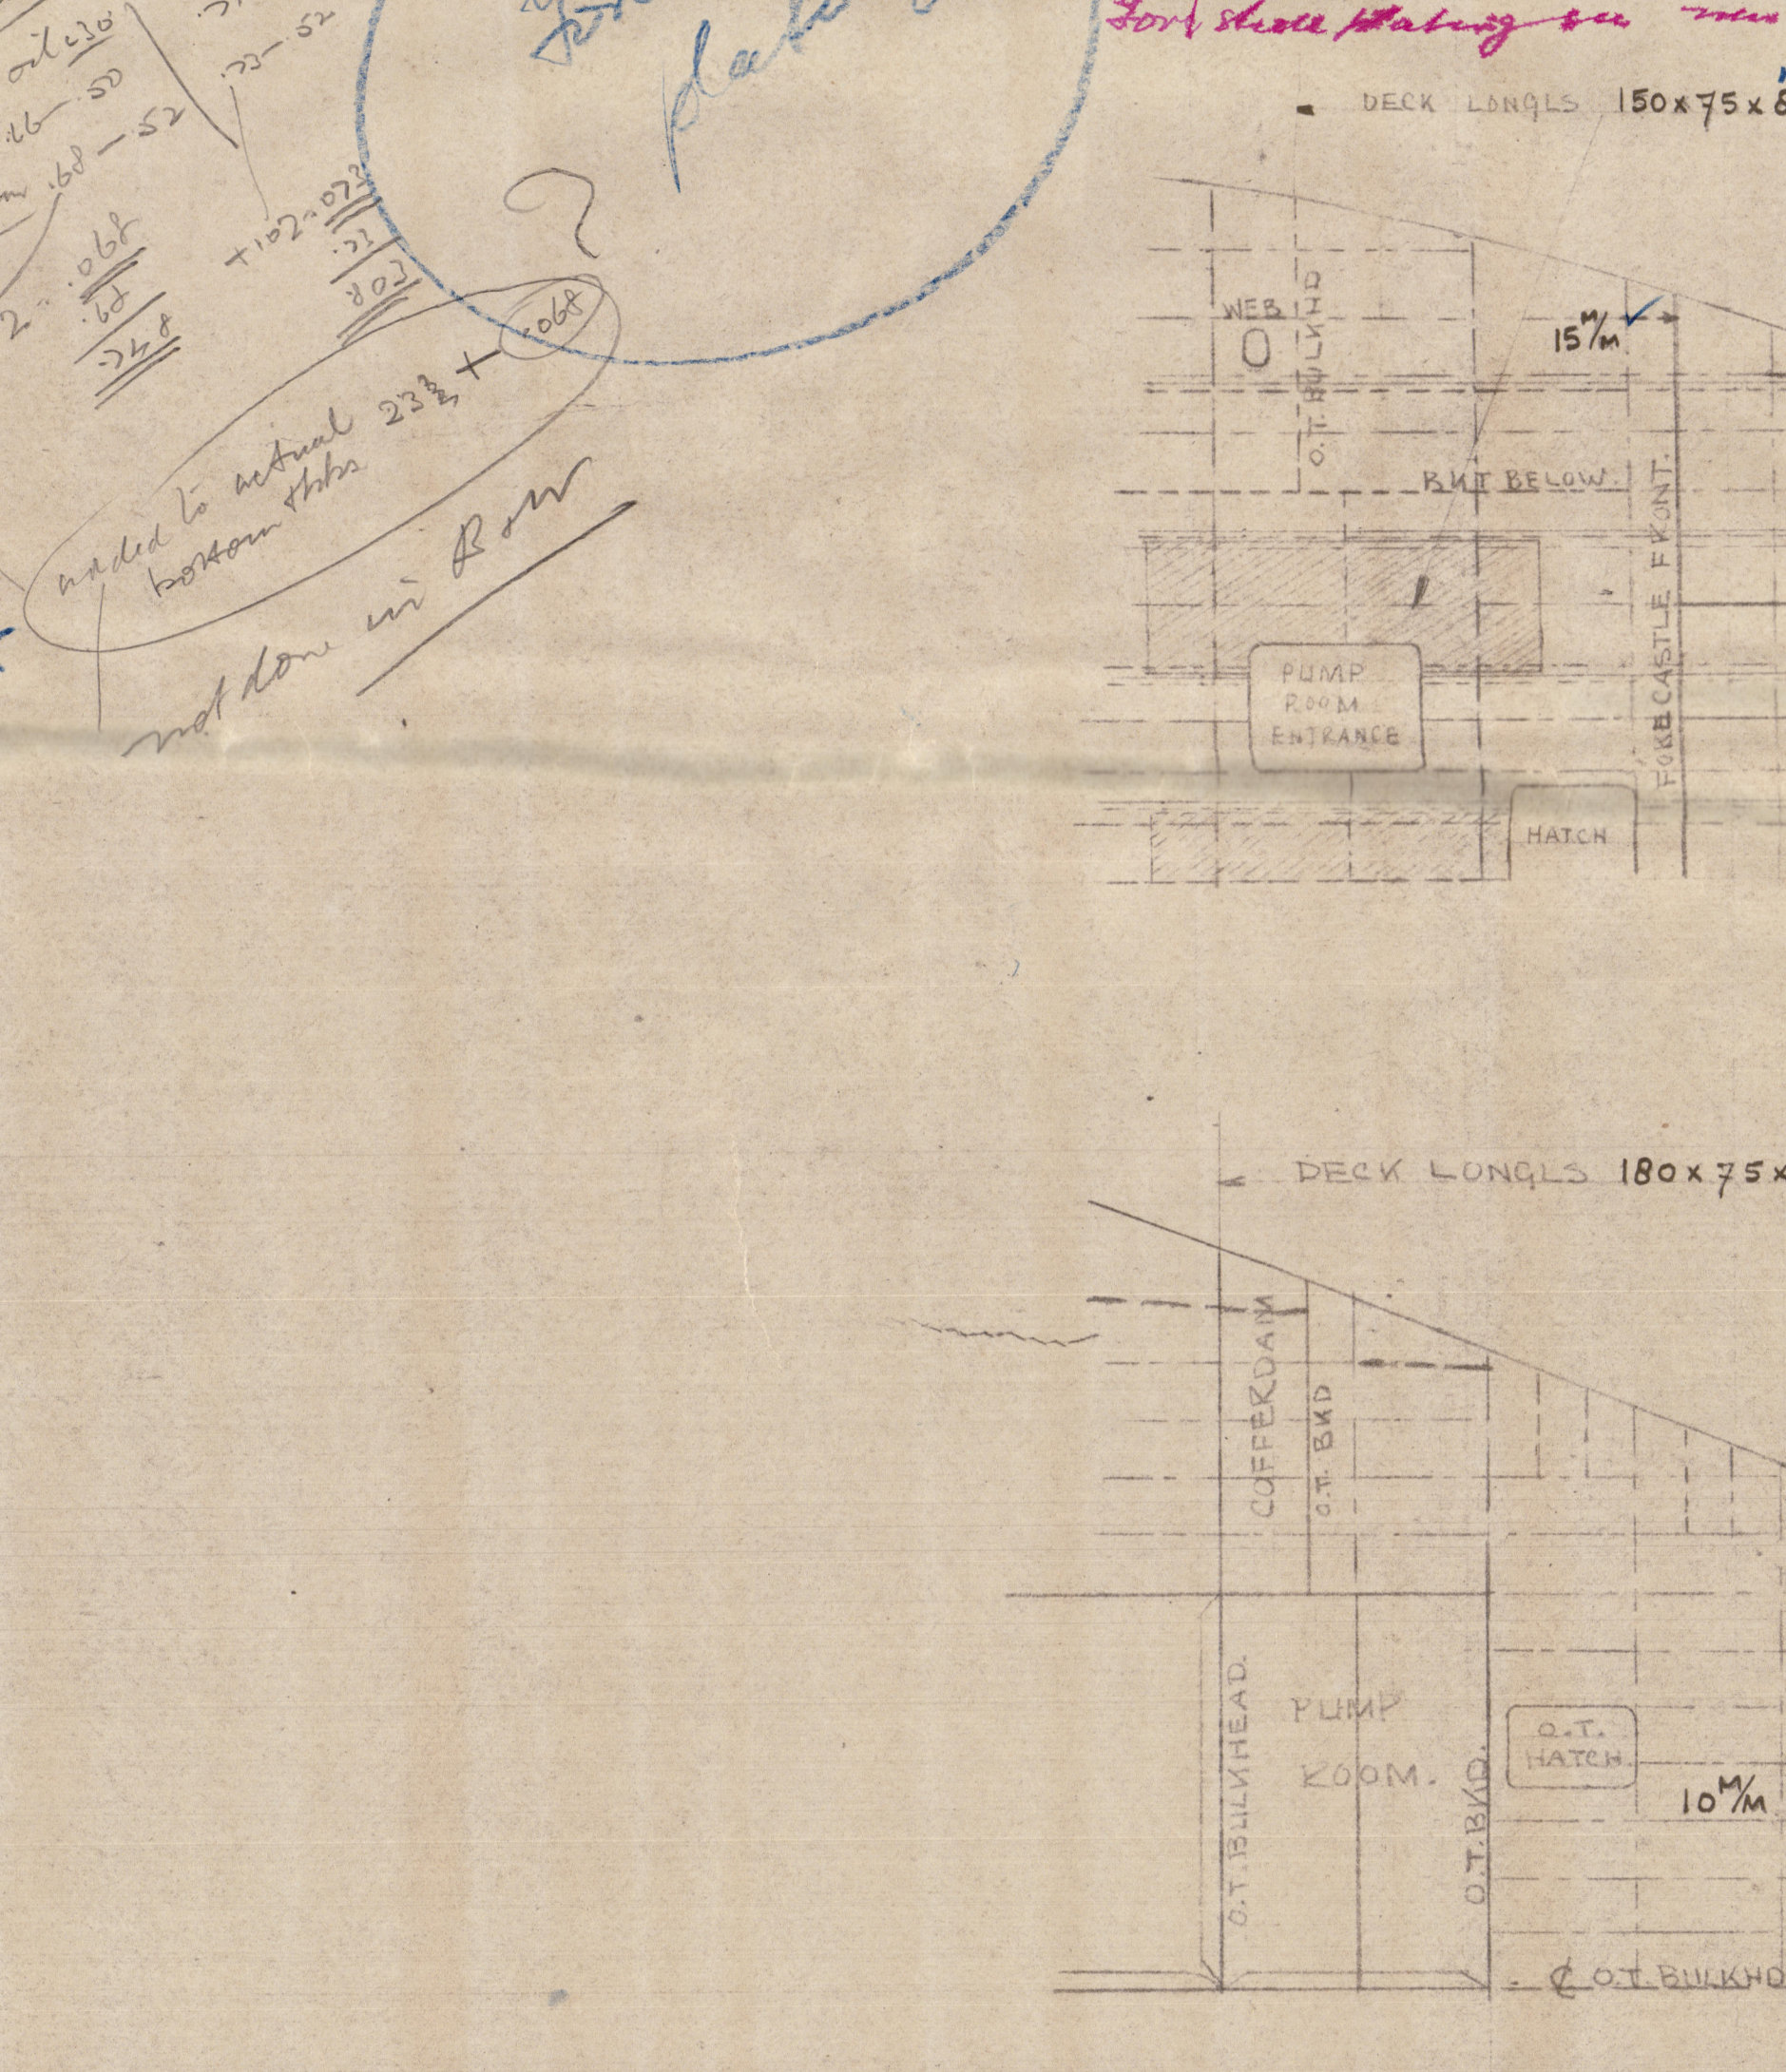

TRANSVERSE No 81

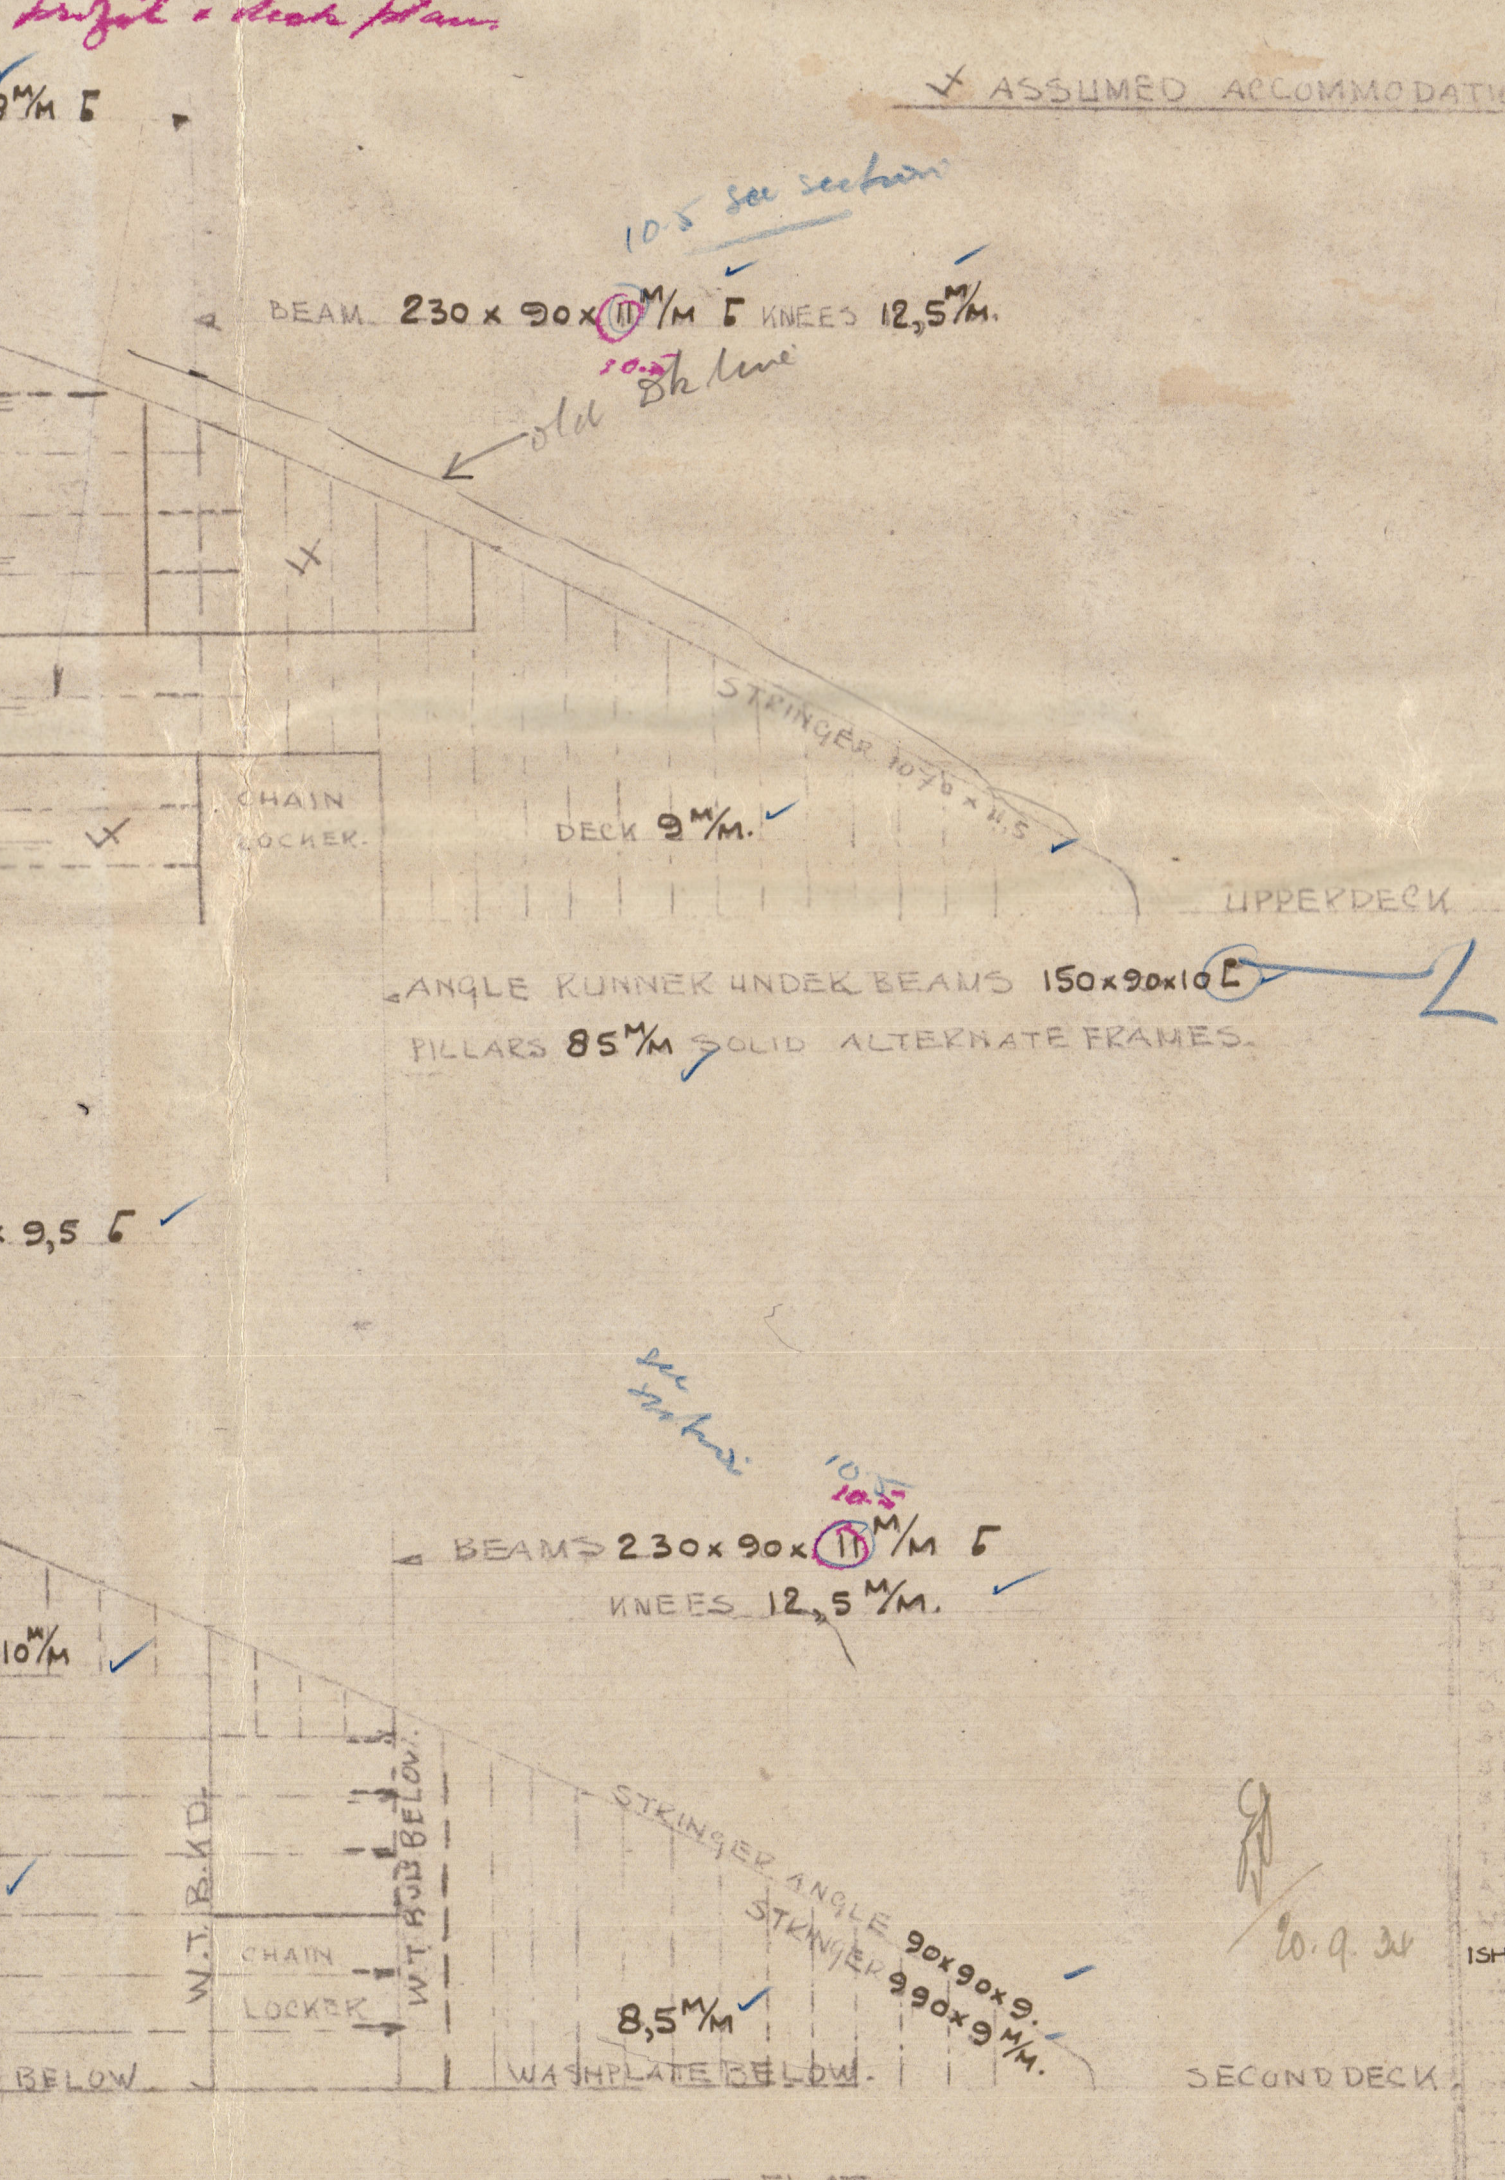

TRANSVERSE No 82

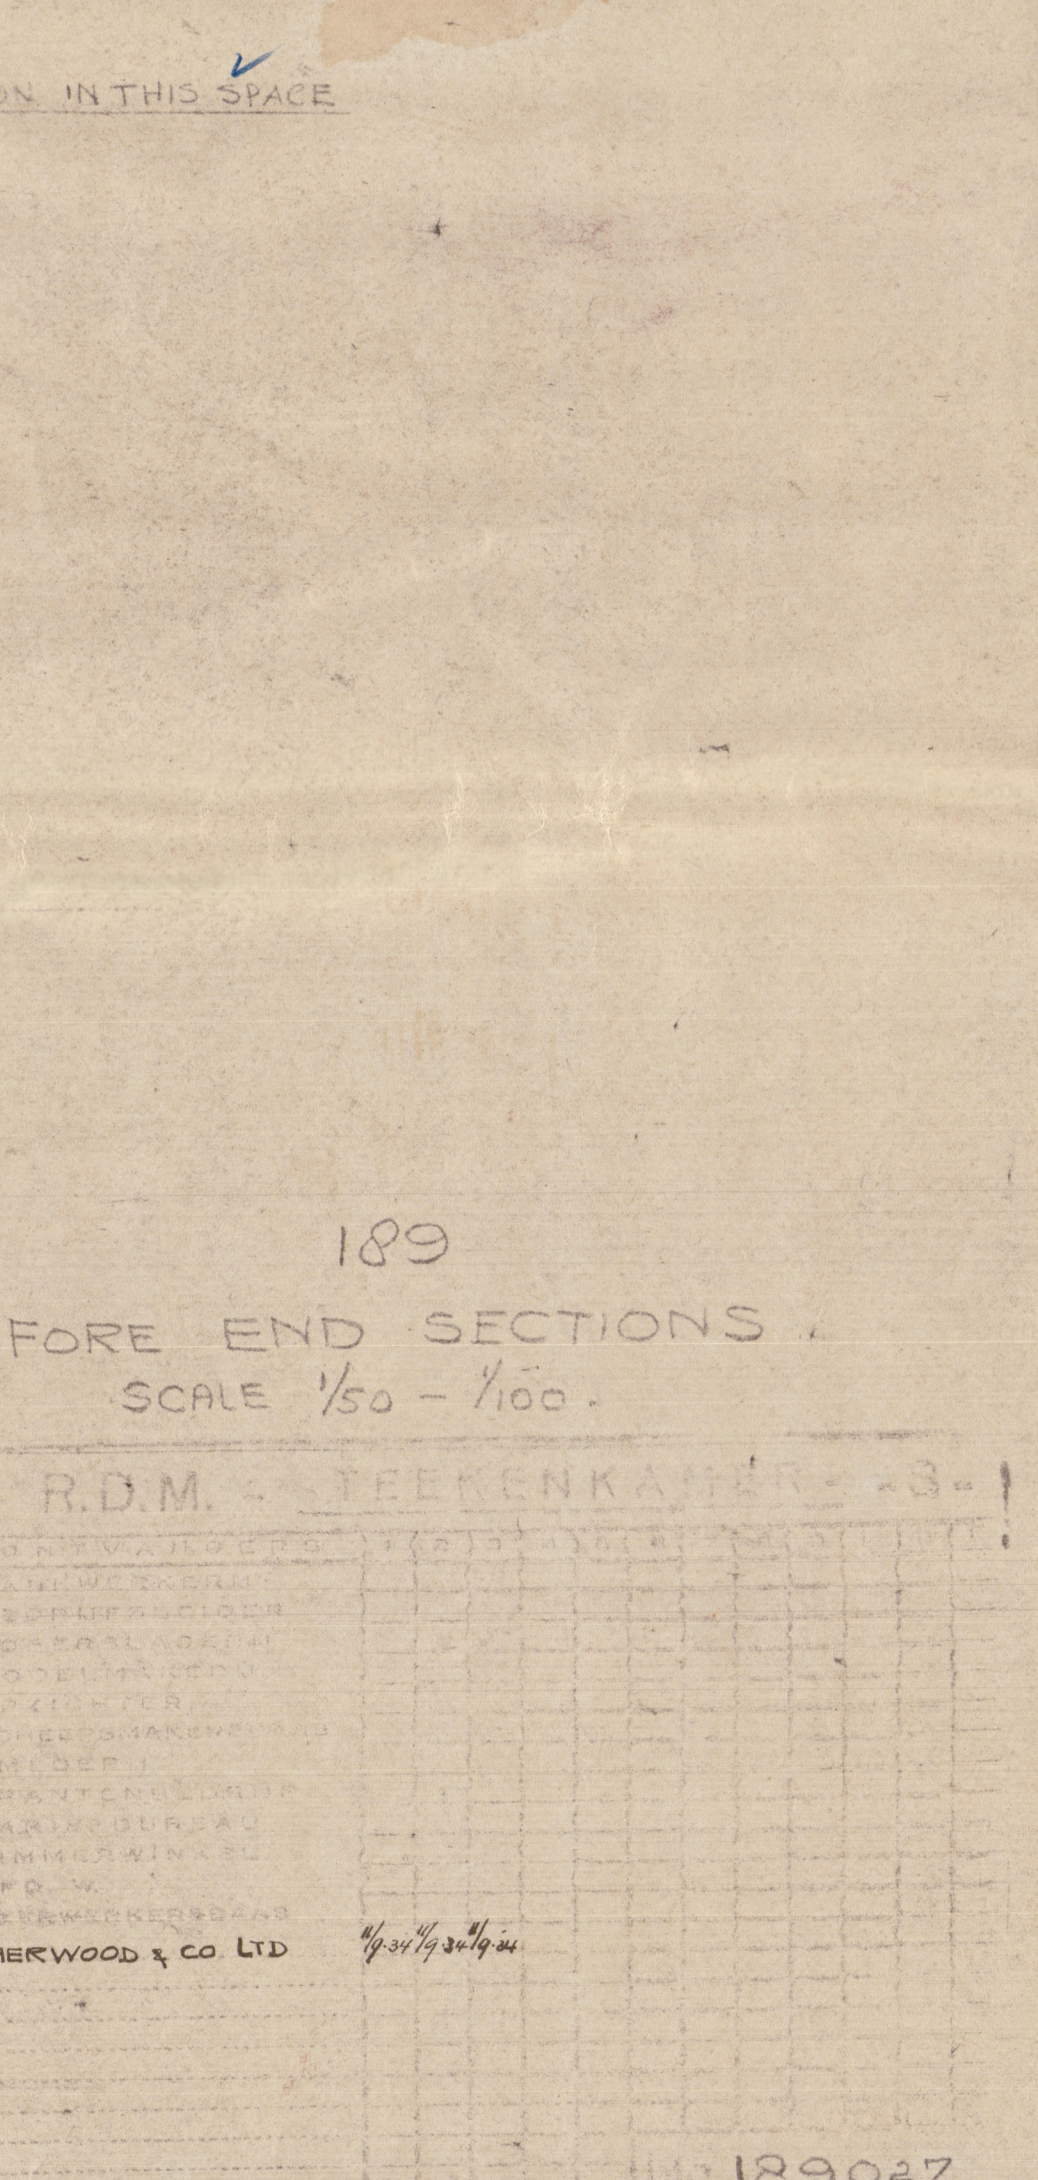

TRANSVERSE No 83

APPROVED BY  
DATE 17/9/30

17-9-30



Per form

504

J. S. Walden

Rotterdamse


Fore end sections.

RECORDS DEPT.  
LONDON.




"Menara"

(20)

(21)

Revised.

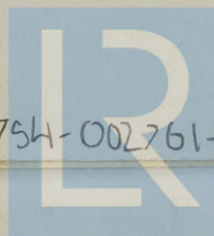

© 2020

002754-002761-0045

Lloyd's Register  
Foundation