


THESE HOLES NOT TO BE
DRILLED IN PLATE TILL
QUADRANT IS BOLTED UP TIGHT

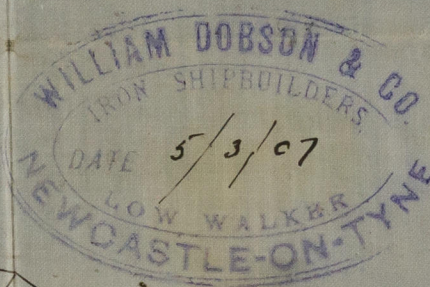


1 1/2" STEERING CHAINS
Special.

QUADRANT TILLER

SCALE 3/4" = 1 FT

Nº 154 SHIP

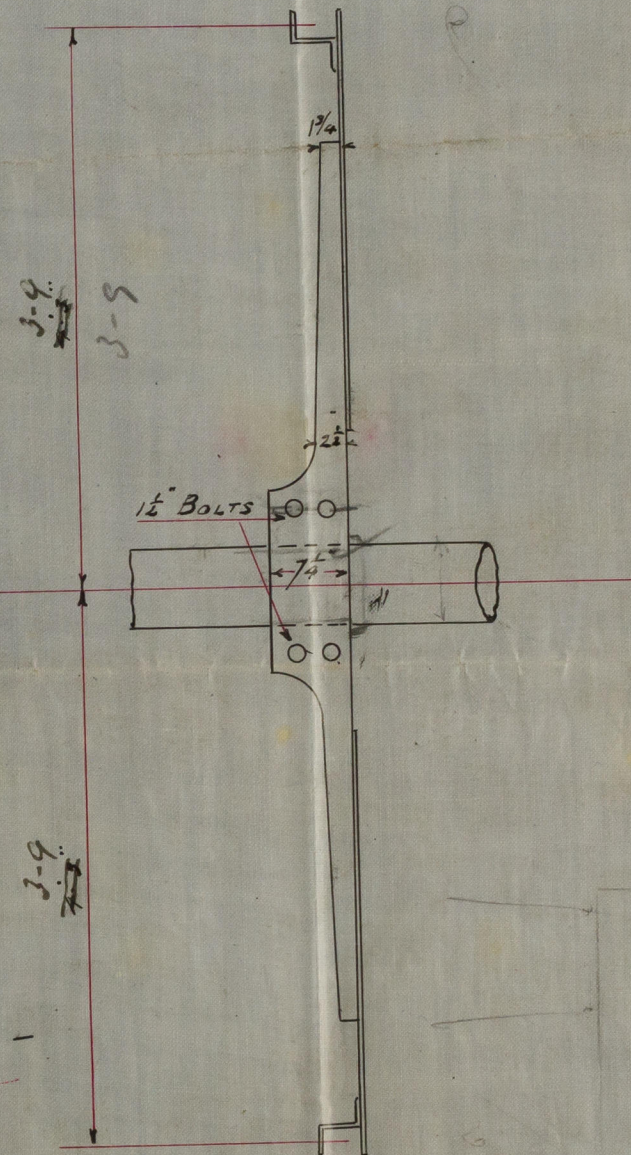

Approved
See Letter 19.3.7
BT.



© 2020


Lloyd's Register
Foundation

002754-002761-0202

DOBSON'S No 154
Quadrant.
S.S. "Canadian"



002754-002761-0202

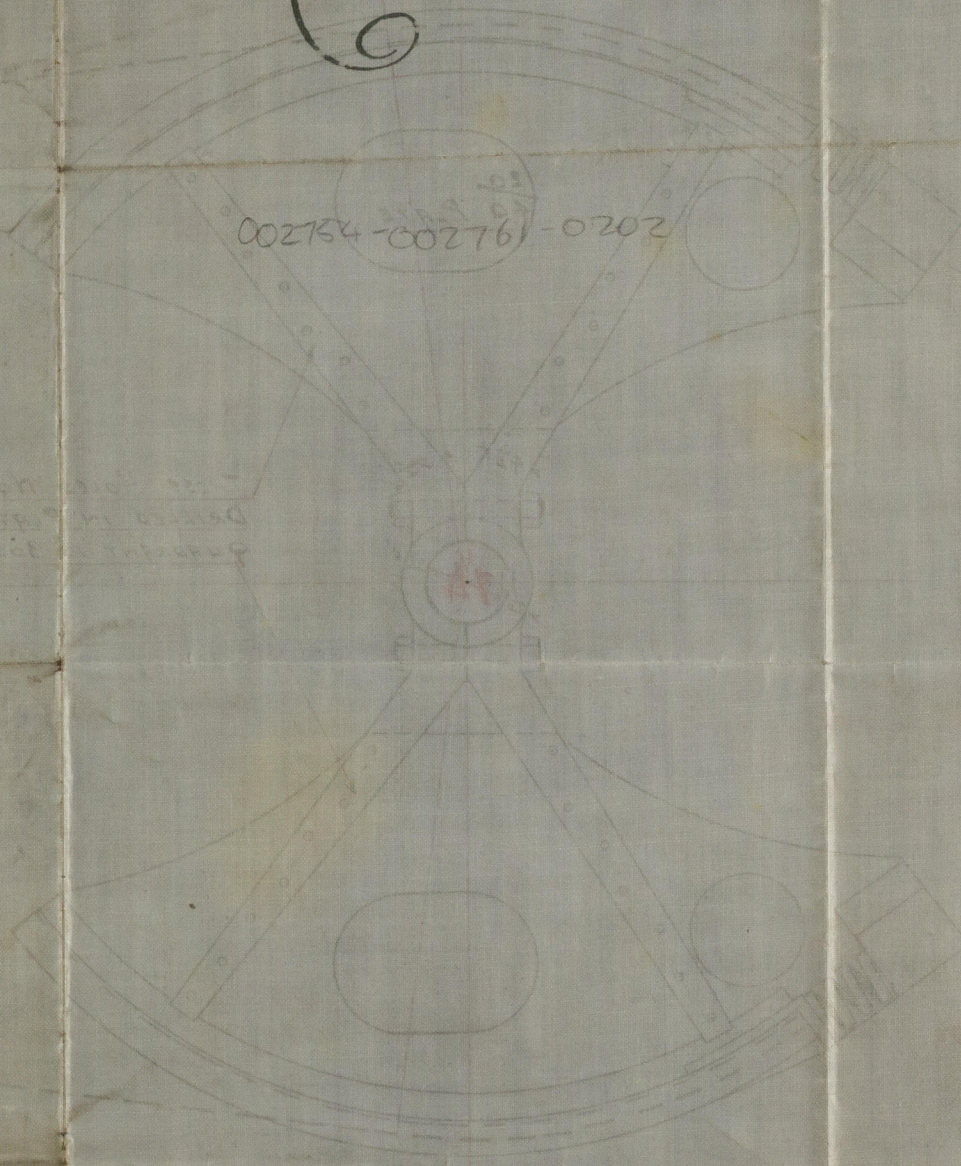

154



© 2020

Lloyd's Register
Foundation