


SCALE  $\frac{1}{2} = 1 \text{ F.T.}$

248 \* 43 EX \* 17' 0" DM TO SPAR D<sup>5</sup>

per Mr Dunlop & Owner

Approved *JK*  
See Letter 24. 2-4

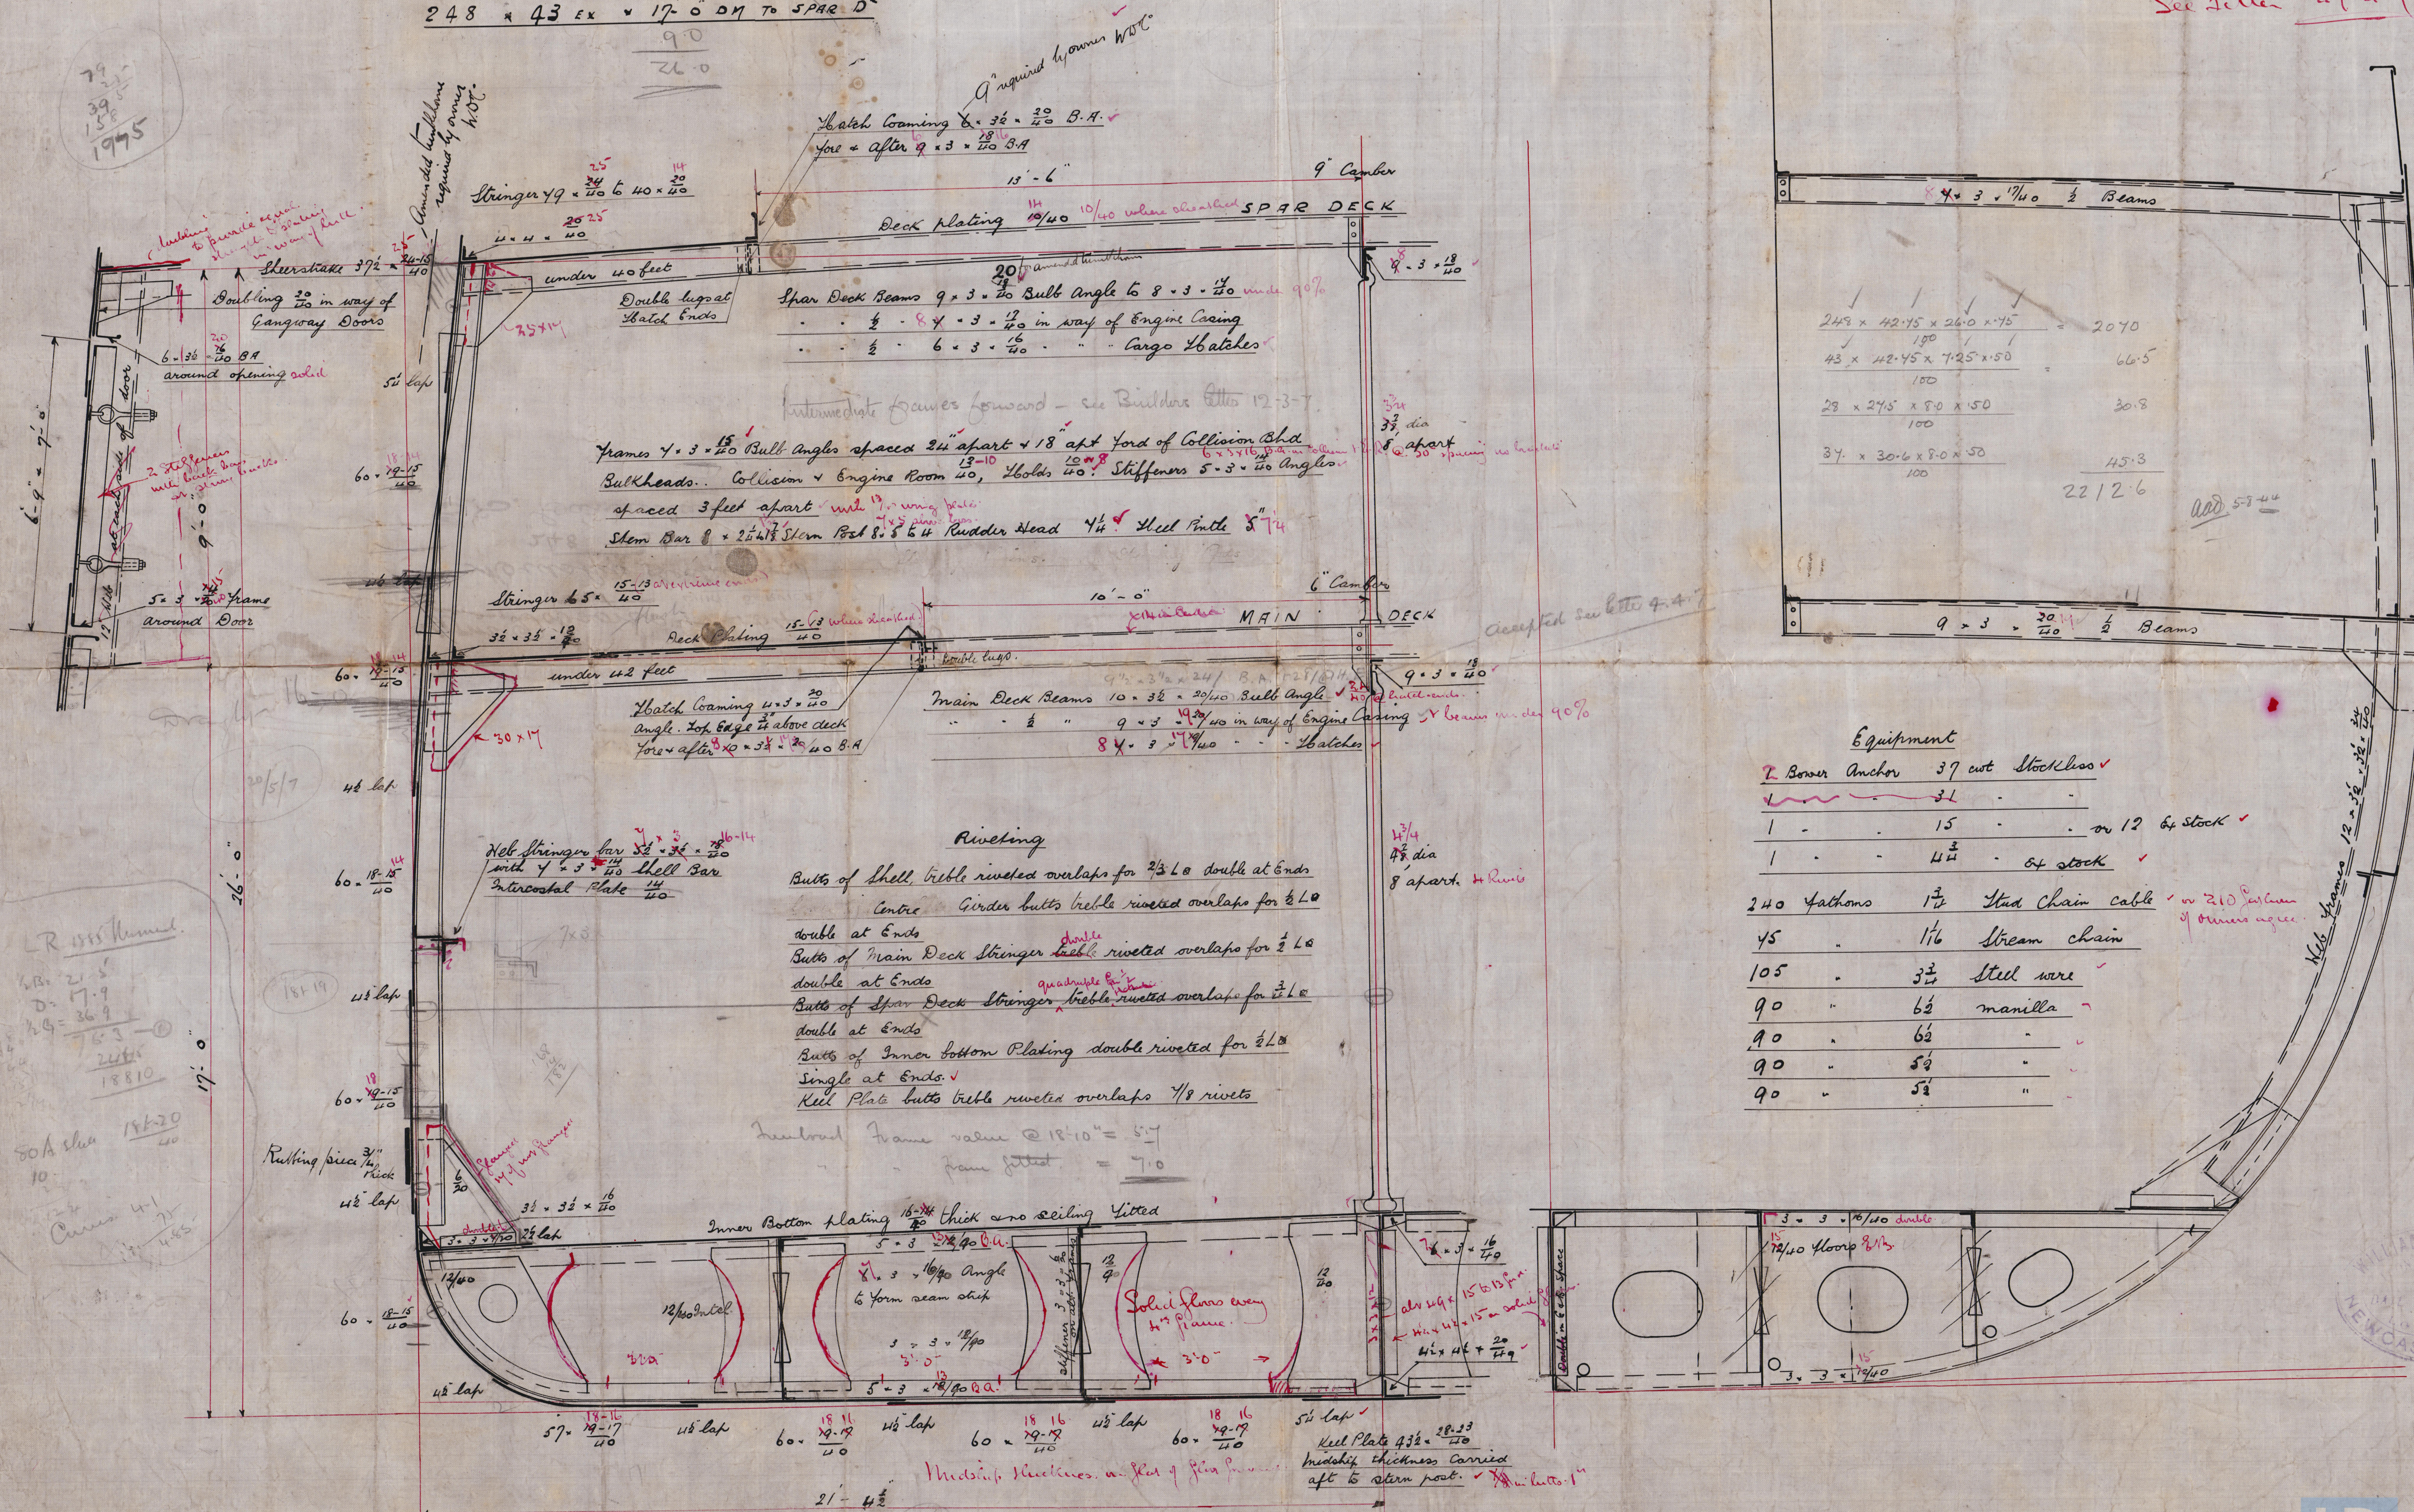



Wm Dobson's No 154


LAKE SERVICE.

Midship Section

248 x 43 x 17.26

S.S. "Canadian"

002754-002761-0203

 

© 2020

Lloyd's Register  
Foundation

002754-002761-0203