

32
27
22
84
119
116

N^o. 492.

MIDSHIP SECTION.

DIMENSIONS:- 252'-0" B.P. x 43'-0" MLD. x 19'-0" MLD.

TO CLASS B.S. * [GREAT LAKES & RIVER ST. LAWRENCE].

DRAUGHT-14'-0" EXT.

SCALE-1/2"=1 FOOT.



EQUIPMENT.

- 2 BOWER ANCHORS - 34 CWTs. STOCKLESS
- 1 STREAM ANCHOR - 114 " EK STOCK
- 180 FATHOMS 1 1/2" STUD CHAIN CABLE
- 75 " 3/2" STEEL STREAM WIRE
- 105 " 3/2" " WIRE TOWLINE
- 2 @ 90' " 6 1/2" HAWERS OR 2 @ 2 1/2" SW R.
- 2 @ 90' " 5' " OR 2 " SW R.

C.N^o.

252 x 43 x 19 = 75	1545
37 x 43 x 50 = 50	40
64 x 30 x 75 = 50	72
	1657


22 DEC 1922

Approved
See plan 25/12/22

Recommended
Modification in
arrangement of
Plating

12 x 54
Outside
Stakes

Inside
Stakes 54

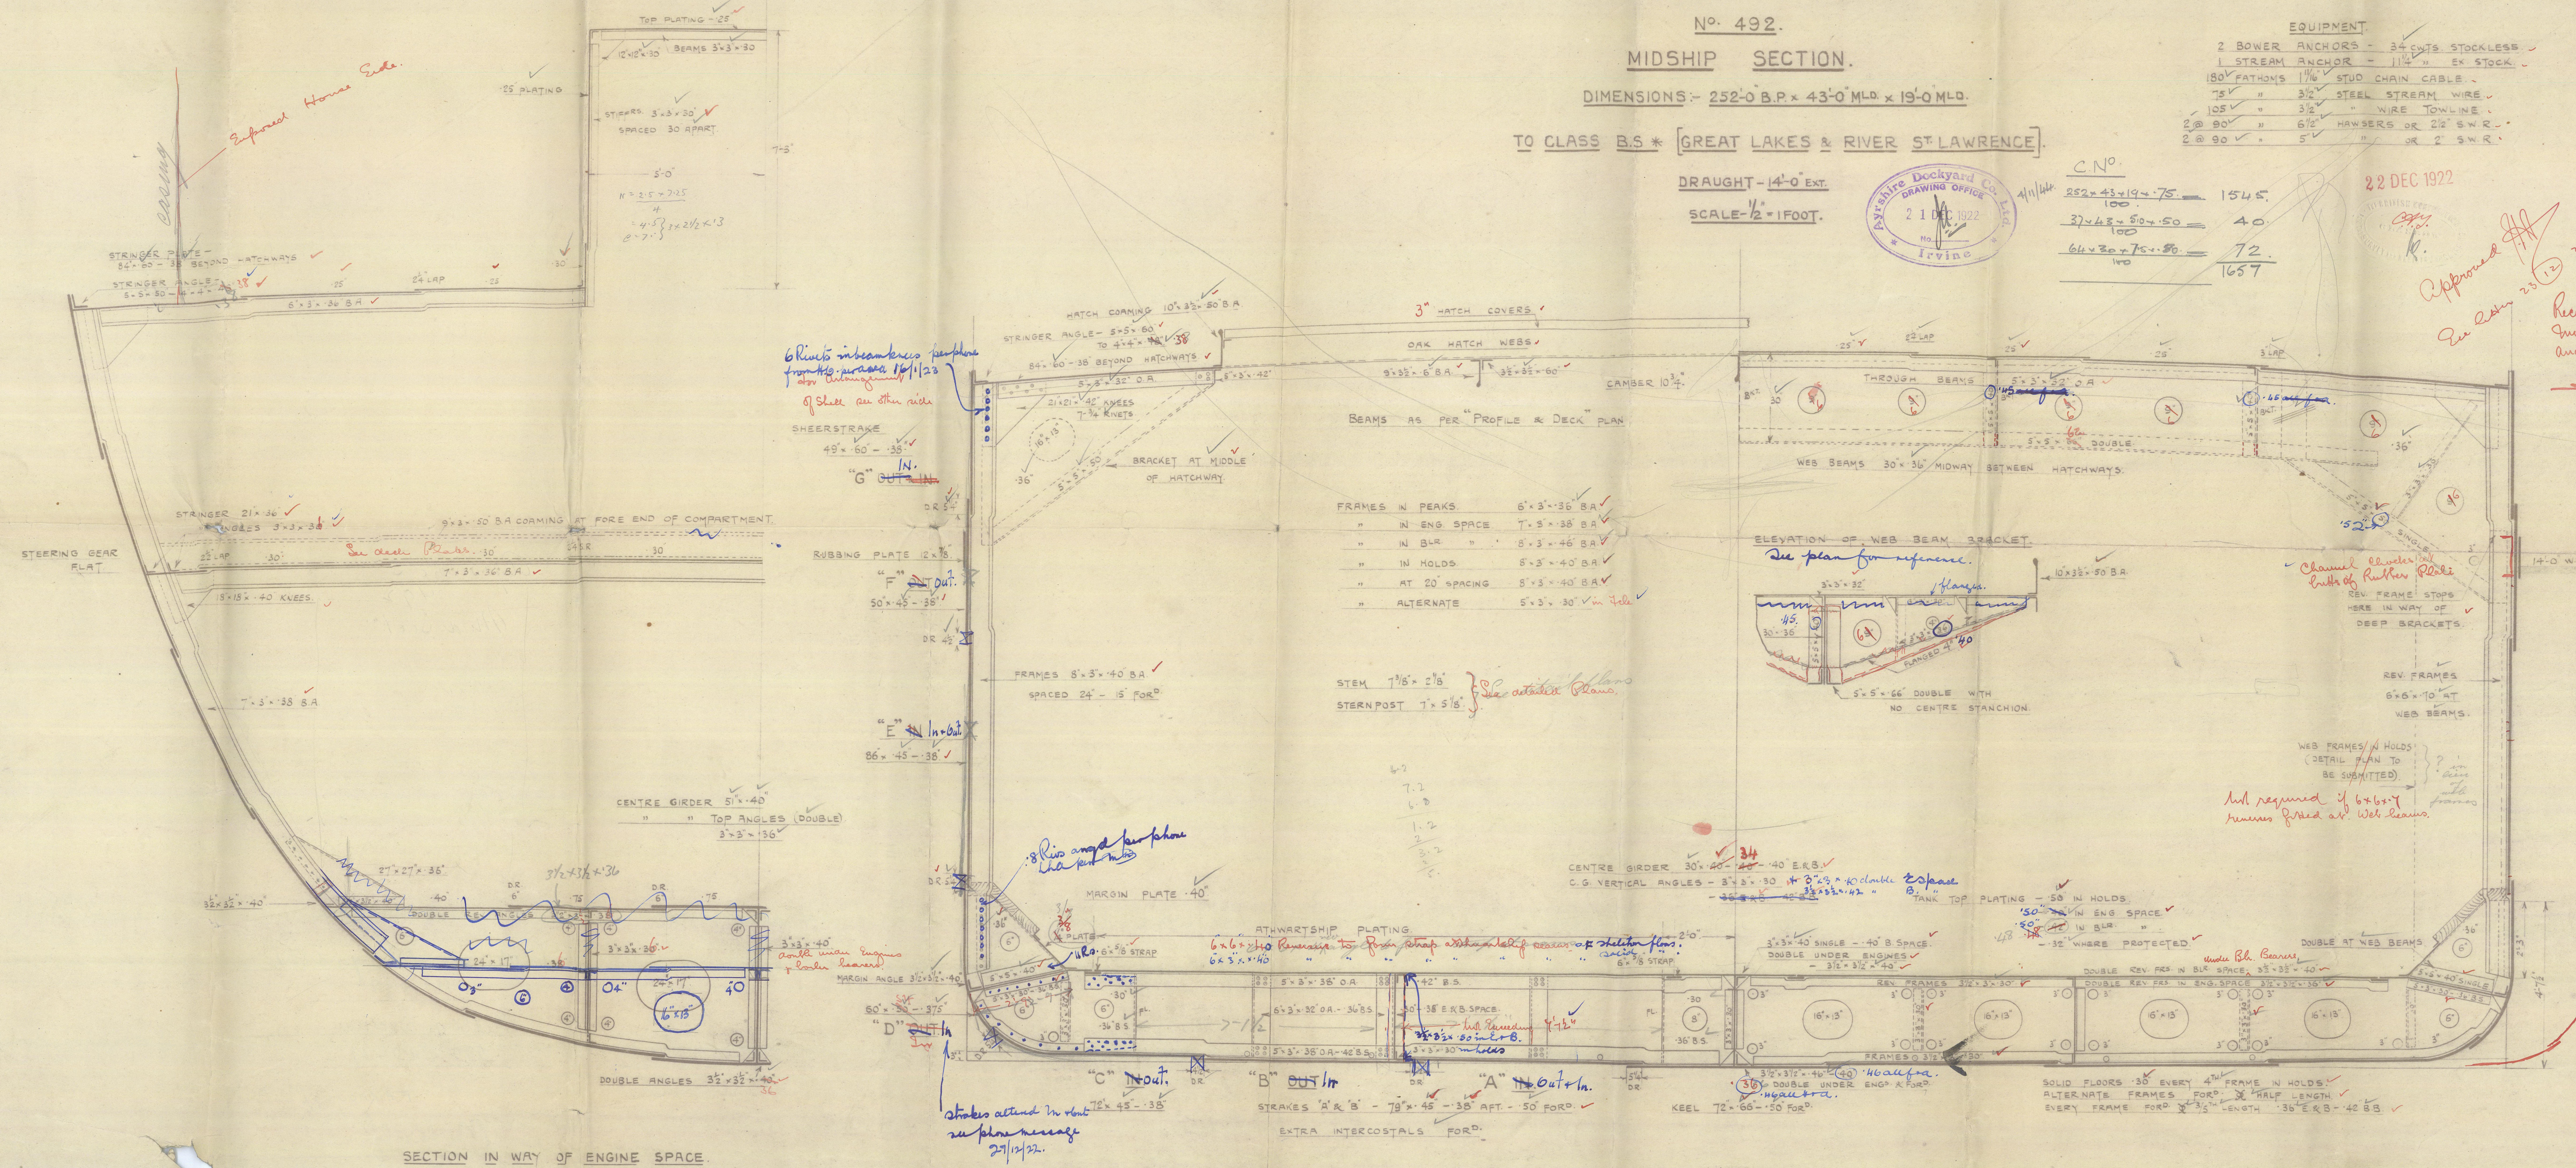


SECTION IN WAY OF ENGINE SPACE.

Ayrshire's
492
Mid Sect

Bag

Tc 21. 2. 23

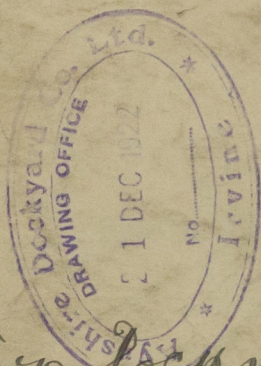

Ayrshire Dockyard Co. Ltd.
No 492

Midship Section
282' x 43' x 19'

FAIRMOUNT 23. 12. 22

SS Metcalfe.



© 2021

Lloyd's Register
002762-002769-0040
Foundation



© 2021

Lloyd's Register
Foundation