


— PROFILE AND DECKS. —

DIMENSIONS:- 252'-0" B.P. x 43'-0" B.M^{LD} x 19'-0" D.M^{LD} TO MAIN DECK.


TO CLASS B. S.* GREAT LAKES & RIVER ST LAWRENCE.

DRAUGHT. 14-0" EXTREME.

SCA/E 1/8 INCH = 1 FOOT.

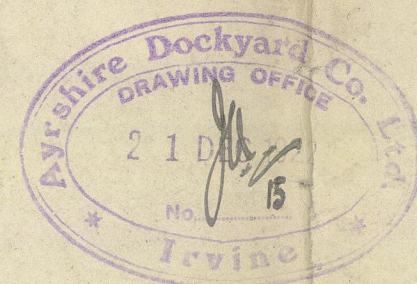

FAIRMOUNT

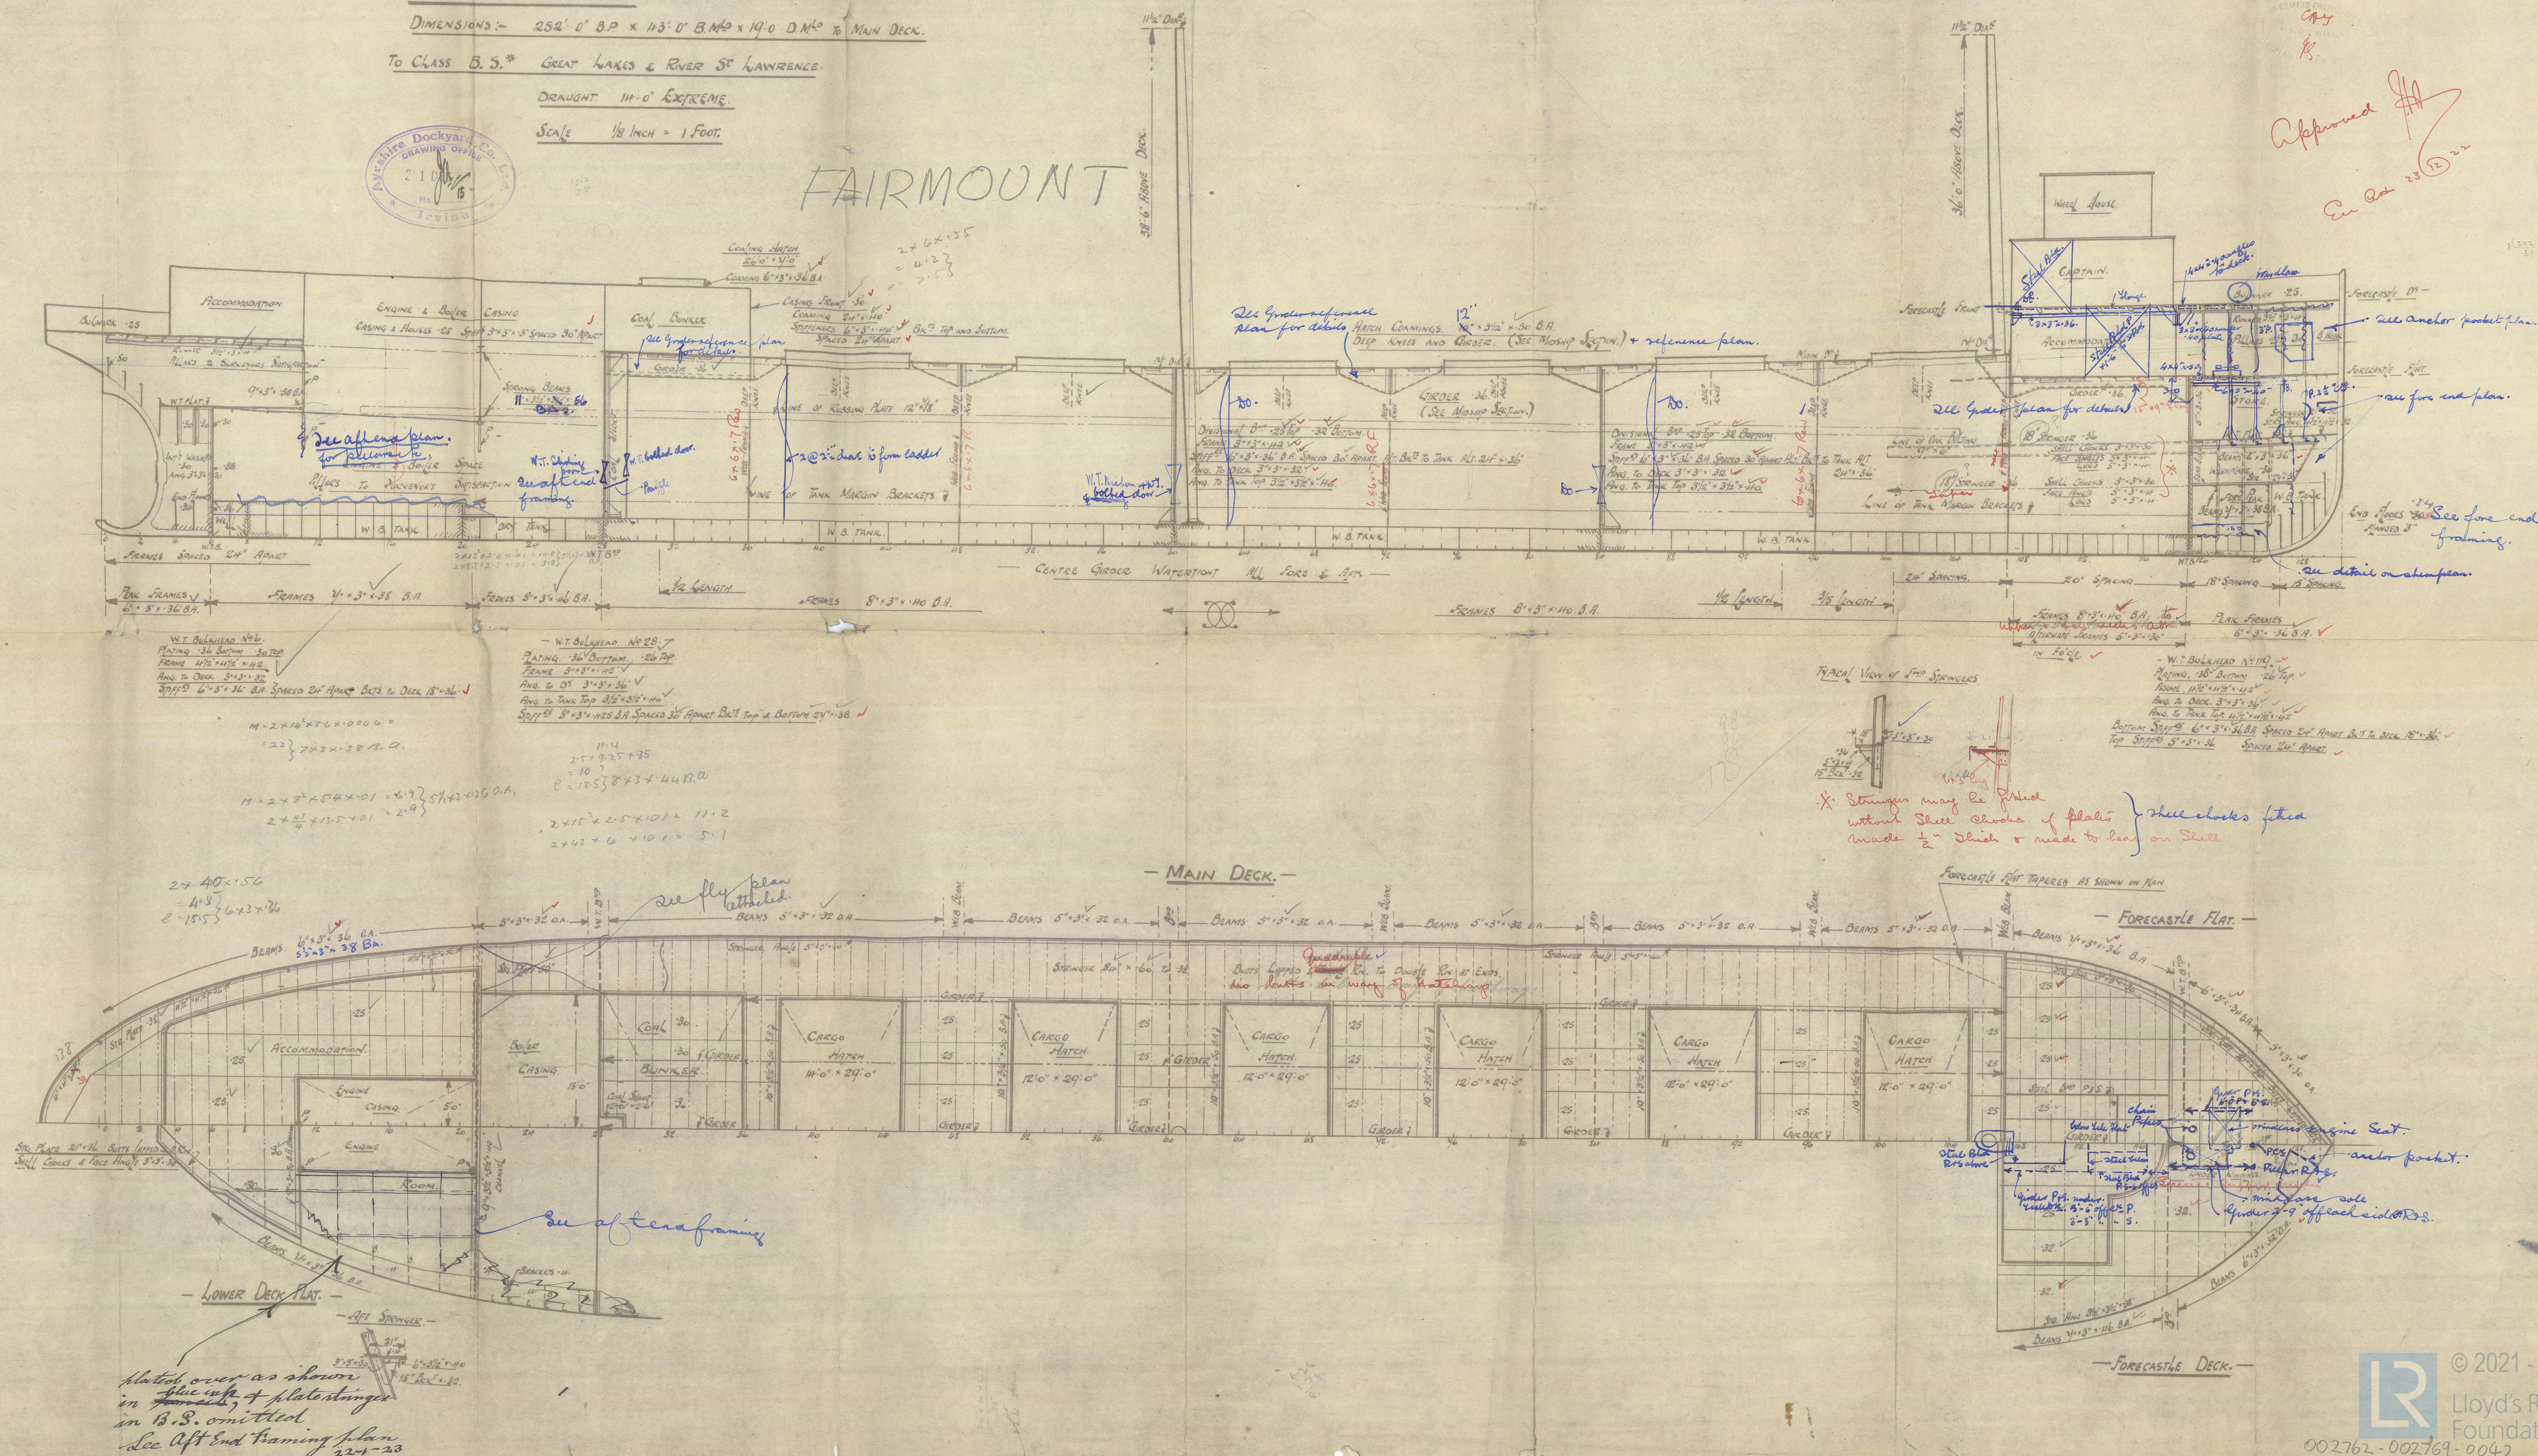

22 DEC 1922

Approved *J.H.*
E. A. *23* (12)

Ayrshire

492

profile + decks

Bag

FAIRMOUNT *

Tc 21. 2. 23

Ayrshire Dockyard & Co
492.

Profile + decks

252' x 43' x 19'

23. 12. 22.

88


"Metcalfe"

© 2021



Lloyd's Register

002762-002769-0042

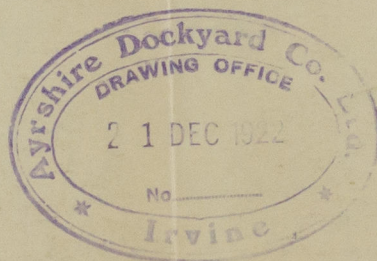

© 2021

Lloyd's Register
Foundation