



23 APR 1923

S.S. No. 492.

RE-ARRANGEMENT OF
STRINGER PLATE, AFT, PORT SIDE ONLY,
TO ALLOW BOILERS TO BE SHIPPED.

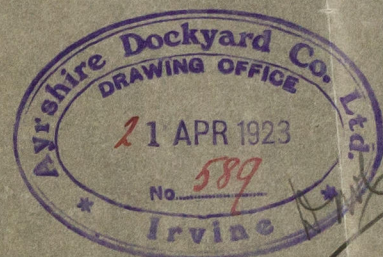

ALTERATION TO STRINGER PLATE
ON PORT SIDE ONLY

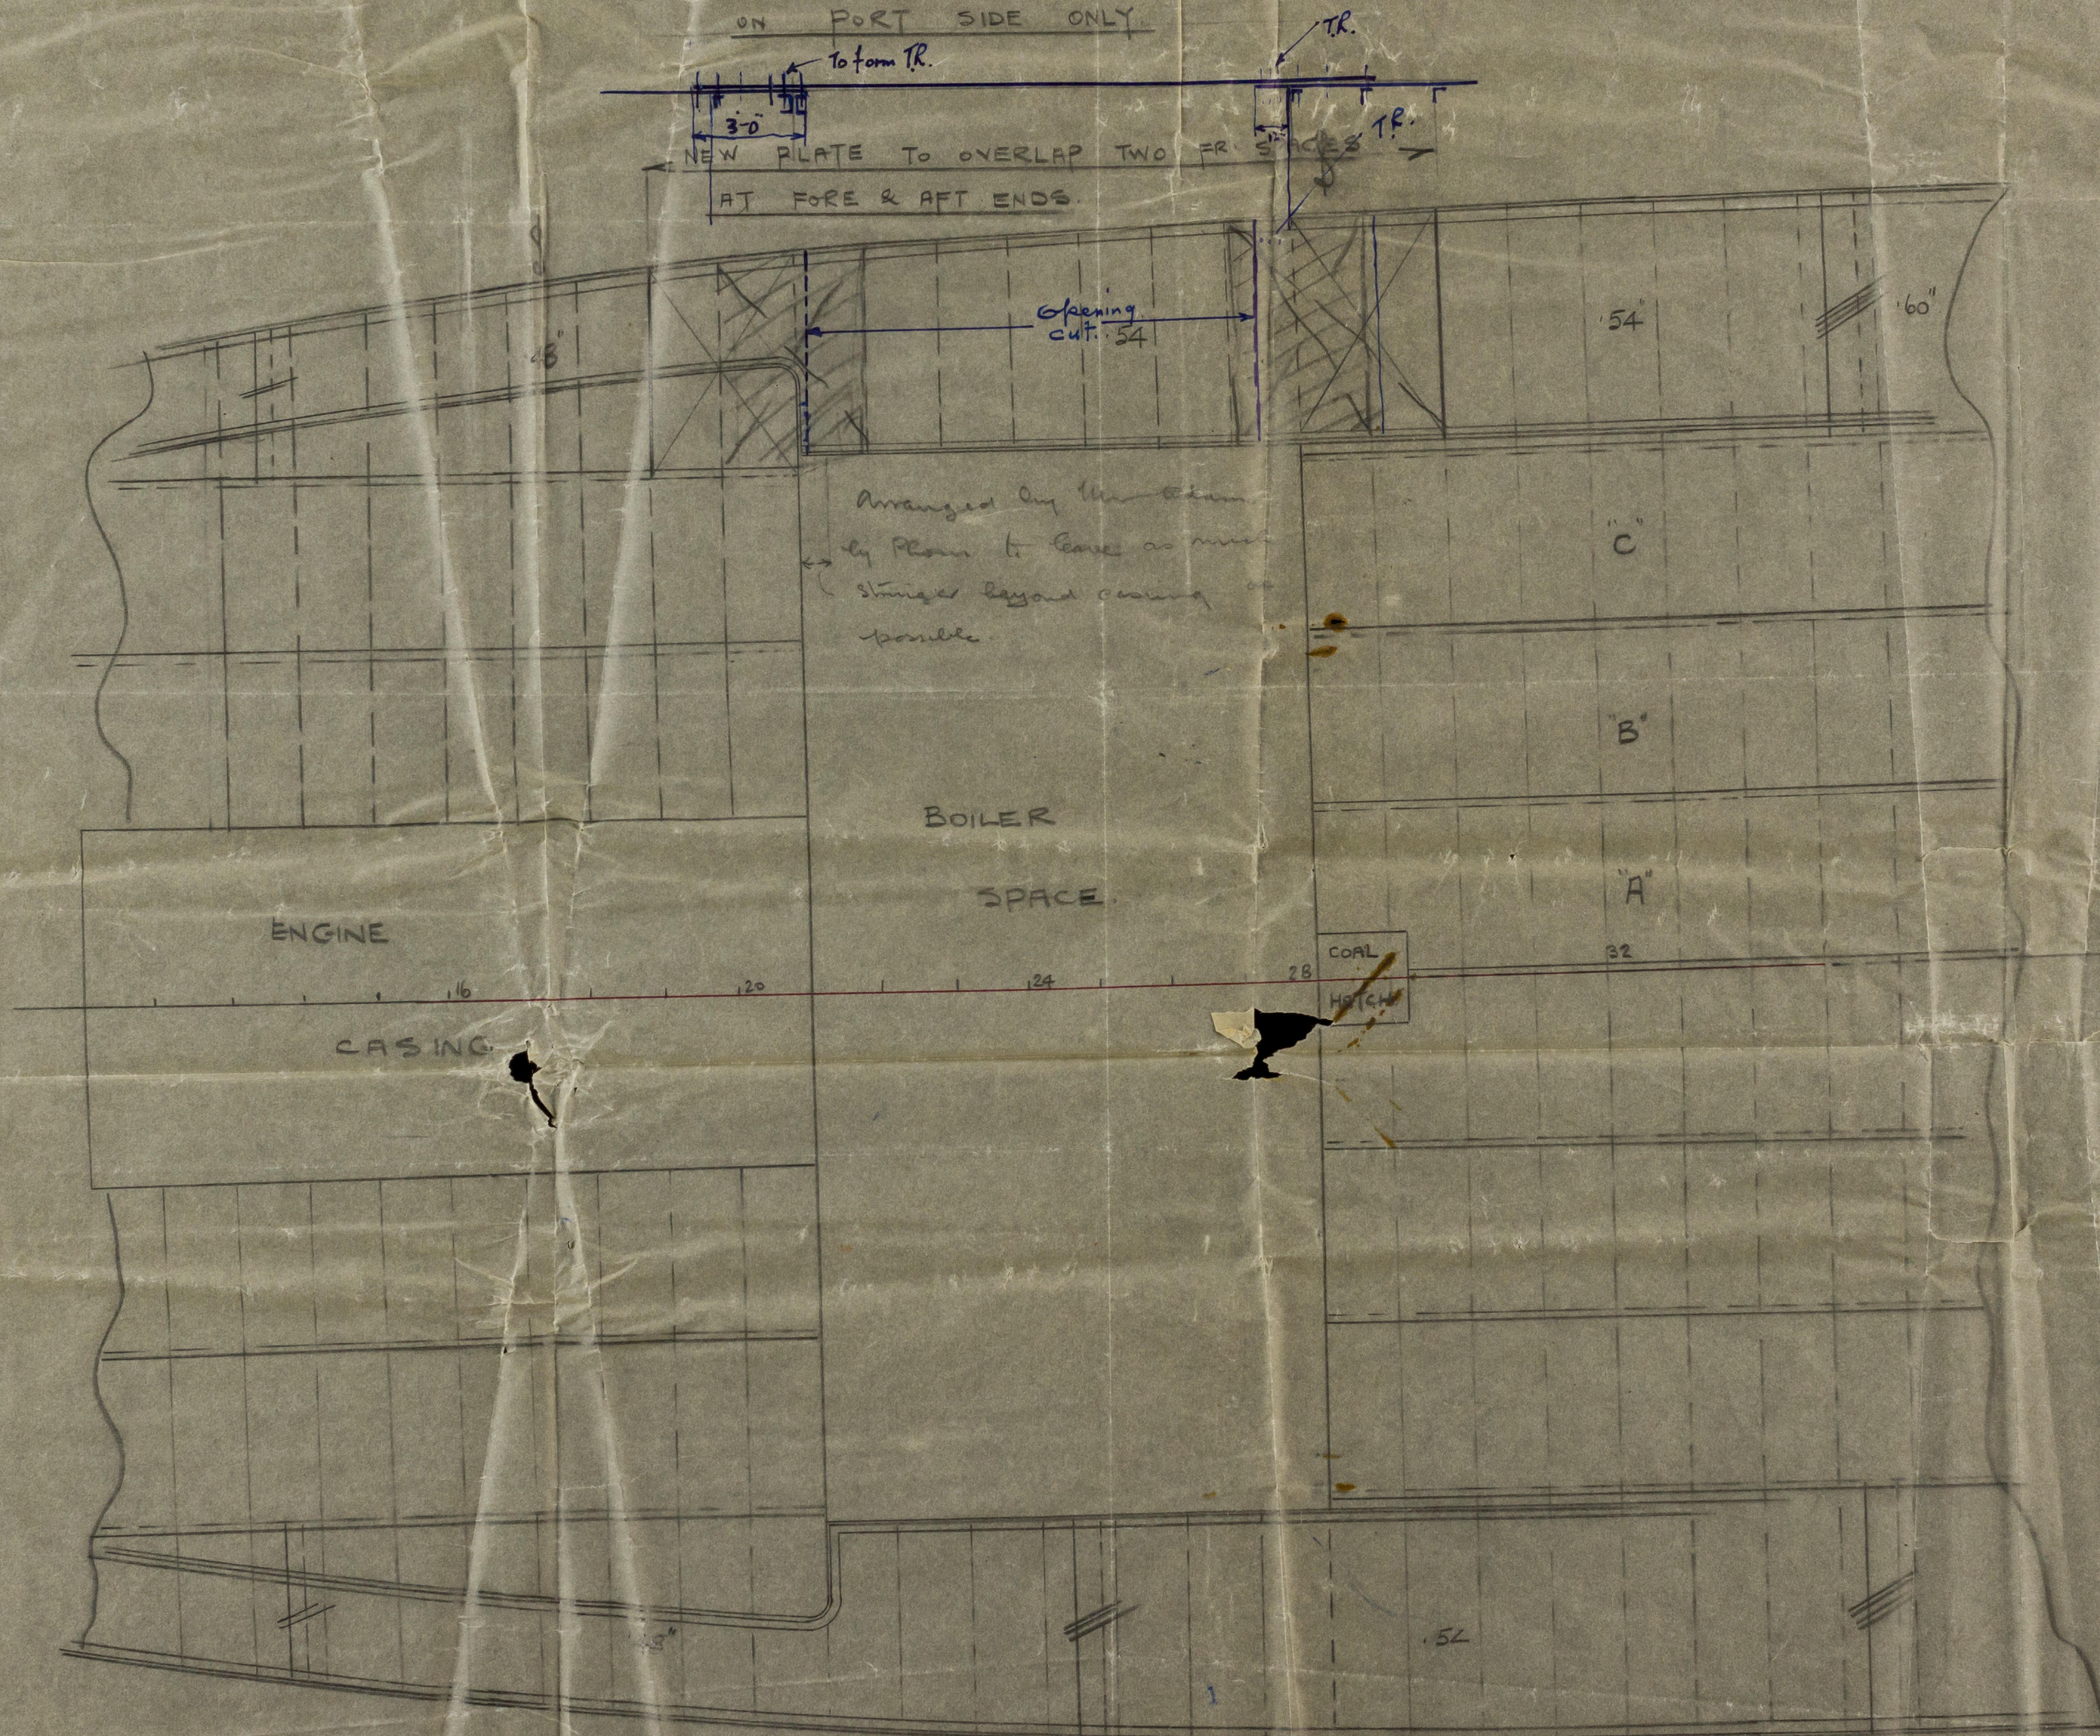

STAR^d SIDE AS AT
PRESENT ON SHIP.

002762-002769-0044



© 2021
Lloyd's Register
Foundation

S.S. No. 492.

RE-ARRANGEMENT OF

STRINGER PLATE, AFT, PORT SIDE ONLY

TO ALLOW BOILERS TO BE SHIPPED.

ALTERATION TO STRINGER PLATE



ON

PORT SIDE ONLY

to form TR.

TR.

005385-005386-005387

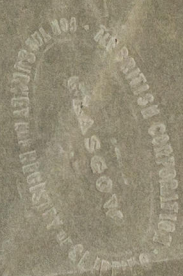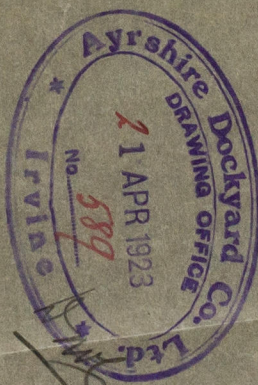

23 APR 1923

Ayrshire D. Y. Co.
1492

Re-arrngt of Stringer
Plate aft Port Side Only
to Allow Bkrs to be
shipped



© 2021
Lloyd's Register
Foundation