

14/5/28

6
1

LLOYD'S NUMERALS
L x D : 450 x 33.5 = 1775
L x (D + 0.450 x (60 + 33.5)) = 44775
V/D : 450/40 = 11.25

— PROFILE & DECK PLAN —


DIMENSIONS - LENGTH 374.50' BREADTH MID 60'-0" DEPTH MID 40'-0"

TO CLASS LLOYD'S 100-A-1 WITH FREEBOARD & SPECIAL NOTATION LONGITUDINAL FRAMING IN BOTTOM & AT DECK.


SHERWOOD CONSTRUCTION SYSTEM
SCALE 1/8" = 1'-0"

WINDLASS, WINCHES, MASTS, & STEERING GEAR, TO BE SUPPORTED TO SURVEYOR'S SATISFACTION.

TWO DECK BULKHEAD STIFFENERS IN LINE WITH GIRDERS
8 x 3 x 40 2AS MARKED U

 

Messrs S.C. Chapman & Co. Ltd.
Ref No 423, plan No 6561
April 26, 1928

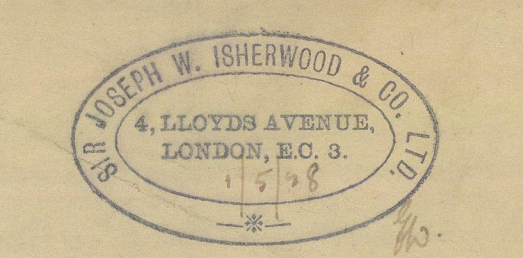

14.5.28



3
Profile & deck Plans

approved by Lloyds

S. S. Thailand Castle 

LIVERPOOL

Report No. 95825

9464 947

S. S. Penwith Castle x

LIVERPOOL

Report No. 95842

FULANI X

002762 - 002769 - 0165



© 2021

Lloyd's Register
Foundation