

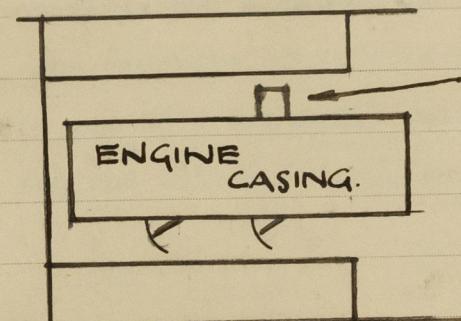
Lloyd's Register of Shipping.

Ship's Name DURENDA

Official No. 146312

Memorandum of alterations reported since ship was surveyed for assignment of Load Lines
in JUNE, 1932.

Reverse bars $3\frac{1}{2} \times 3\frac{1}{2} \times \frac{3}{8}$ are now fitted to the stiffeners
on each side of the bridge front openings (Lon. July, 1935).

BRIDGE
TWEEN
DECKHATCH 2'-0" x 2'-0", 9" RA. COAMING
TO STORE BELOW. $2\frac{1}{2}$ " COVERS 3" BEARING.
CLEATS AND TARPAULINS.

MIDDLESBOROUGH, MAY 1937.

S.B. 3.6.37.

002762-002769-0168



© 2021

Lloyd's Register
Foundation