

Principal Dimensions

Length P.P. 313.0
Breadth Extreme 44.6
Depth in hold to tank top 20.7
Depth moulded 23.1

Class 100 A.1. Lloyd's.

Scale 1/2" = 1 Foot

11.7.05

Scantling Numbers

Half breadth 22.15
Depth 23.98
Half girth 42.20
88.33

Rule Length 311.2

2nd Number 27488

Equip Number 29549. (Z)

Depths in Length 12.97

Breadths do 7.02


Equipment (Z)

2 Bowers 42 wt } Stockless
1 do 35 1/2 " }
1 Stream 11 " ex stock
1 Hedge 5 1/4 " " "
240 Dalthoms 1 1/16 stud chain cable
75 do 44 Mooring wire
100 do 4 Steel Downline
2-90 do 2 1/2 " Bowsers
2-90 do 6 Manila Warps.

Pillars 4 1/4 dia. placed zigzag

9 1/2 { Frames 5 1/2 x 3 1/2 x 20 for 1/5 L to 1/20. 24" apart
Reverse Frames 7 x 3 1/2 x 20 for 1/5 L to 1/20. all to Main deck
Reverse Frames in Peaks 4 x 3 1/2 x 20. alternate Rev frames to side deck
Tank Reverse Frames. double under Engines and under Boiler Peakers.
Bulkheads 1 1/2 x 20. Floors by Rule 2 1/2 x 20 for 1/5 L to 1/20
Stem 10 1/2 x 2 1/4. Stern Frame 11 x 6. Rudder 8 1/2 x 4 1/4

rule 30 1/2 x
35" Tank Margin Plate 1/20 (1/20 in Boiler Space)
57" Middle line strake 1/20 for 1/2 L to 1/20 (1/20 in Boiler Space). Seams & butts double riv
Tank top in Engine Space 1/20 iron, in Boiler Space 1/20 iron
Tank top butts double riv for 1/2 L.

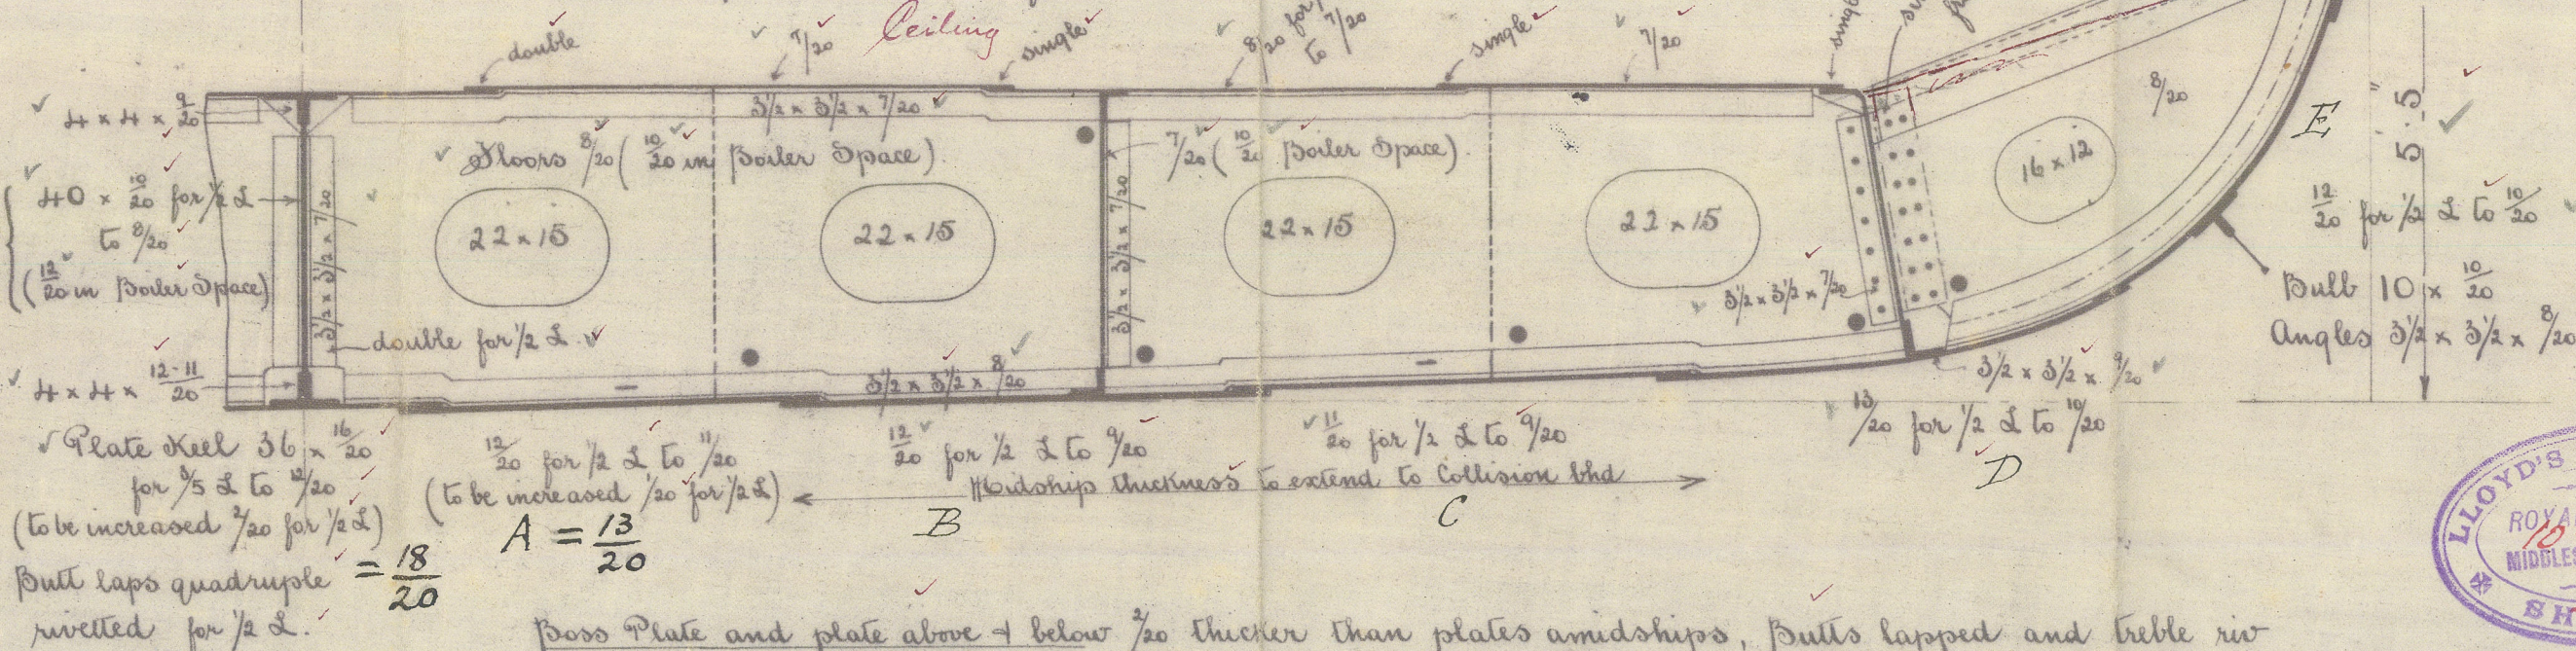

From keel to Main deck all shell butts lapped and treble riv. quadruple where over rule width for 1/2 L.
Increases in tank under Boilers (where not shown) as per rules
Shell (ex plate keel & garbd) where 1/20 or above reduced 1/20 in way of double bottom

June 30/05

Richardson Dock & Co.

Shipbuilders

Stockton-on-Tees




NO 3829

Lloyd's Register Foundation

002770-002783-0080

Richardson Buck
- No 569 -
Midship Section

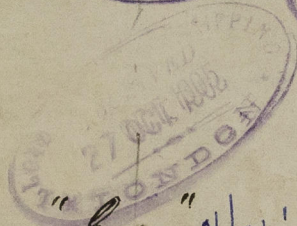

"Lda" "N/W" Hildegaard'

Mdb report No 4503



© 2020

Lloyd's Register
Foundation

002770-002783-0080