



Nº 689

# LONGITUDINAL SECTION.

SCALE: - 1/4 IN = 1 FOOT.

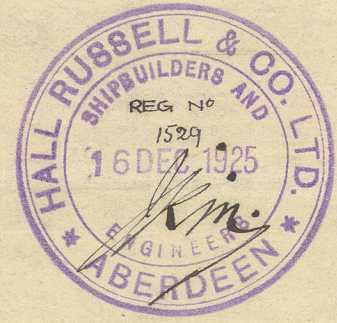

APPROVED  
LLOYD'S REGISTER OF SHIPPING  
*Management per [Signature]*  
DATE 16.12.25

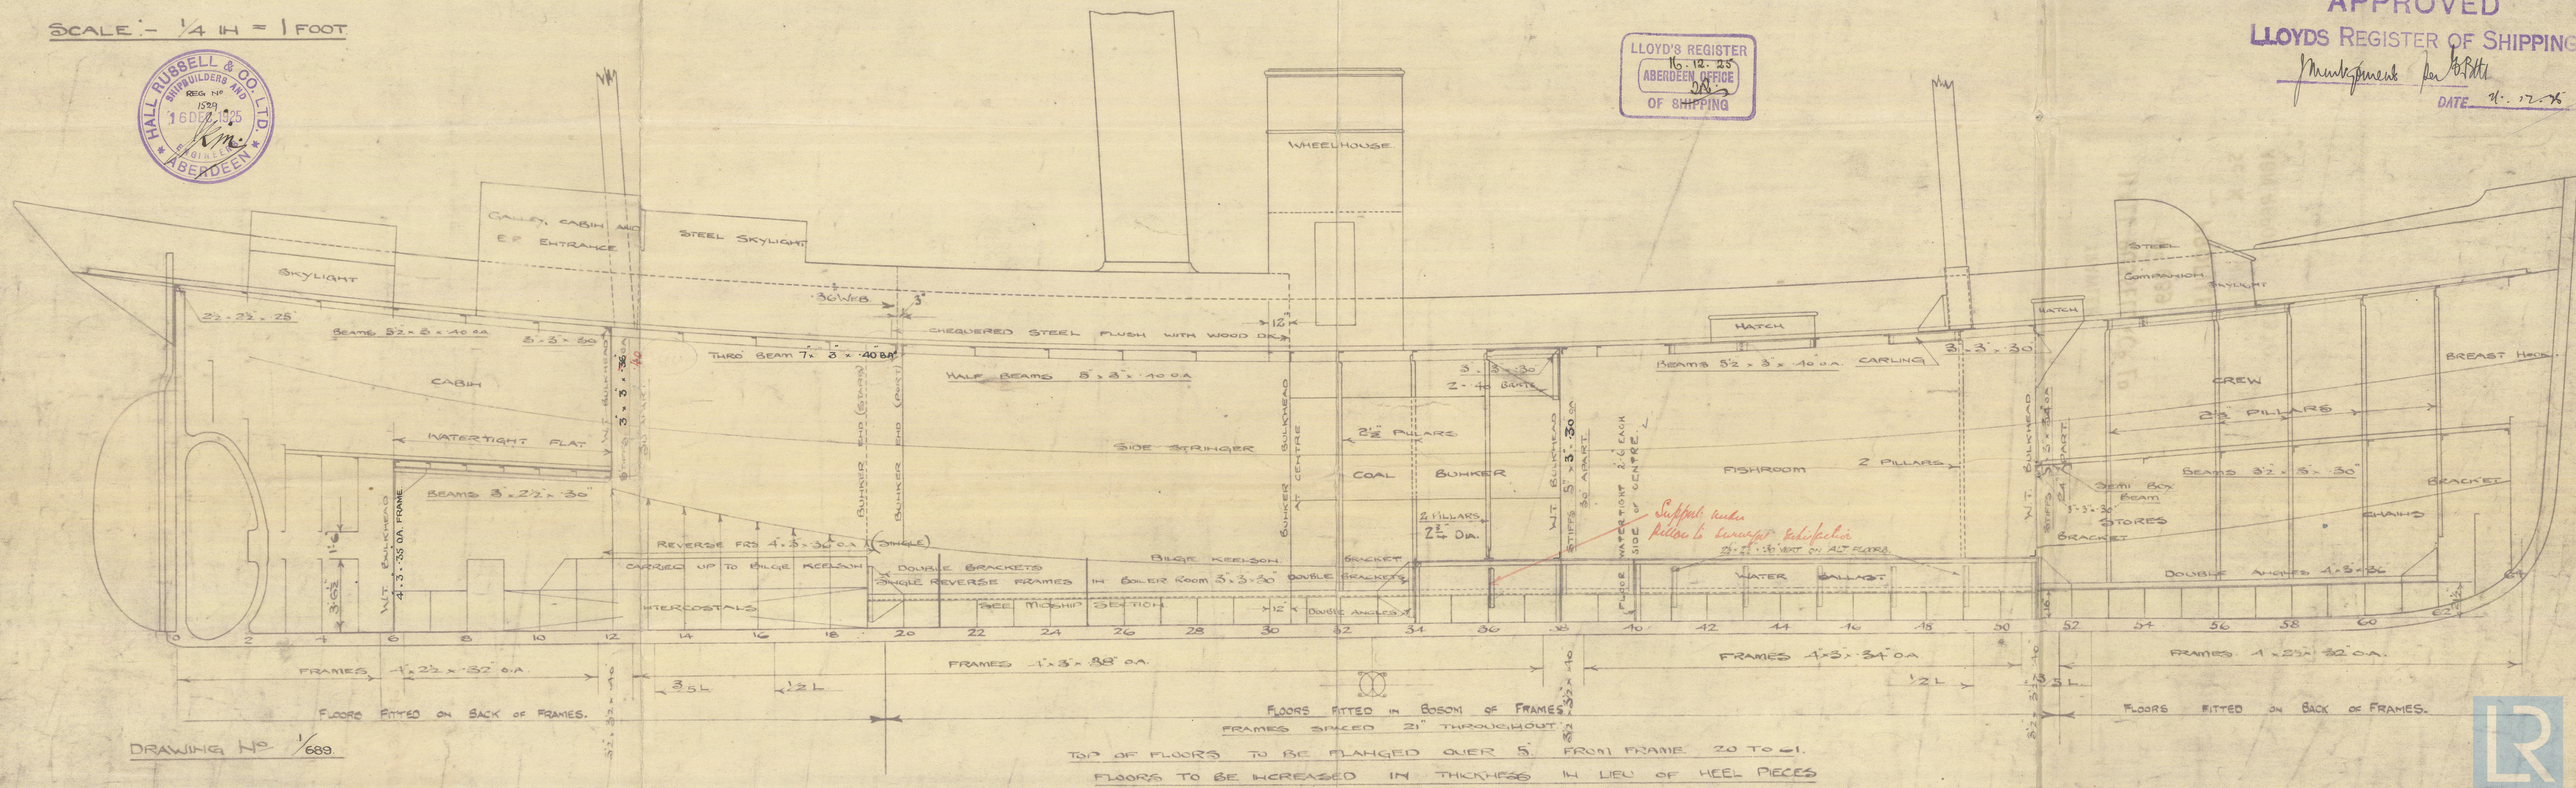

DRAWING No 1/689.

FLOORS FITTED IN BOSOM OF FRAMES.  
FRAMES SPACED 21" THROUGHOUT.  
TOP OF FLOORS TO BE FLANGED OVER 5" FROM FRAME 20 TO 61.  
FLOORS TO BE INCREASED IN THICKNESS IN LIEU OF HEEL PIECES



TRAWLER.


HALL RUSSELL + C<sup>o</sup> L<sup>d</sup>.

N<sup>o</sup> 689.

PROFILE.

Sc. K. "ARUM"

ABN. REPORT. 14370.

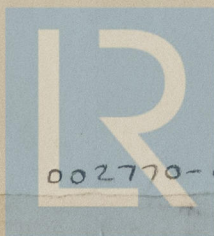

© 2020

002770-002783-0214

Lloyd's Register  
Foundation