


PLAN No. 6445
FOR ENCLOSURE TO
Messrs. Lloyd's Register
FROM
DATE 14.3.16

PILLARING THROUGHOUT TO SURVEYORS SATISFACTION.

PROFILE AND DECK
STEEL SCREW TRAWLER
TO CLASS 100 A1 AT LLOYDS
No 674
DIM'S 135' 0" B.P. x 23' 6" EXT x 13' 0" MLD.
SCALE 1/2" = 1 FOOT.


PITCH PINE MAIN MAST
SUPPORTED TO SURVEYORS
SATISFACTION

WINLASS ON TOP OF WHALEBACK
PLATING INCREASED IN THICKNESS
UNDER SAME.

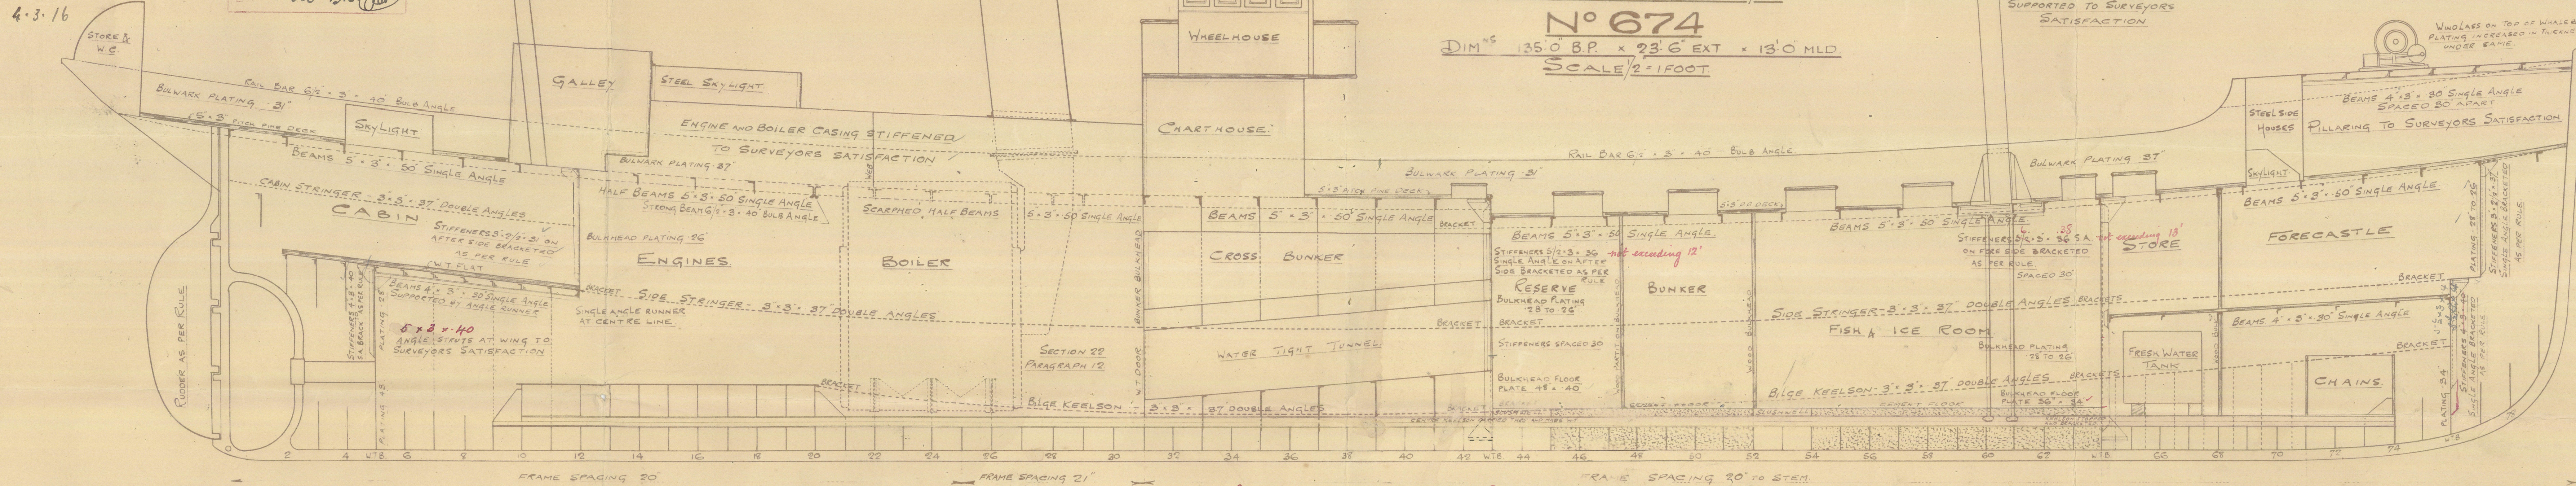

Pillaring throughout to Surveyors satisfaction.


4.5.16.

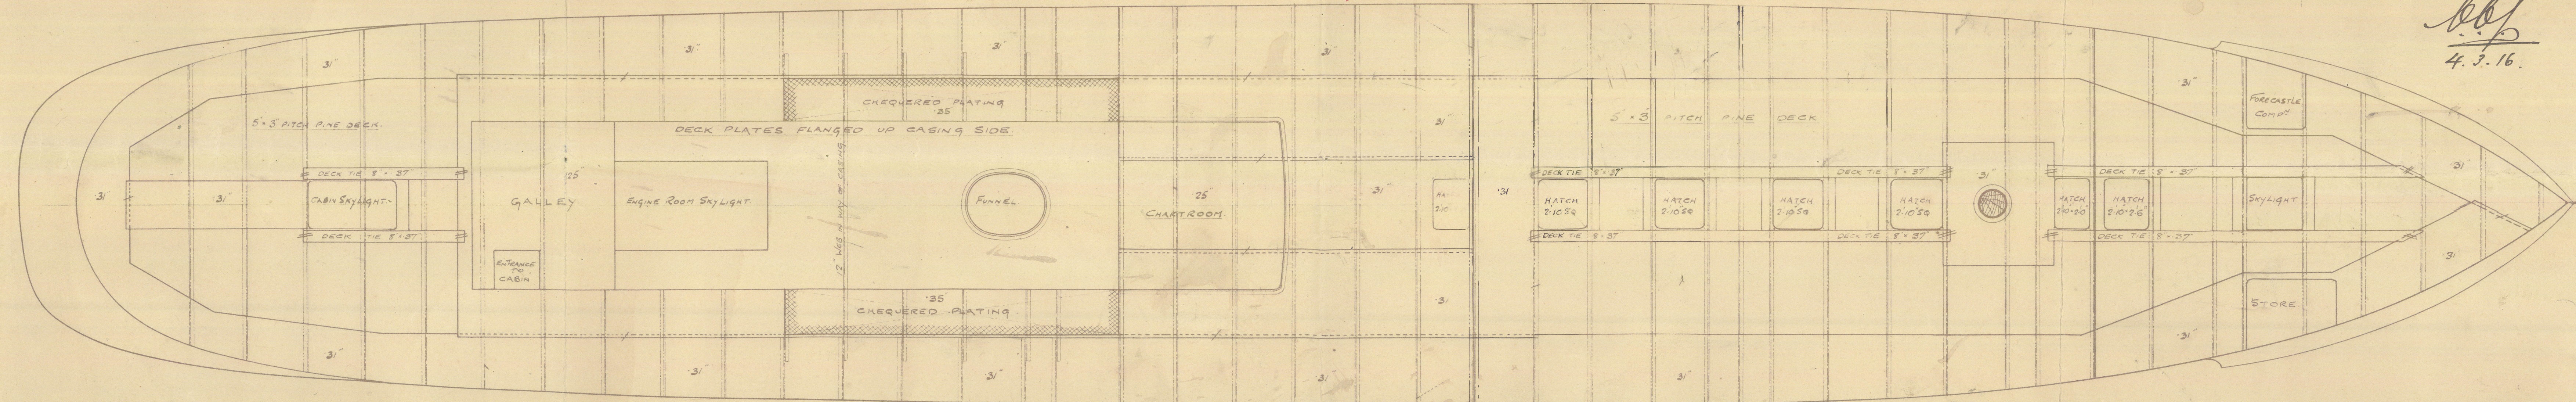

Profile & Deck

Cochranes No 74.

$\frac{3}{4}$ O kino
Hull Rpt No 30,006.

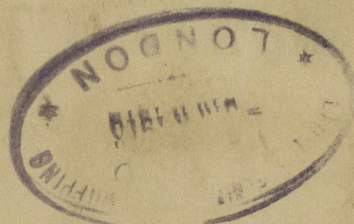

© 2020

Lloyd's Register
Foundation

002770-002783-0318