





3879.99

6508.00

002784-002789-0147



© 2020

Lloyd's Register  
Foundation



53.75  
26.87

7  
7  
Q  
No



© 2020

Lloyd's Register  
Foundation



SUNDERLAND



Messrs Wm Doxford & Sons

MIDSHIP SECTION  
(AS BUILT)

No 544

P.P. "SYDLAND"

SUNDERLAND RPT. No. 27910

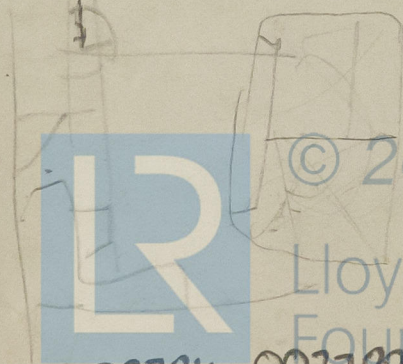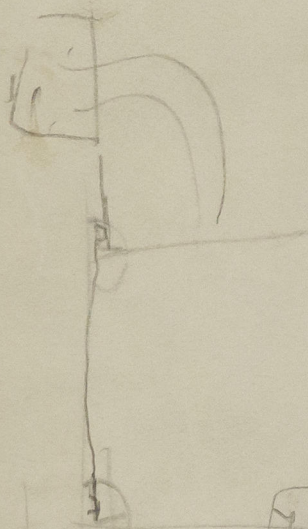

© 2020

Lloyd's Register  
Foundation

002784-002789-0147