


OFFICE
M.V. "FIXITY" (EX EMPIRE FAIRHAVEN)
MIDSHIP SECTION.


SCALE :- 3/4" = 1 FOOT.

DIMENSIONS :- 141'-0" BP * 27'-0" MLD * 11'-0" MLD.

DRAUGHT :- 10'-0"

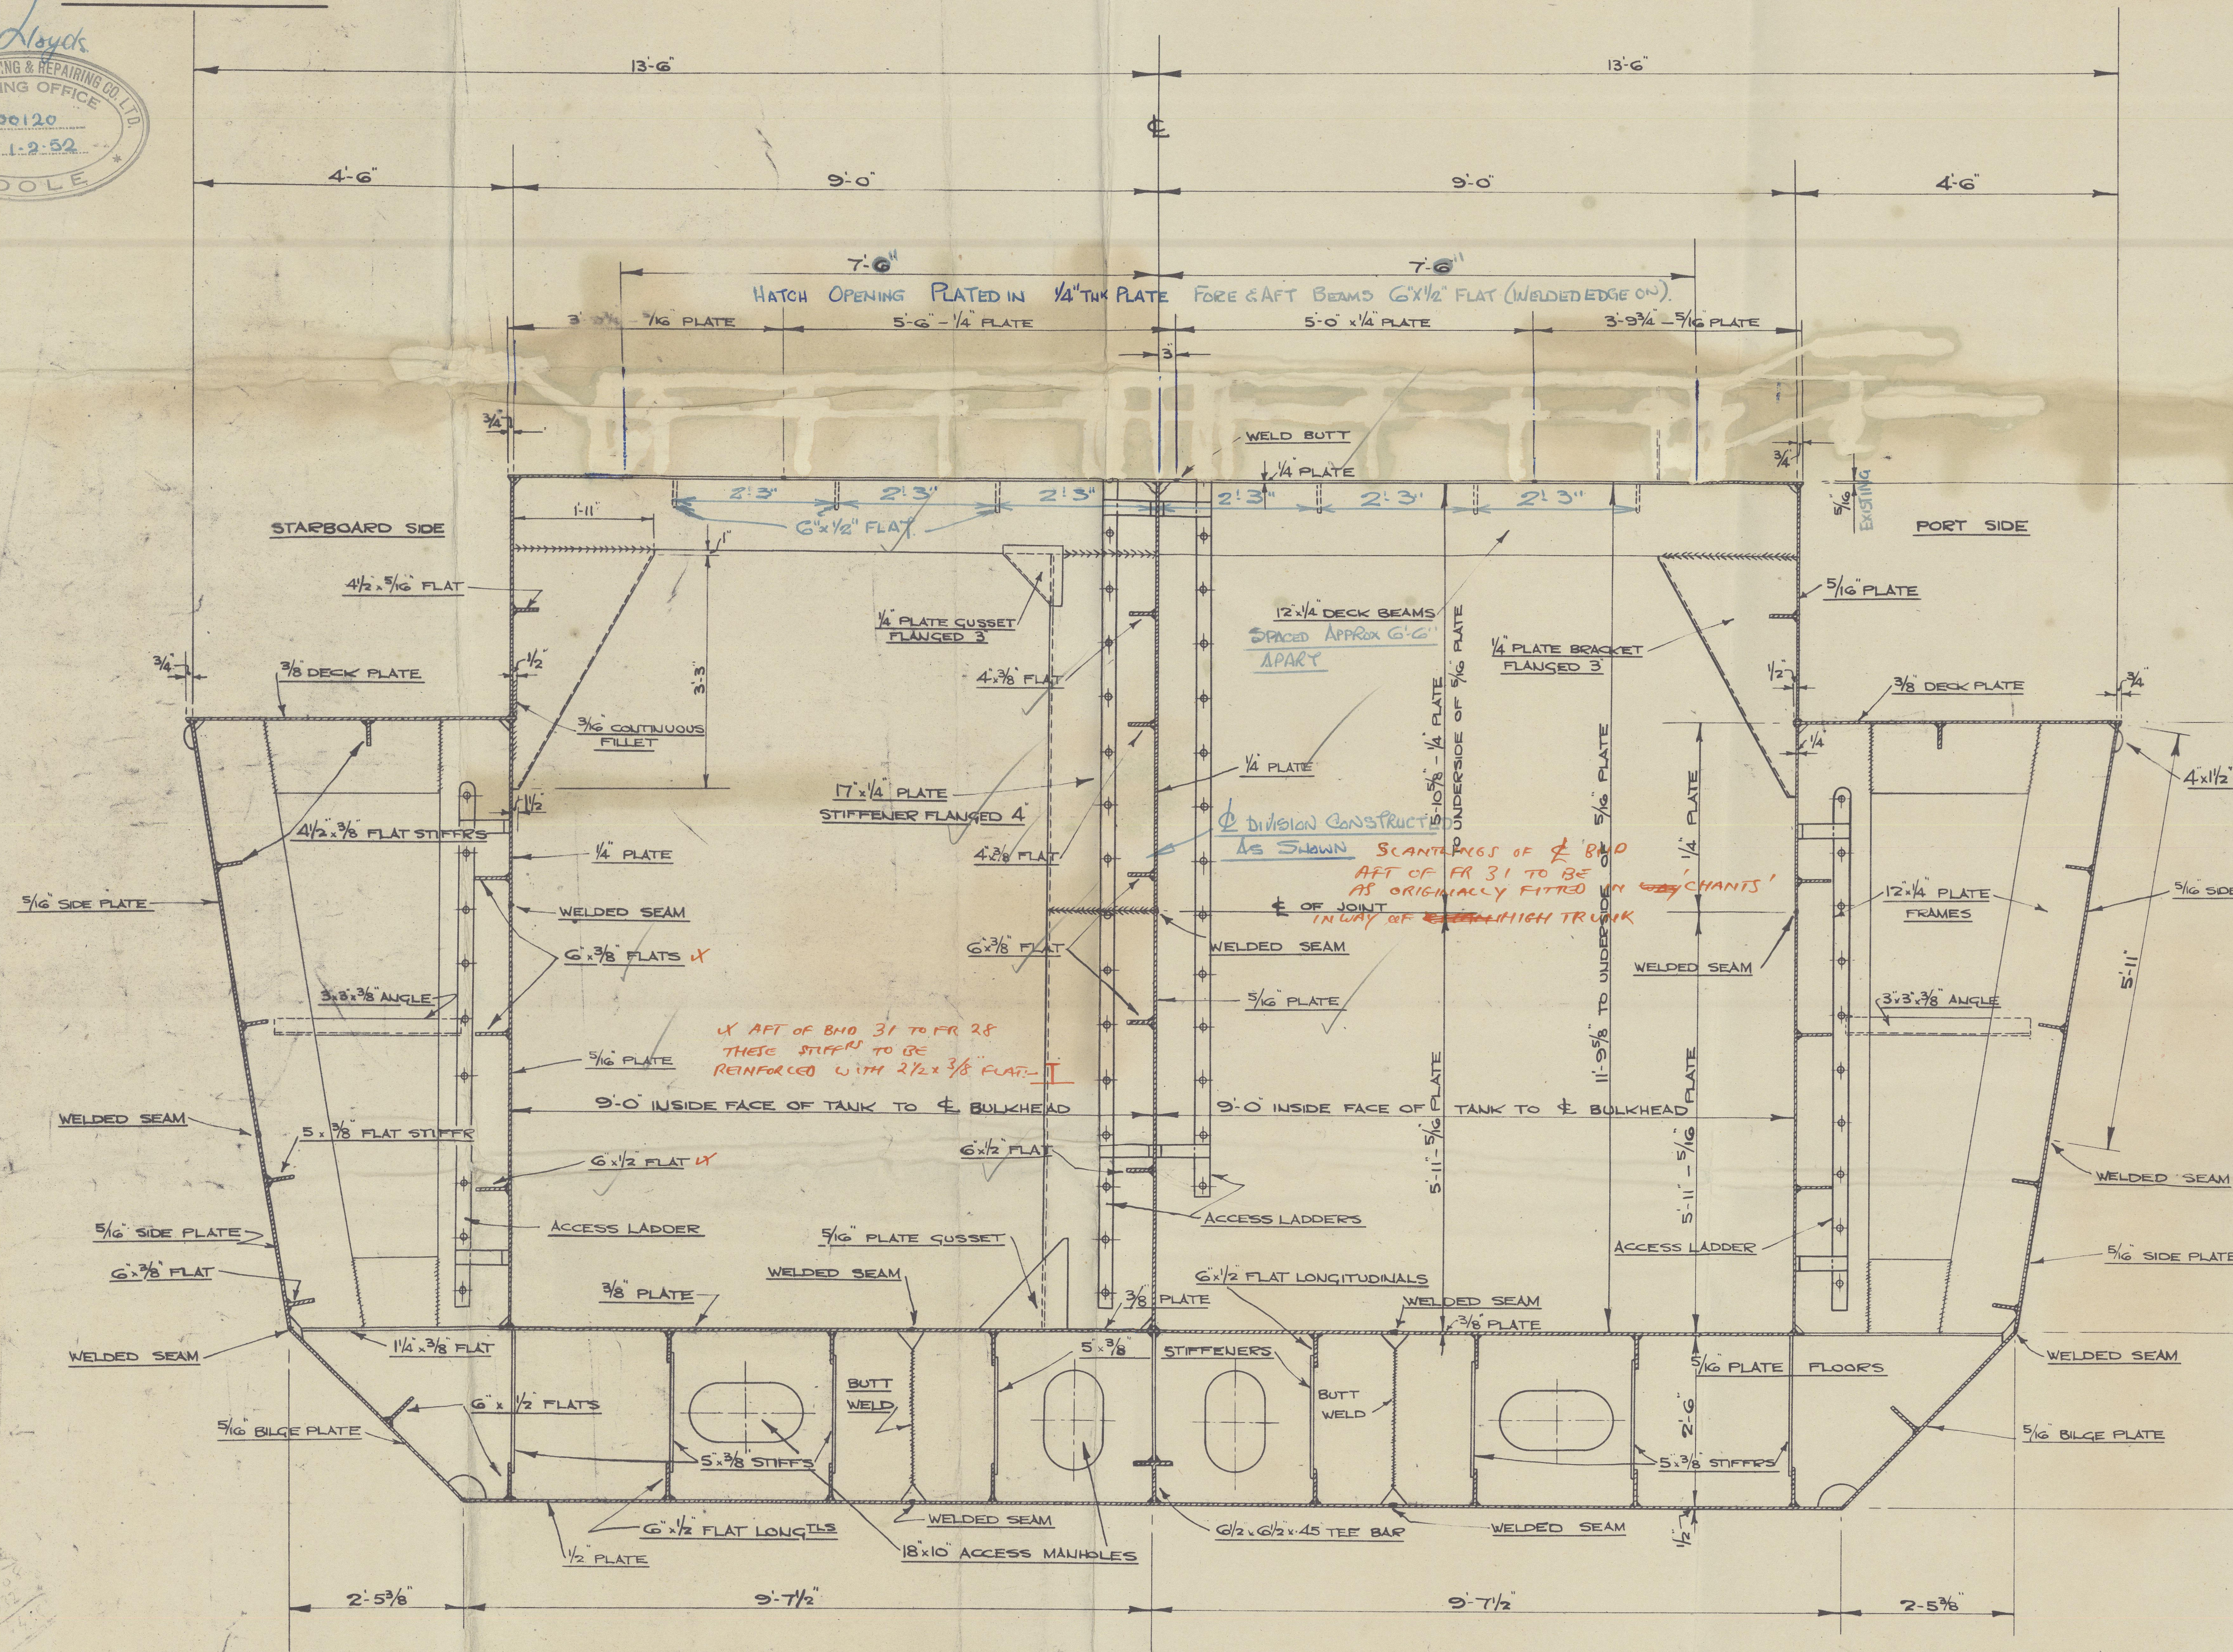

MIDSHIP FRAME

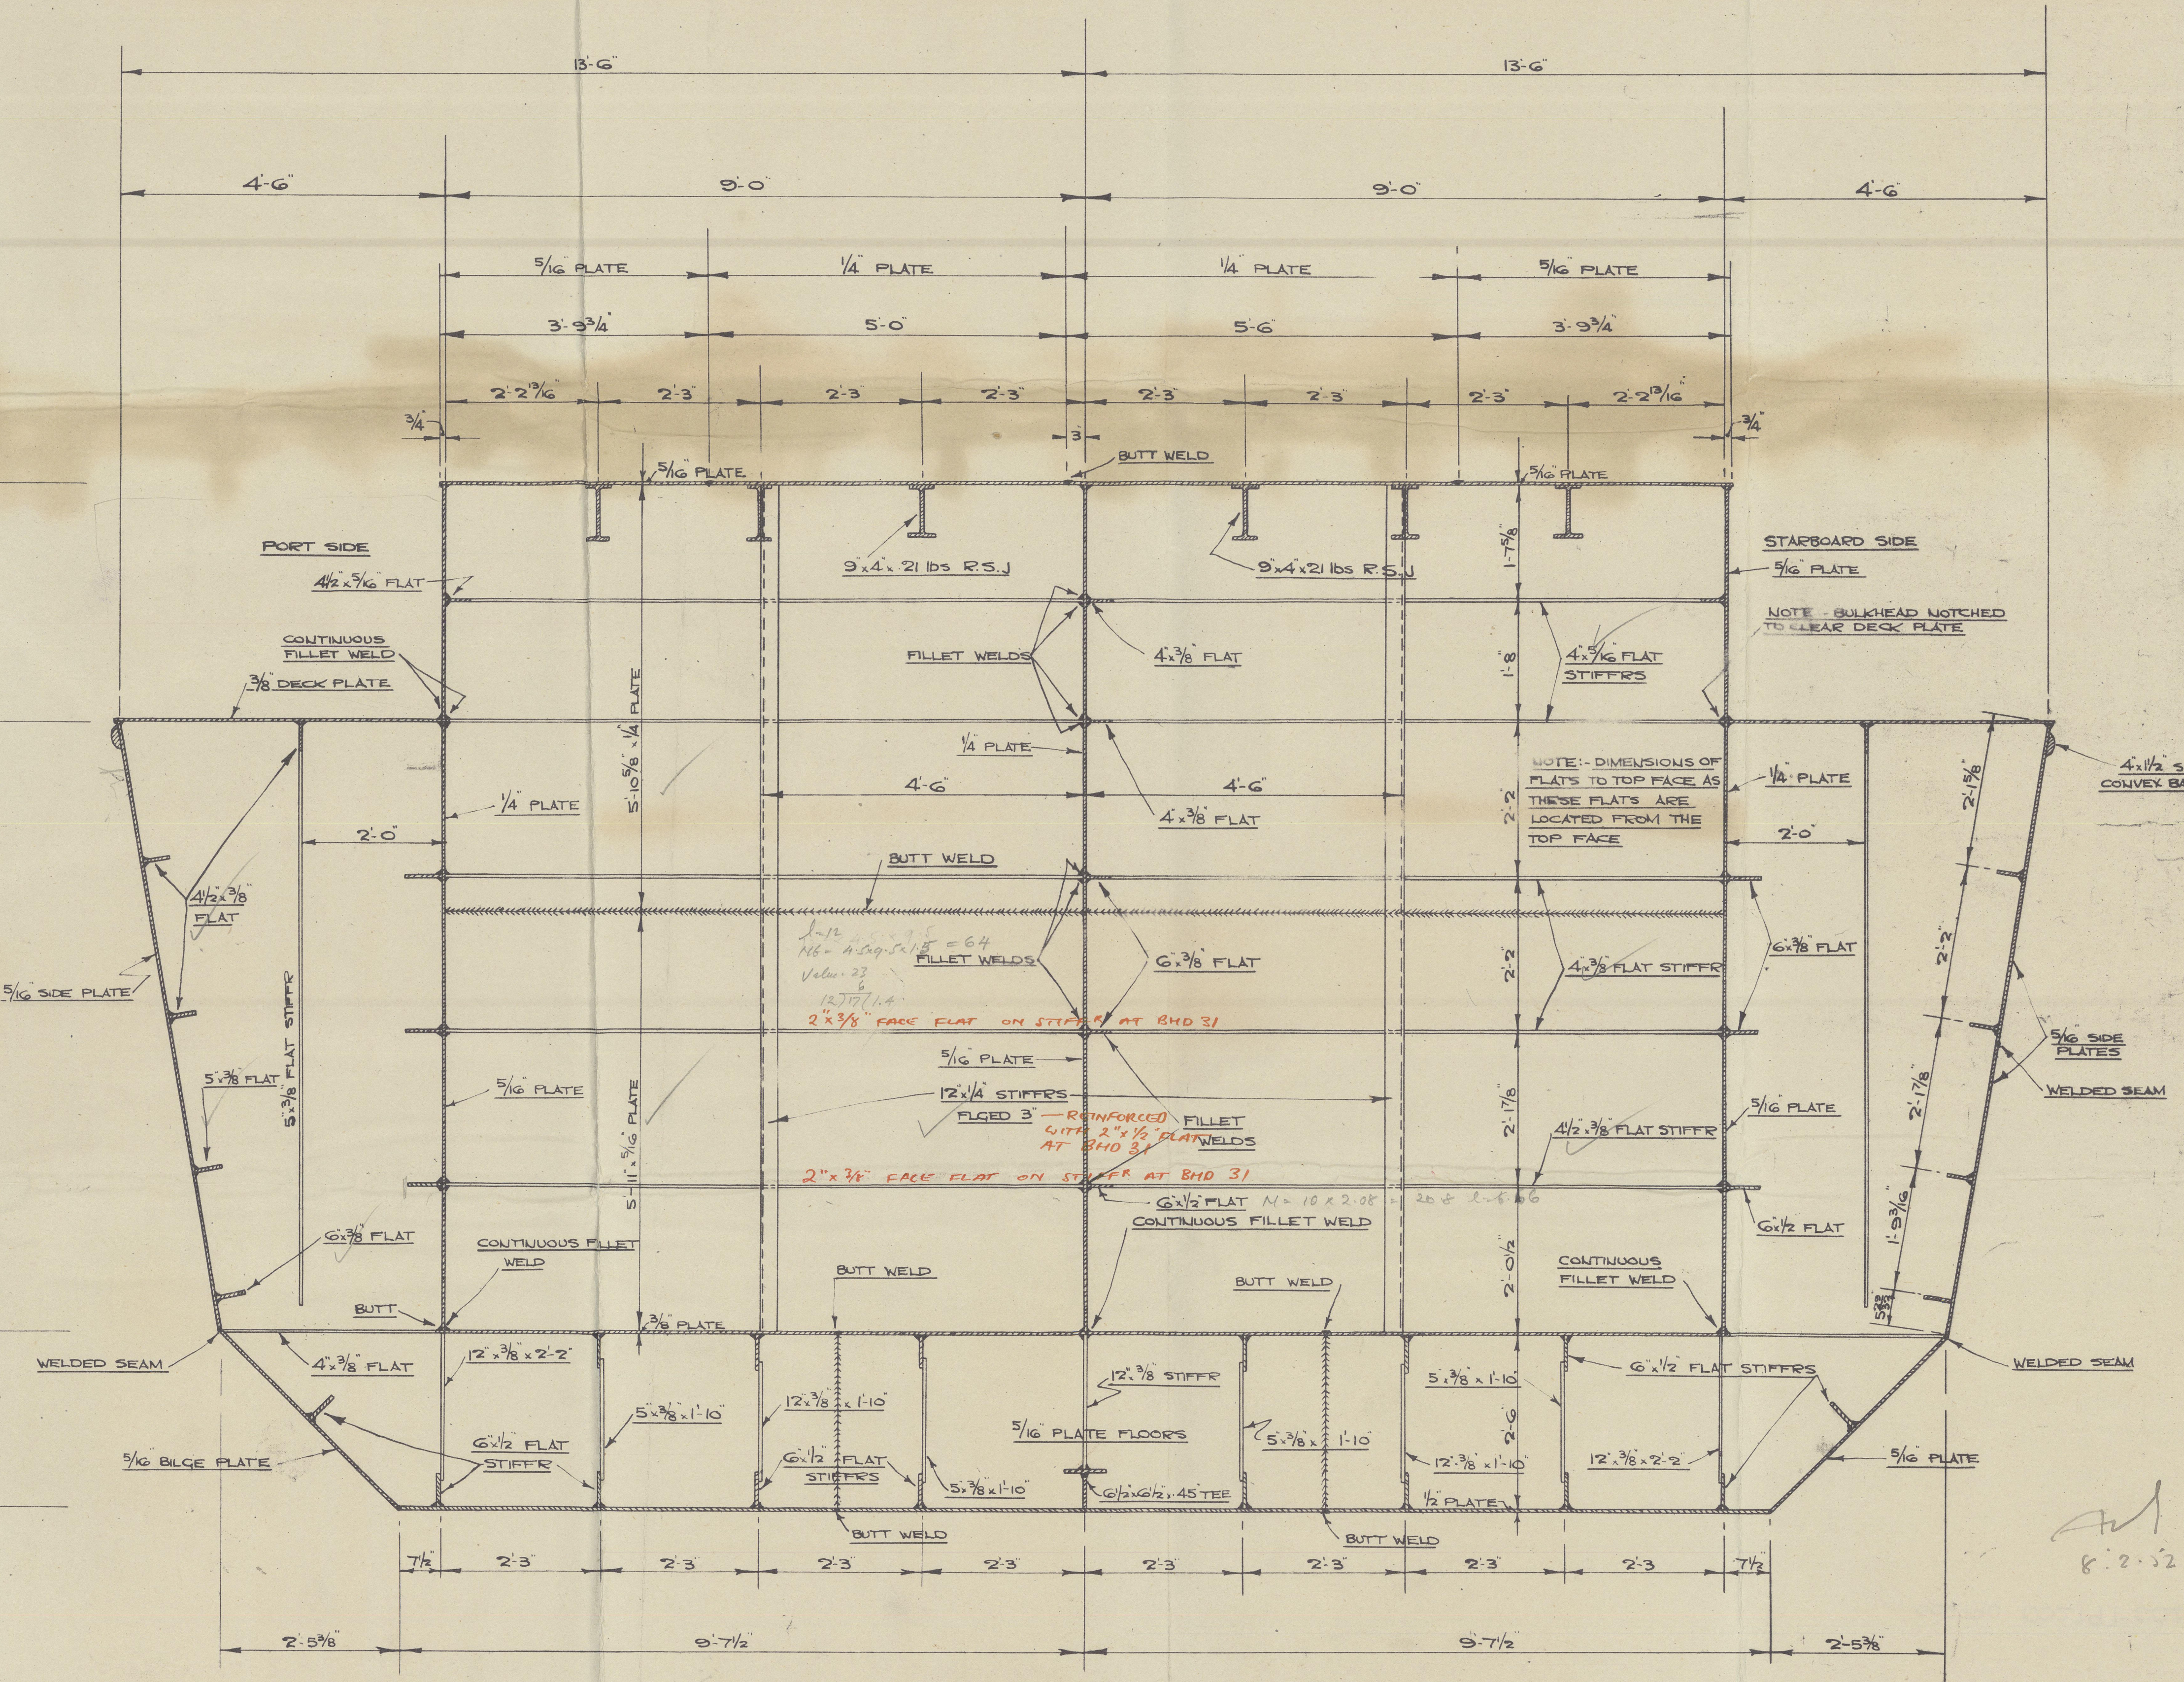

NEW MIDSHIP BULKHEAD FR 34

ALSO EXISTING BULKHEAD FR 31 WITH REINFORCEMENTS AS INDICATED.

YARD No.

GOOLE SHIPBUILDING & REPAIRING CO. LTD.
GOOLE
YORKS



002790-002797-0027



© 2020

Lloyd's Register
Foundation