


30 DEC 1941 (Yard no. 655)

③

DIMENSIONS 445'-0" BP. x 65'-3" BM. x 38'-2 1/2" DM AT MID LENGTH (TO UPPER DK)

SCALE $\frac{1}{8}'' = 1$ FOOT

FOR DETAILS OF BOAT DECK ETC. SEE SEPARATE PLAN OF SUPERSTRUCTURES.

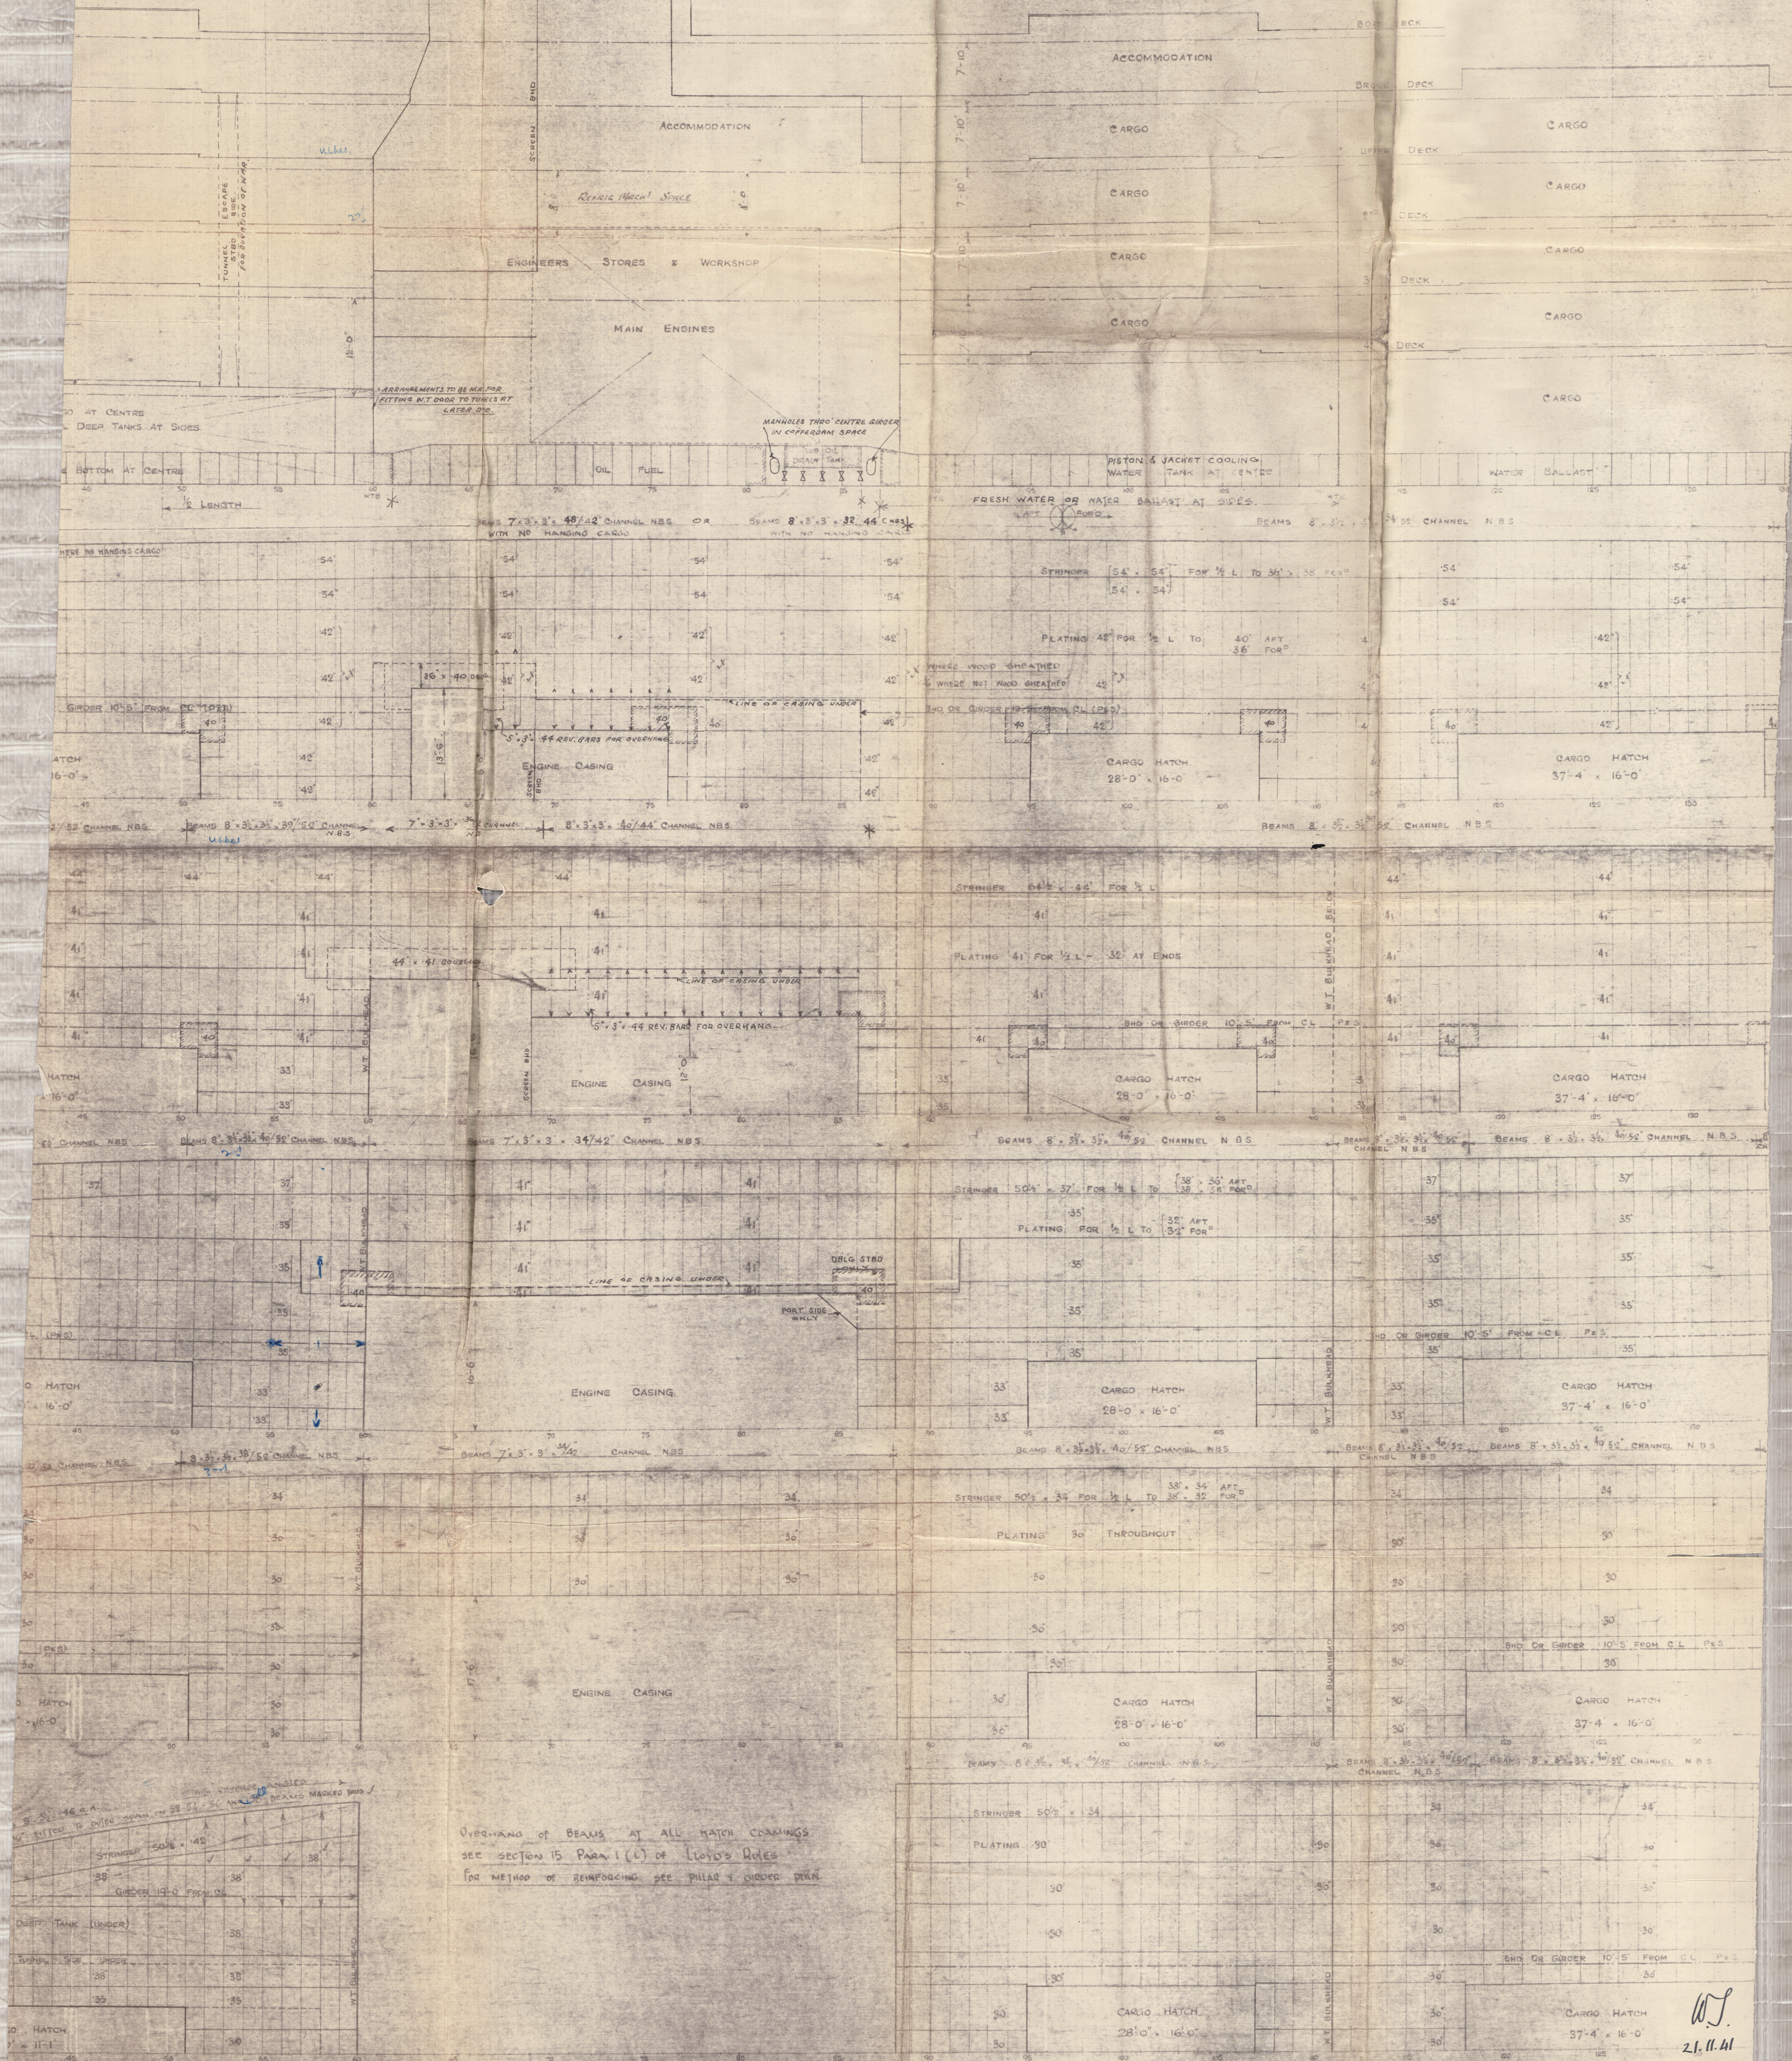

W.J.
21.11.4

Profile & Decks

002790-002797-0035



© 2020

Lloyd's Register
Foundation

R. & W, HAWTHORN, LESLIE
& CO. LTD.

SHIP No. 653 ✓

M/M. 2792

24/ ENGINE No. N/N "ABBEE WOOD"


~~Ex~~

M.V. "RIPPINGHAM GRANGE"

NEWCASTLE ON TYNE. (ABBEE
WOOD)

Report No. 101646

Profile and Deck.

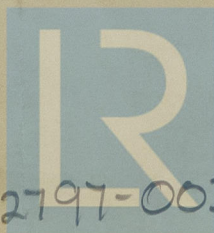

© 2020

Lloyd's Register
Foundation

002790-002797-0035