


Lloyd's Register of Shipping.

SURVEYS FOR FREEBOARD.

(CONDITIONS OF ASSIGNMENT.)

Ship's Name RIPPIUGHAM GRANGE Port of Survey NEWCASTLE-ON-TYNE.
 Official Number 169564 Surveyor's Signature [Signature]
 Nationality and Port of Registry BRITISH. London Date of Survey DURING CONSTRUCTION.

Disposition and dimensions of superstructures, trunks, deckhouses and machinery casings to be inserted in the diagrams and tabular statement :-

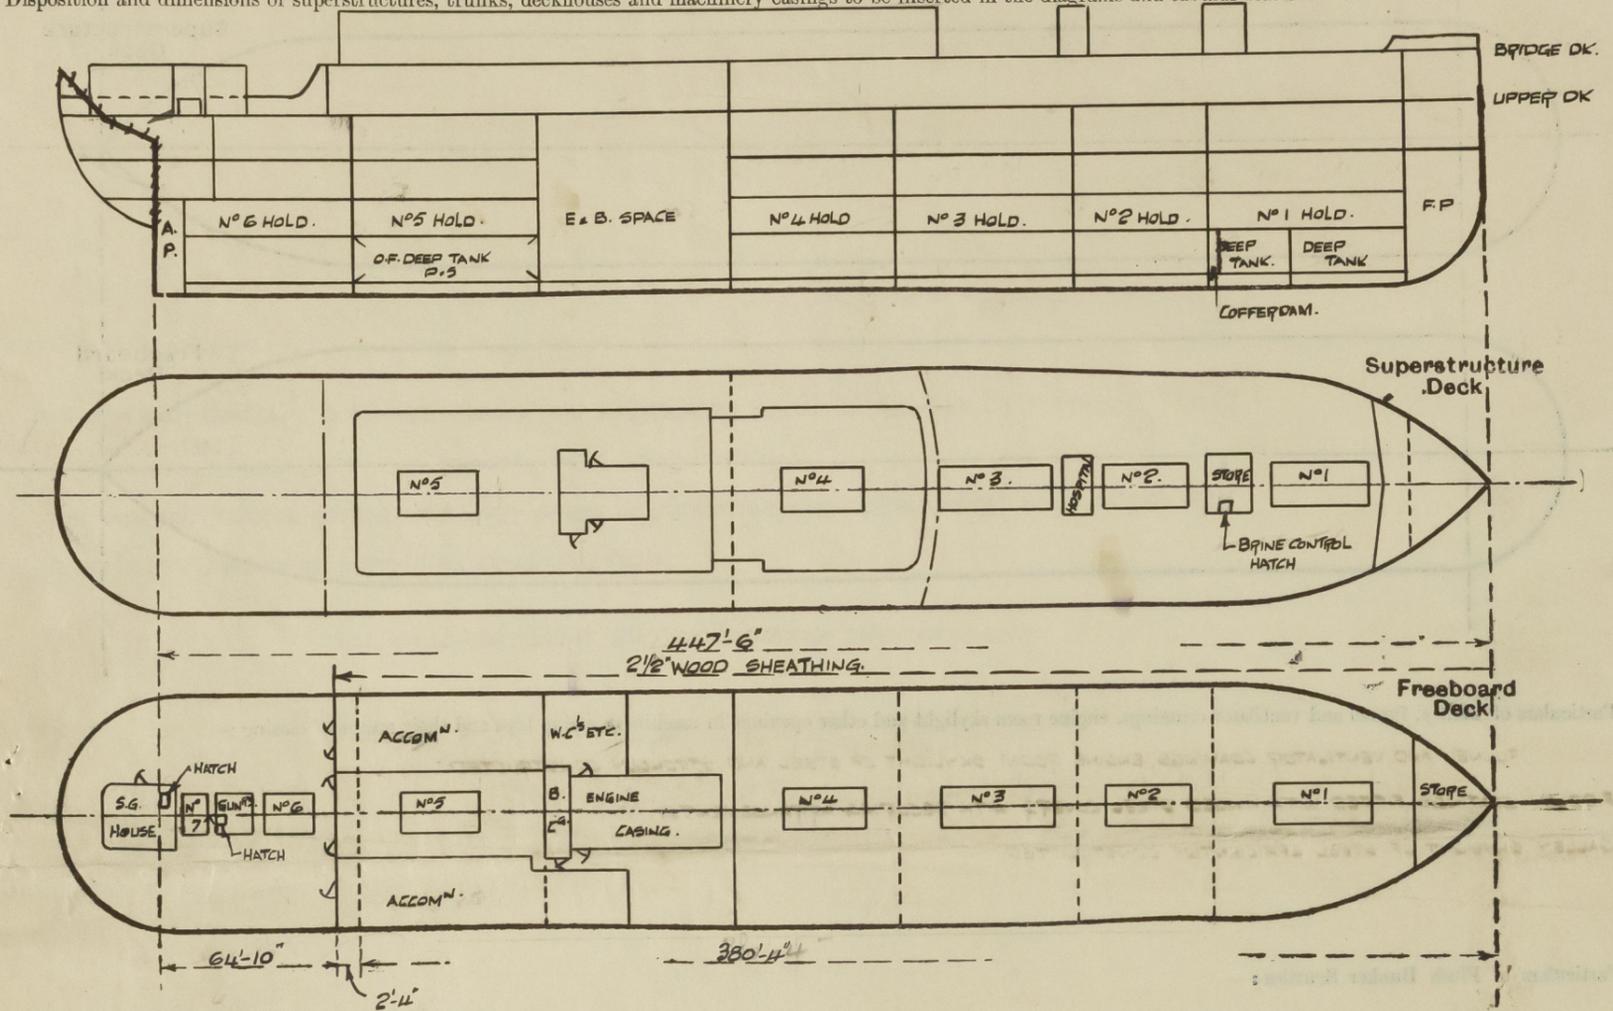

Particulars of Superstructures, Trunks, Casings, Deckhouses.

	Coaming	Plating	Stiffeners	Spacing	End Attachments of Stiffeners	Size of Openings	Height of Sills	Height of Casings
Poop Bulkhead ...	✓							
Raised Quarter Deck Bulkhead ...	✓							
Bridge, After Bulkhead ...	4'-0"	30	4" x 3" x .34	2'-9" APPROX.	NONE	3 @ 5'-0" x 2'-2" 2 @ 5'-0" x 2'-0"	18" 18"	7'-10"
Bridge, Forward Bulkhead ...								
Forecastle Bulkhead ...	✓							
Trunk, Aft ...	✓							
Trunk, Forward ...	✓							
Exposed Machinery Casings on Freeboard or Raised Quarter Decks ...	✓							
Exposed Machinery Casings on Superstructure Decks ...	✓							
Machinery Casings within Superstructures not fitted with Class I Closing Appliances ...								
Deckhouses on Flush Deck Ships ...	2'-0"	26	3" x 2 1/2" x .40	2'-4"	NONE	5'-6" x 1'-9" P&S 5'-6" x 2'-0" SS.	12"	7'-10"

Particulars of Closing Appliances (state if capable of being manipulated from both sides).

Poop Bulkhead ...	✓
Raised Quarter Deck Bulkhead ...	✓
Bridge, After Bulkhead ...	5 HINGED STEEL DOORS CAPABLE OF BEING MANIPULATED FROM BOTH SIDES. ✓
Bridge, Forward Bulkhead ...	✓
Forecastle Bulkhead ...	✓
Exposed Machinery Casings on Freeboard or Raised Quarter Decks ...	✓
Exposed Machinery Casings on Superstructure Decks ...	✓
Machinery Casings within Superstructures not fitted with Class I Closing Appliances ...	
Deckhouses on Flush Deck Ships ...	3 HINGED STEEL DOORS CAPABLE OF BEING MANIPULATED FROM BOTH SIDES. ✓

