

S.S. "J. B. KEE."
(EX. "MONAS BELLE.")

N^o 131. Stoomvachtboot.

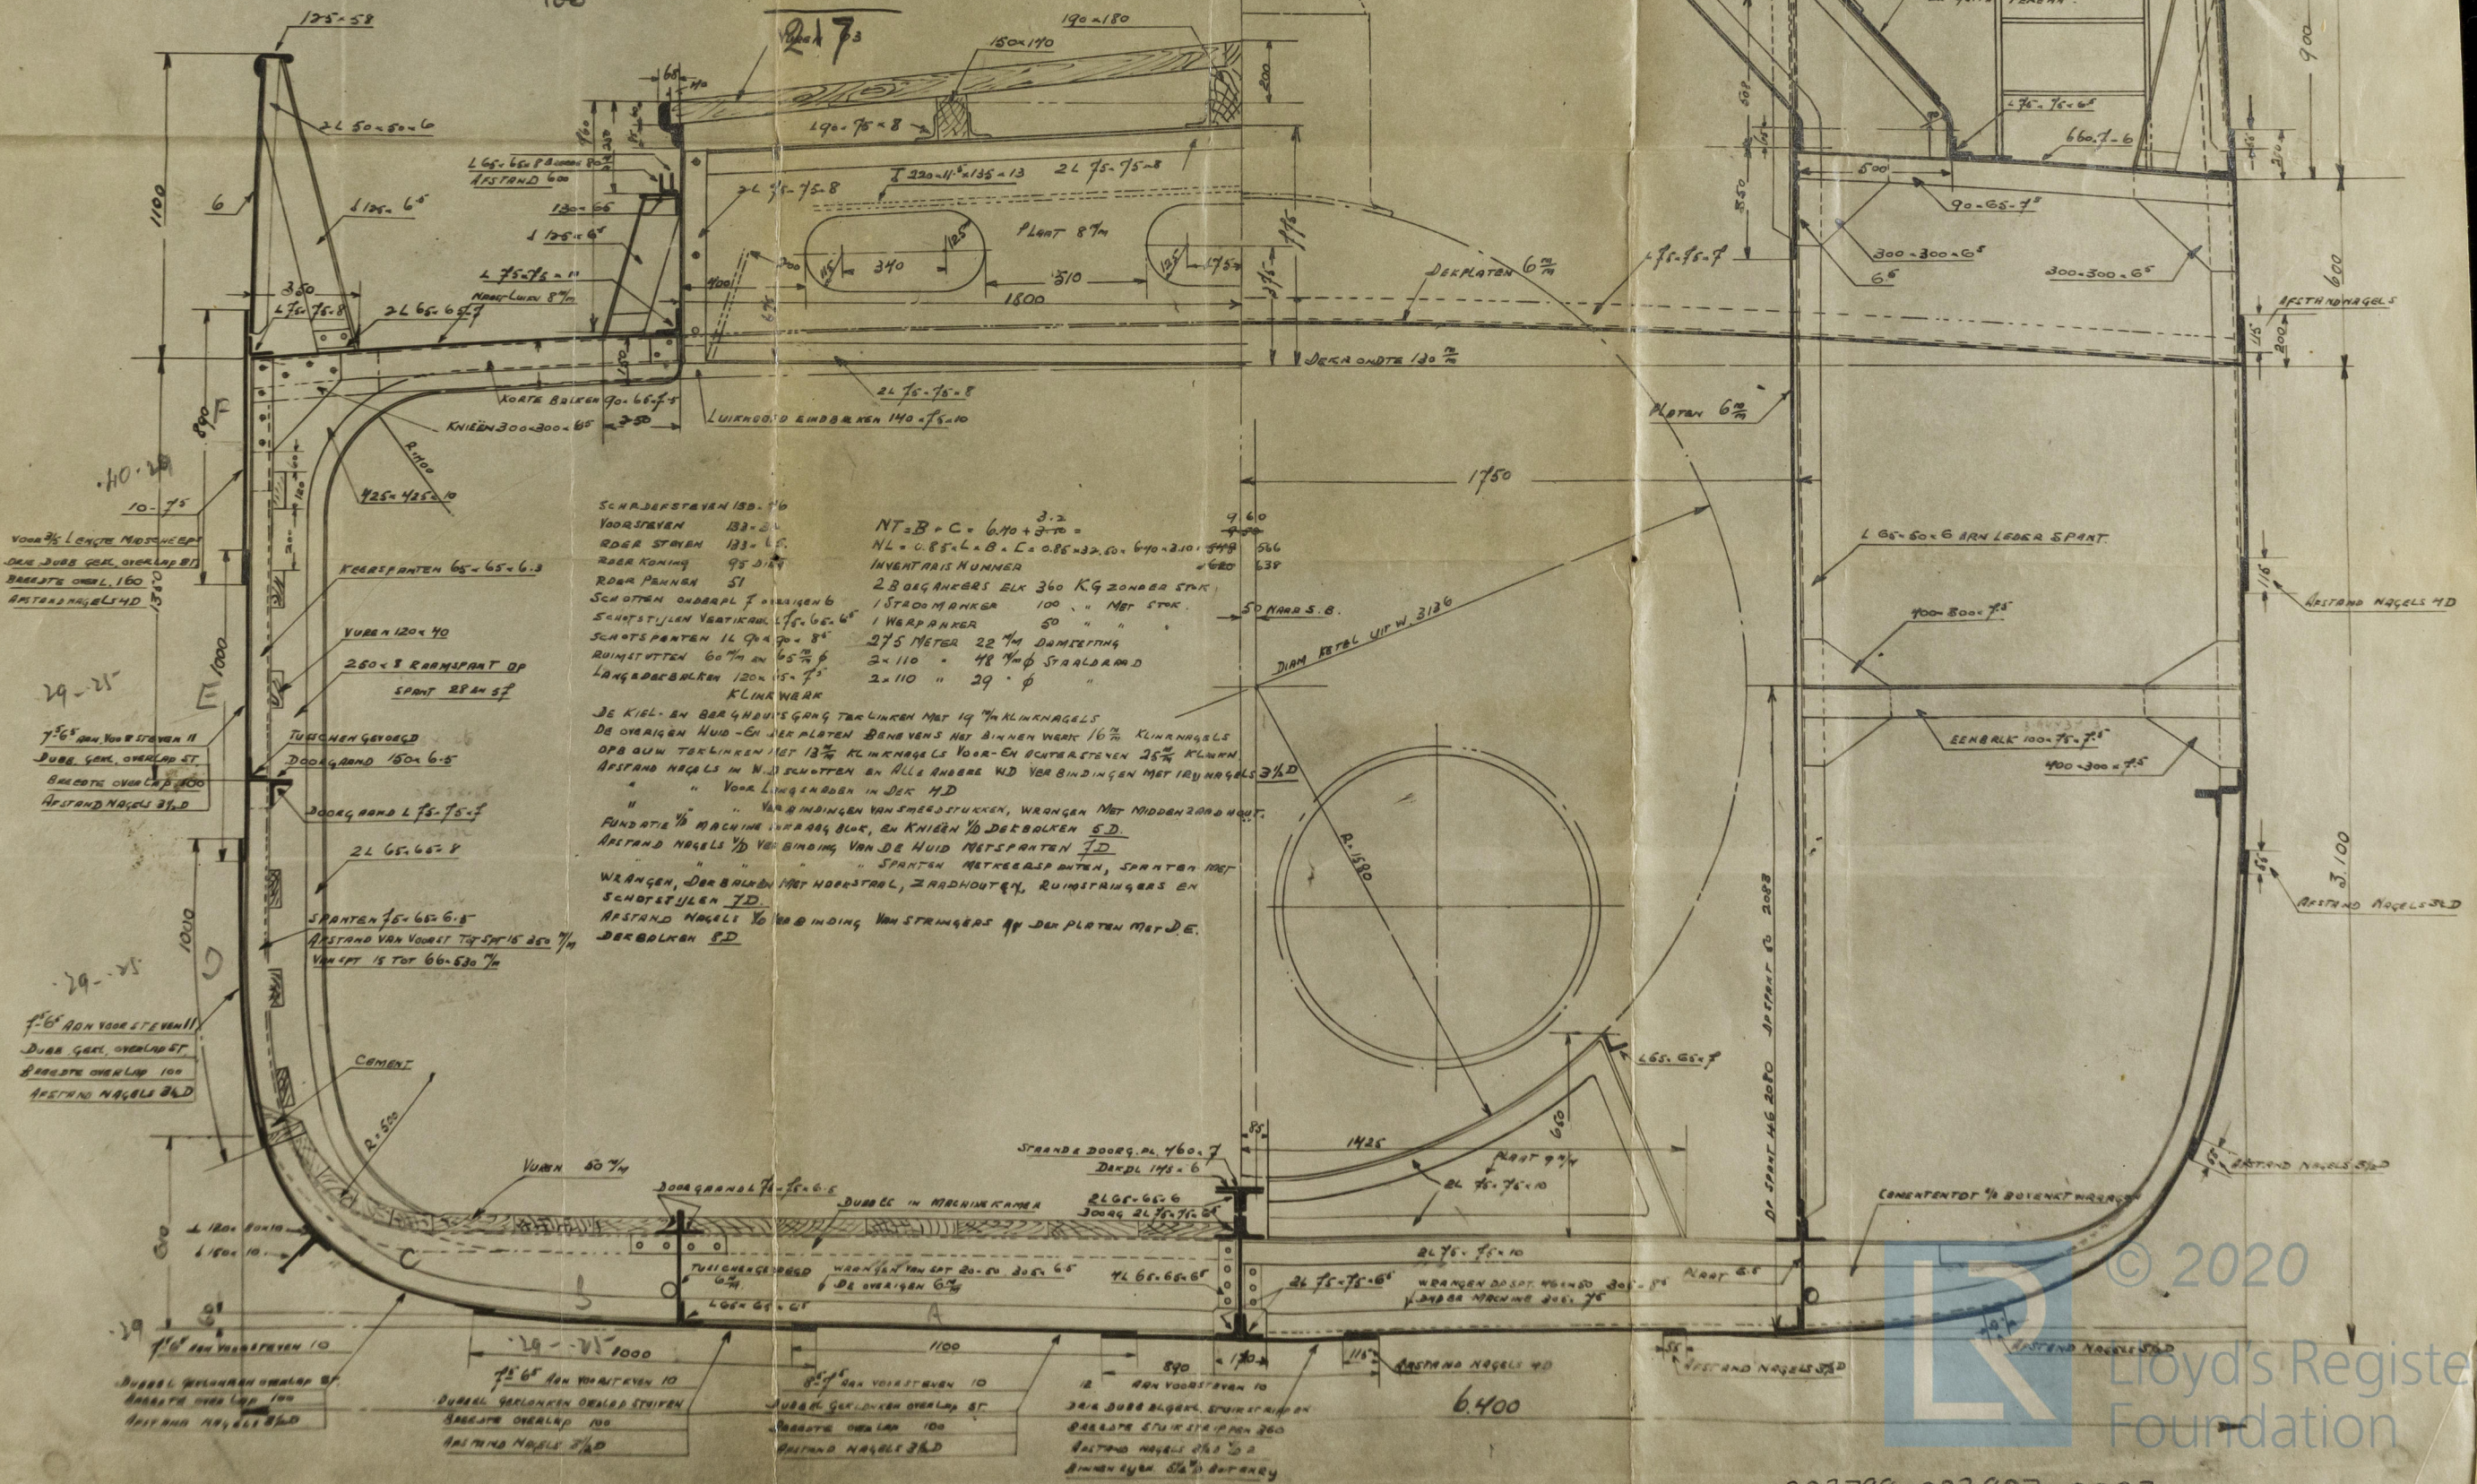
Dwaars door nede
Schaalsas.

Bureau Veritas $\pm 1 \frac{3}{8}$ G. 11. P. R. Staal

Langte trossen de boadlyven	32.50	Meters.
Breidte op bintenkanst spanten	6.40	"
Holte iet dek in de zyde	7.50 3.20	-

C. N^o

19/10/44 $\frac{106.66 \times 21.0 \times 10.5 \times .75}{100} = 176$

$$\frac{39.0 \times 21.0 \times 2.0 \times .75}{100} = 12.$$
$$\frac{11 \times 21 \times 9.0 \times .50}{100} = 10$$
$$\frac{15 \times 21 \times 6.0 \times .50}{1000} = 10$$
$$\frac{32 \times 11 \times 7.0 \times .375}{100} = \underline{\underline{9}}$$


1 OCT 1936

002798-002807-0002



1/ 40890
40890

Midship Section.

S/S J.B. KEE ★

1.10.36

Cy Rpt 77558

Return to 15 Blythwood St
Glasgow

002798-002807-0002

Midship Section
S/S J.B. KEE



© 2020
Lloyd's Register
Foundation