


MIDSHIP SECTION
S.S.N^{OS} 223 & 4

SCALE $\frac{1}{2}'' = 1$ FOOT.

LENGTH B.P.-----240'-0"

BREADTH EXT: ---36'-6"

DEPTH MLP ----- 19' 0"

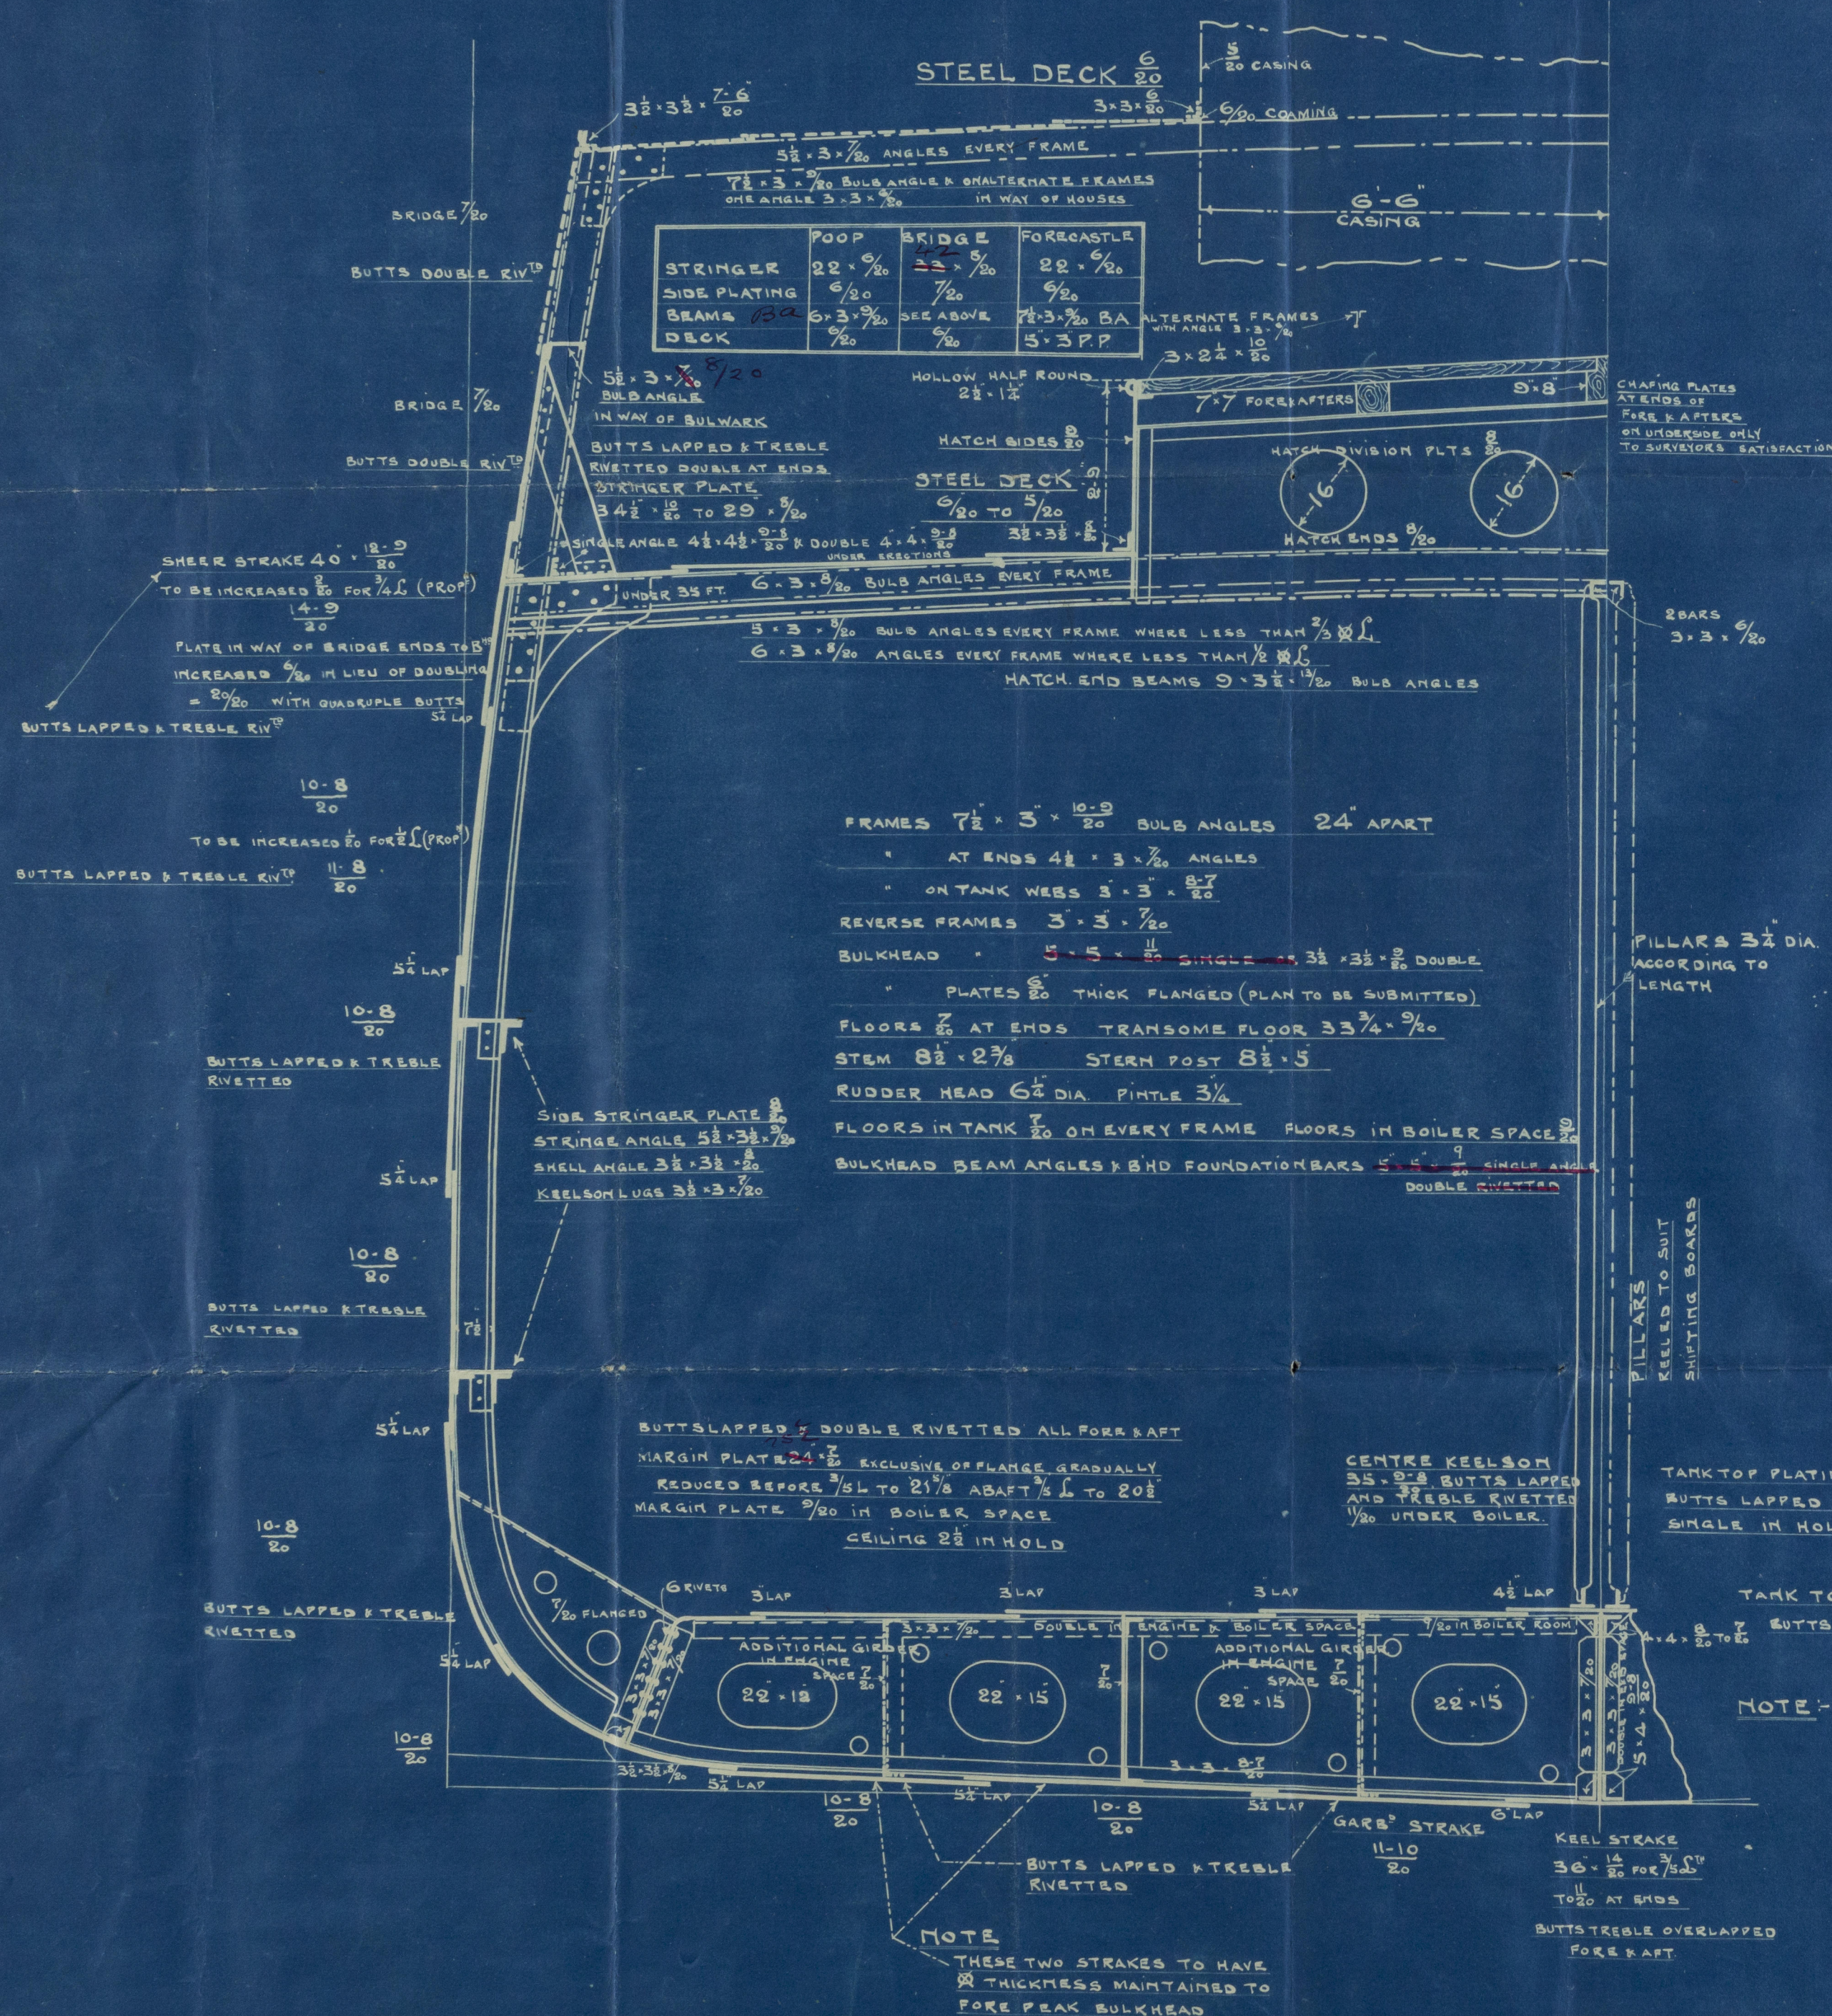

NUMERALS

$\frac{1}{2}$ GIRTH ----- 34.92
 $\frac{1}{2}$ BREADTH ----- 18.16
 DEPTH AS PER RULE 19.75

72.83 = FRAME NUMBER

238.6 = LTH. AS PER RULE

17377.3 = PLATING NUMBER

ERECTIONS

POOF-----18.0
BRIDGE-----62.0
FORECASTLE-----32.0

238.6	112.00	47
HOUSES	40	
	152	64

EQUIPMENT NO.

8/17377
2172
64
1390
~~17377~~
18767 Equip

See Equipment
List submitted
11-1-04

NOTE:-

TANK FRAMES DOUBLED FROM MARGIN PLATE
TO MARGIN PLATE FROM $\frac{3}{5}L$ FORWARD TO
COLLISION BULKHEAD

NOTE:- BEFORE $\frac{3}{8}$ IN. THE RIVETS IN THE LANDING EDGES OF THE STRAKES FORMING THE FLAT OF THE BOTTOM TO BE SPACED NOT MORE THAN 4 DIAS APART THE RIVETS IN THE PLATING & FRAMES IN WAY OF SAME TO BE SPACED NOT MORE THAN $5\frac{1}{2}$ DIAS APART.

AND IN BRK TALKS SHELL RIVETS 6 DIA C TO C



Ally



© 2020

Lloyd's Register
Foundation

002798-002807-0191

Sunderland
S B Co

No 224

SS "Skjold"

~~Ø~~ Section

Sld. F. E. No 21832



NW
alex



2020
sister vessel to
S.L. Tager
Sld 21797

Lloyd's Register
Foundation