

11.7.13

PLAN No. 4123
FOR ENCLOSURE TO
Kessan & Lloyd's Surveyors
Hull FROM
GUTHRIE & SONS, LTD.
MARINE DEPT. SELBY
27/3/14


MIDSHIP SECTION STEEL SCREW TRAWLERS

N^{os} 586-595-6

DIMENSIONS: 136'-8" B.P. x 23'-3" EXT. x 13'-0" MLD.

SCALE 1/2 INCH.

TO CLASS 100 A.I. STEAM TRAWLER.
DECK PLATED OVER IN WAY OF MACHINERY
CASING AS PREVIOUSLY APPROVED.

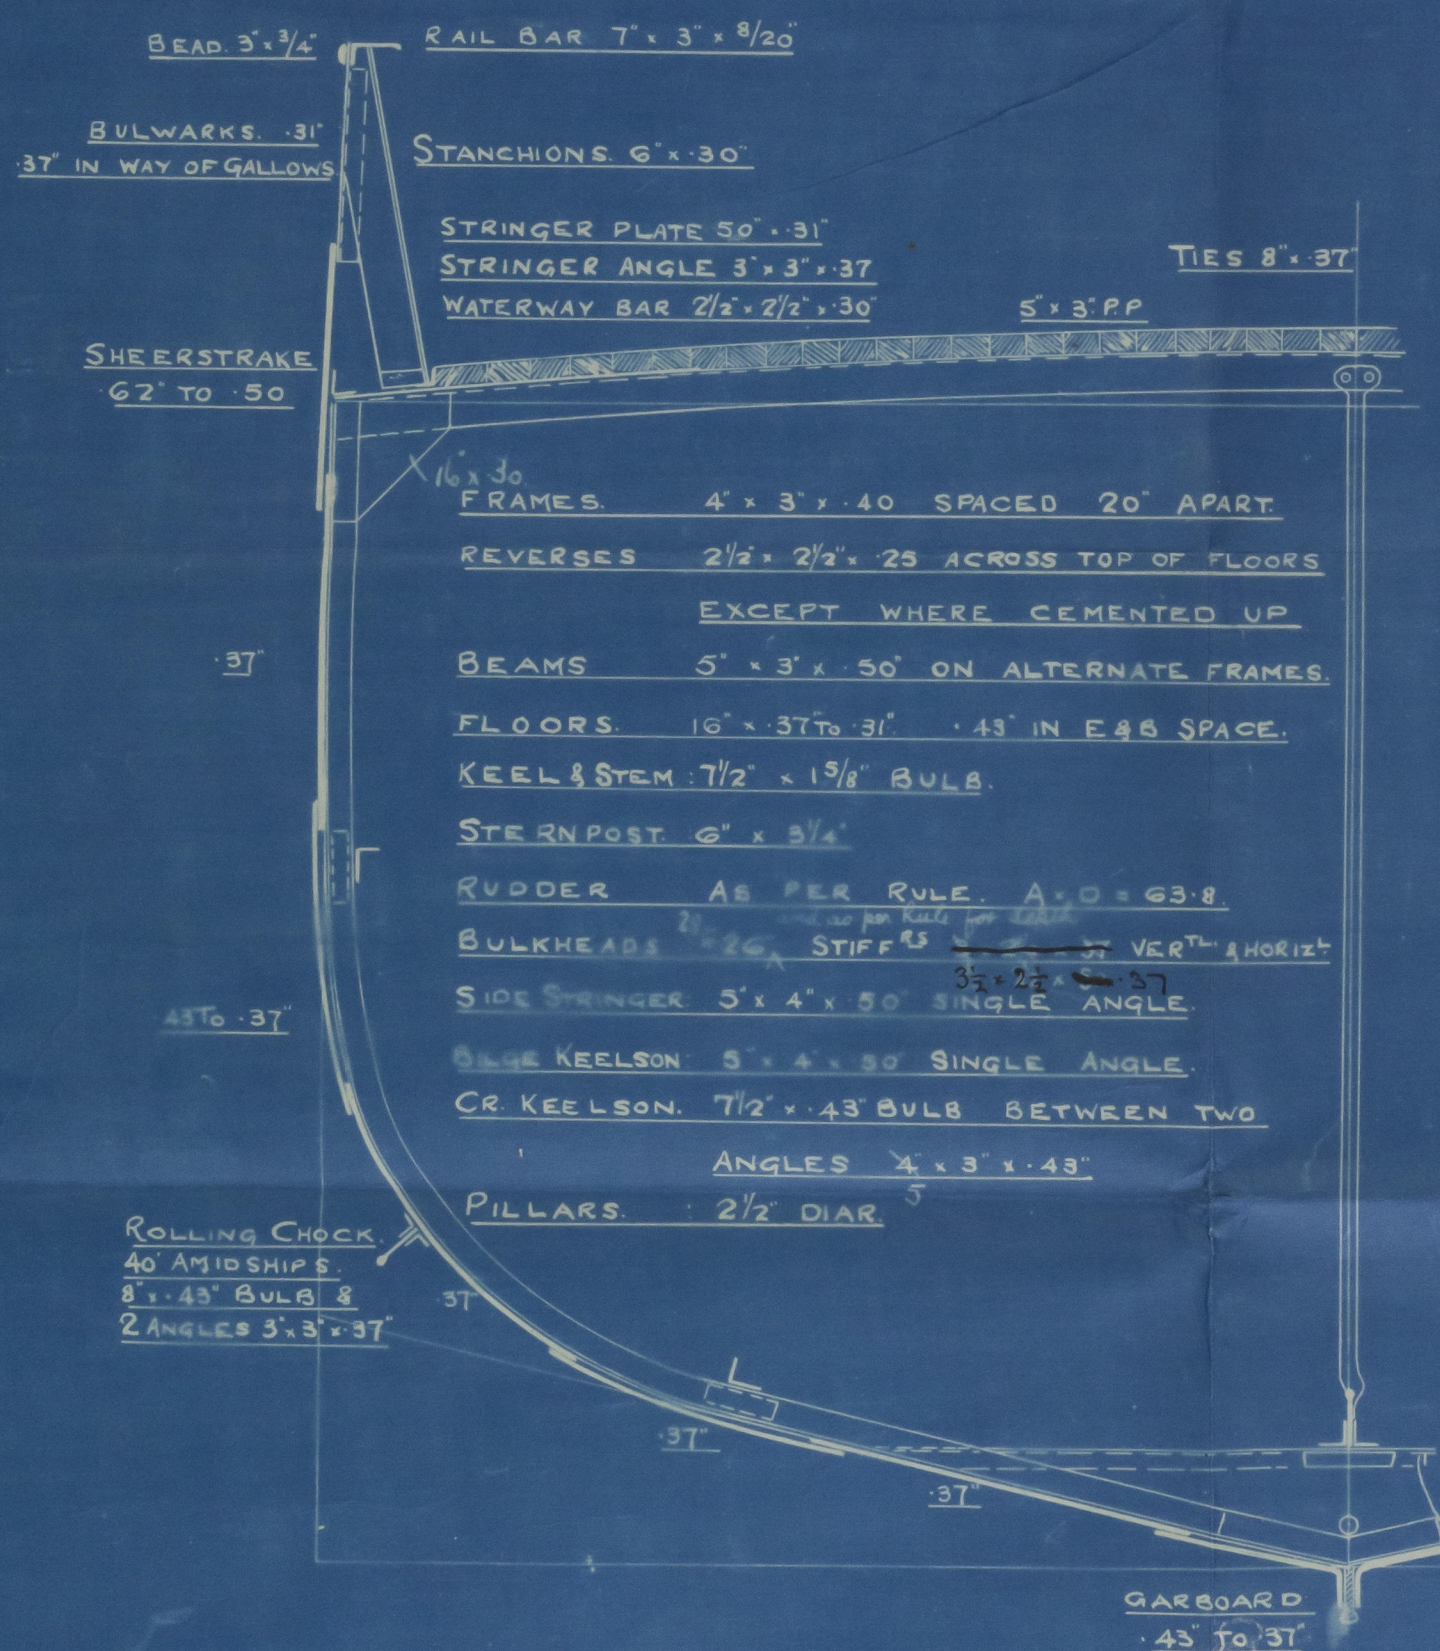

NUMERALS.

B + D ----- 36.12
L x (B + D) ----- 4936.15

PROPORTIONS.

L ----- 10.51
D ----- 5.91
B -----

EQUIPMENT.

1 ANCHOR ----- 6 CWTs EX STOCK
1 " ----- 5 1/2 " " "
1 " ----- 3 " " "
120 FATHOMS ----- 1 1/2" STUDLINK CABLE
60 " ----- 6" HAWSER.
60 " ----- 5" WARP.

RIVETING.

BUTTS OF SHELL PLATING OVERLAPPED AND DOUBLE RIVETED. EXCEPT GARBOARD & SHEERSTRAKE WHICH ARE TO BE STRAPPED & DOUBLE RIVETED.
LANDINGS DOUBLE RIVETED.
BULWARKS STRAPPED & SINGLE RIVETED.

J.W.
11.7.13



© 2020

Lloyd's Register
Foundation

002215-002515-002515


Cochrane & Sons. Ltd.

N^o ~~576~~ . ~~580~~ . ~~585~~ 586

Duplicate.

Midship Section.

s/s Sir Mark Sykes
Hull Rpt No. 27359

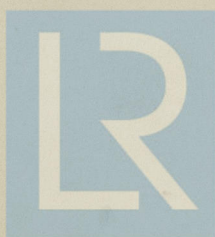

© 2020

Lloyd's Register
Foundation

002808-002815-0259