


APR 18 1909
Approved
See letter 10512

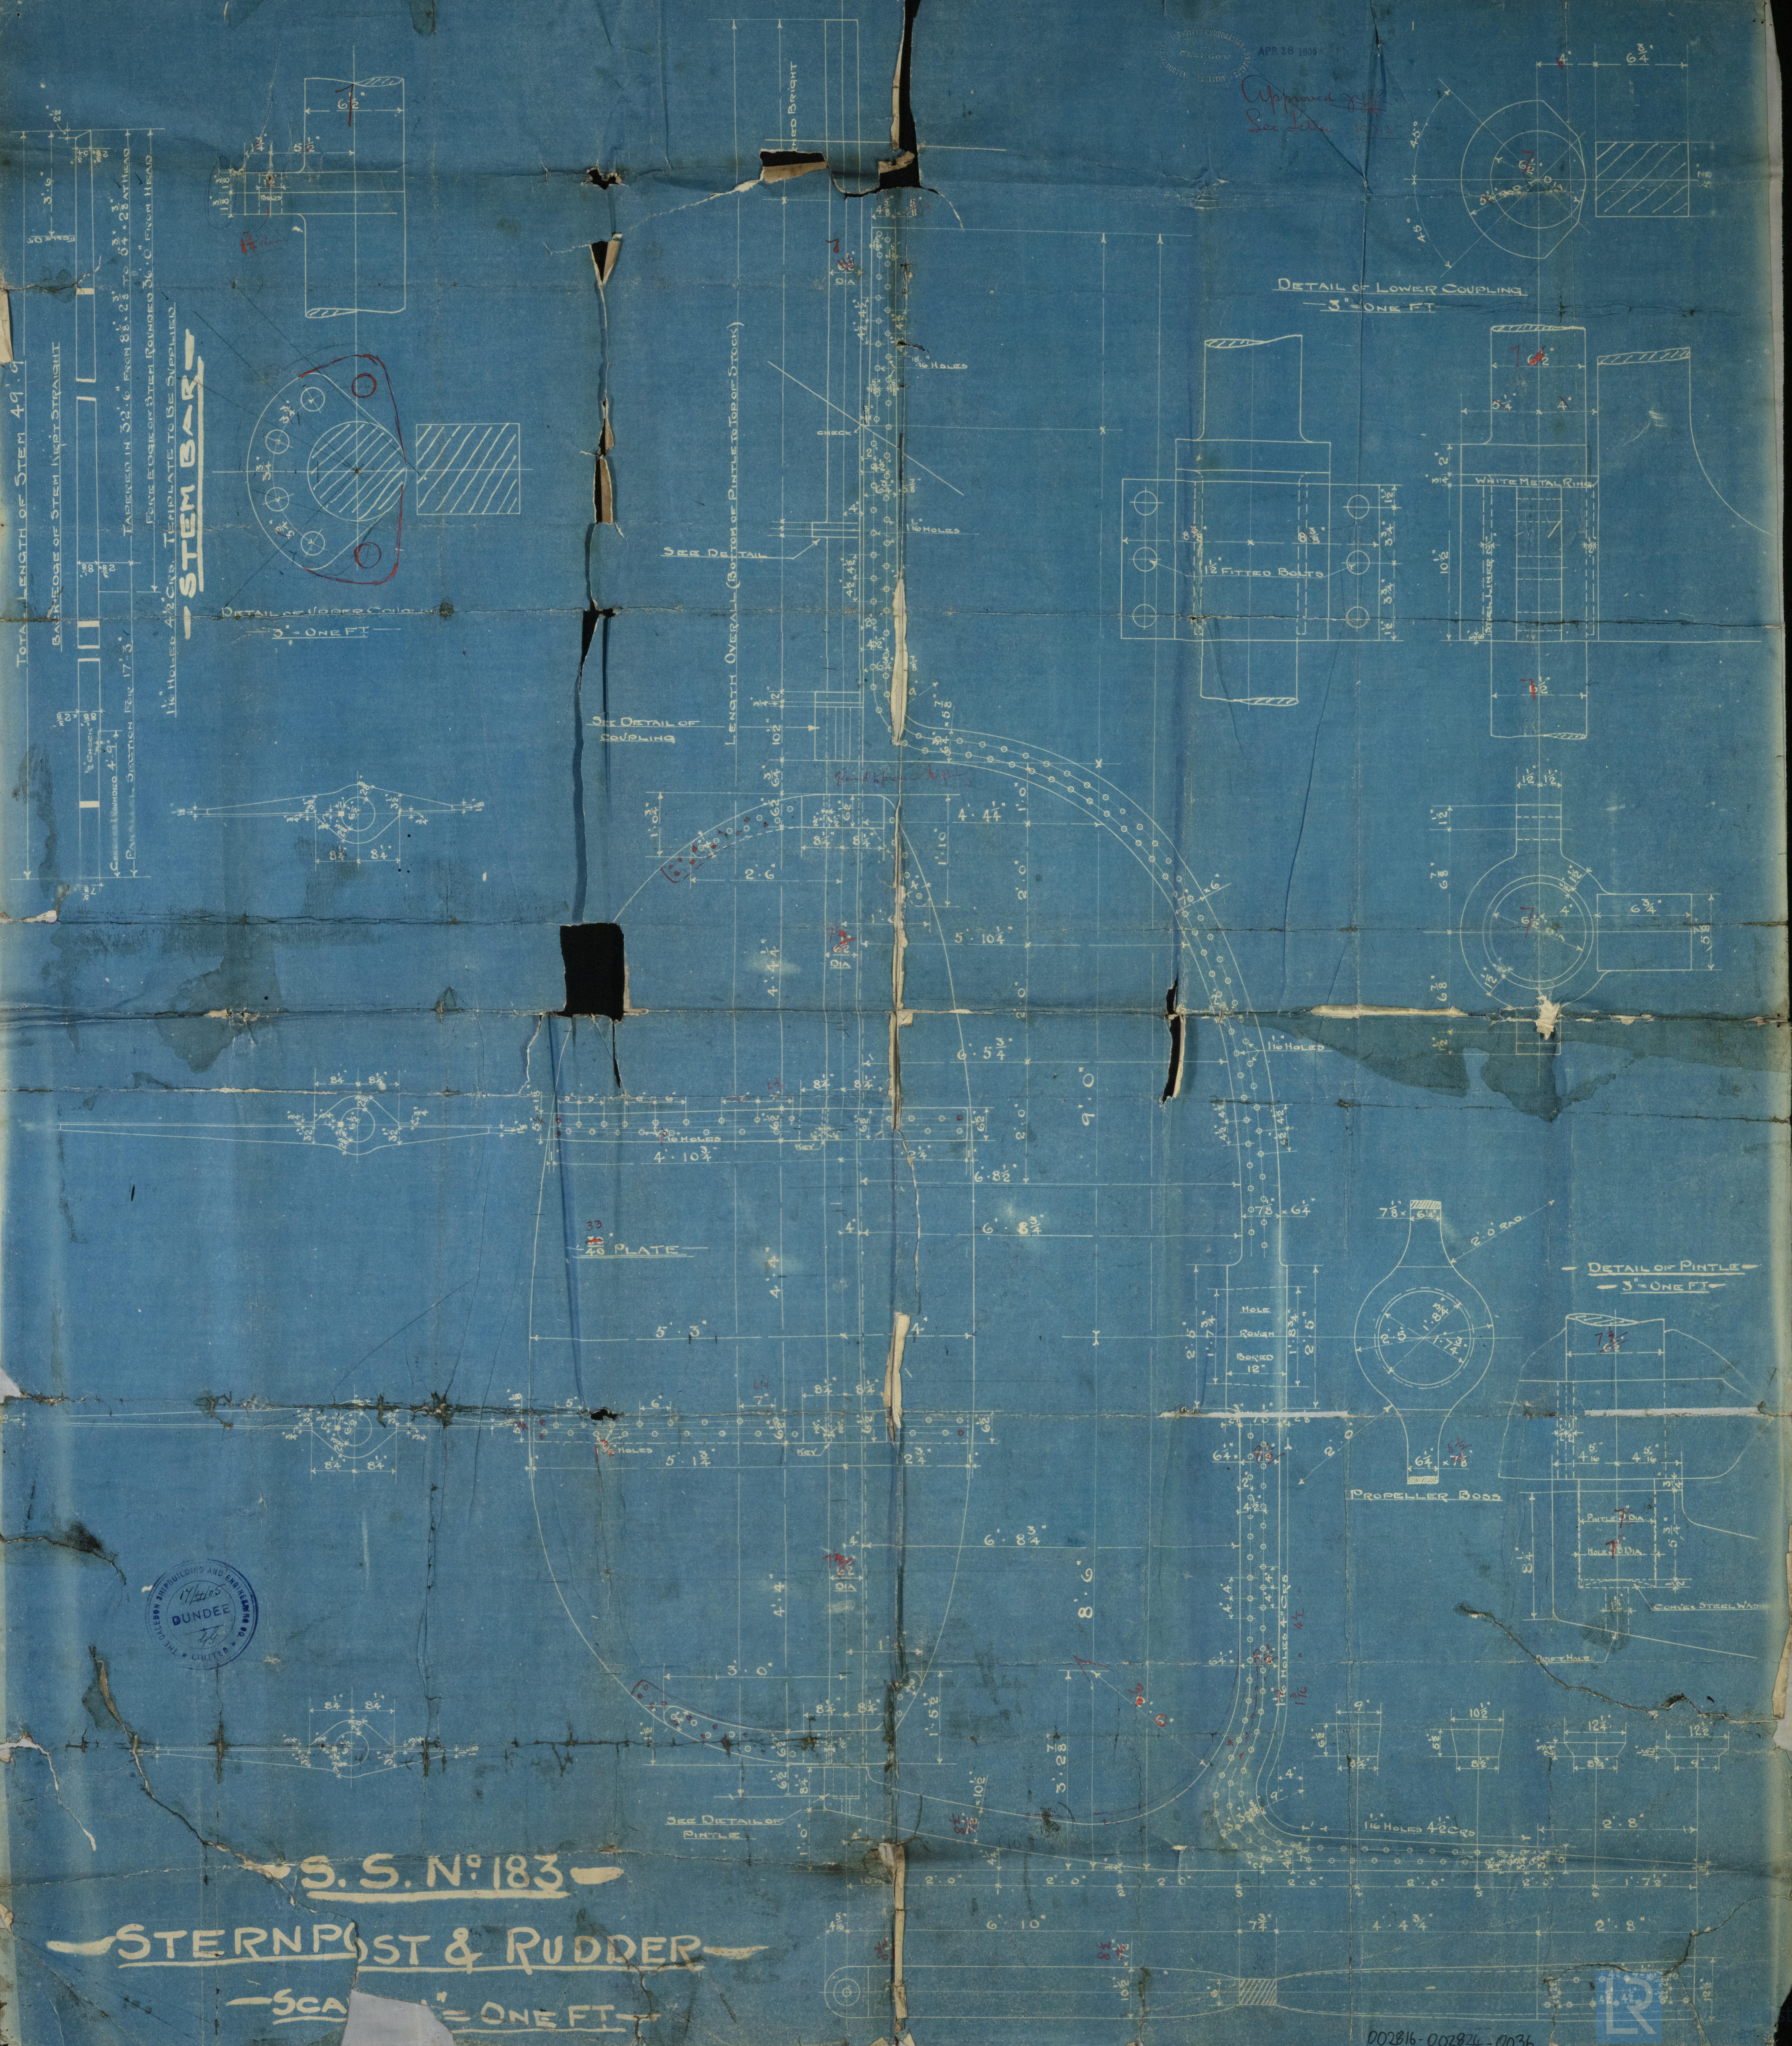

TOTAL LENGTH OF STEM 49' 6"
BACK EDGE OF STEM NEXT STRAIGHT
TAPERED IN 32' 6" FROM 88' 2 3/4" TO 54' 2 3/4" AT HEAD
PARALLEL SECTION FOR 17' 3"
FORE EDGE OF STEM ROUNDED 3/16" FROM HEAD
1 1/2" HOLES 4 1/2" CTS. TEMPLATE TO BE SUPPLIED
-- STEM BARK --

DETAIL OF UPPER COUPLING
-- 3' ONE FT --

SEE DETAIL OF COUPLING


LENGTH OVERALL (BOTTOM OF PINTLE TO TOP OF STOCK)

SEE DETAIL OF TAIL

DETAIL OF LOWER COUPLING
-- 3' ONE FT --

DETAIL OF PINTLE
-- 3' ONE FT --

PROPELLER BOSS

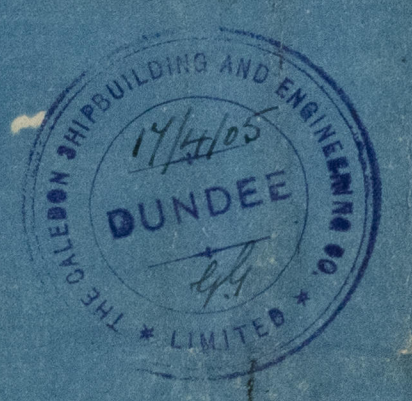

S. S. N° 183

STERNPOST & RUDDER

SCALE = ONE FT.

002816-002824-0036

Caledonia No 183

Rudder Stern Frame

SS. GLENELLAH"

TRANSFERRED TO
L. R. SYSTEM

002816-002824-0036



© 2021

Lloyd's Register
Foundation