



9.5.23

MIDSHIP SECTION.

No 227 SHIP.

SCALE 1/2"=1'-0"

Length B.P. 244'-0"
Breadth Mid 36'-6"
Depth Mid 20'-0"

LLOYDS NUMERALS.

LENGTH L 244.0
BREADTH B 36.5
DEPTH D 20.5
FIRST No. B + D 57.0
SECOND No. L x (B + D) 13908.0

DEPTH TO LENGTH M.D.K. 11.9
do do R.Q.D.K. 10.7

"d" for framing, at M.D.K. 17'-8"
do at R.Q.D.K. 20'-0"
do at Deep Tank 5'-0"
do above do 14'-10"

ERRECTIONS


RAISED Q.R. DECK: 95.81 x 2.33 x 1. = 213.24
BRIDGE: 51.75 x 7 x 3 = 271.69
FORECASTLE: 22.19 x 7 x 3 = 116.50
HOUSES: 51.75 x 7 x 4 = 141.12
L x (B + D) 13908.00

EQUIPMENT No. 14700.55

SHEER
FORWARD 5'-6"
AFT 3'-0"
8 L FROM FORD 3'-1"
8 L FROM AFT 1'-8 1/4"

EQUIPMENT ("p")

2 BOWERS ANCHORS 30 1/2 CWT EACH STOCKLESS
1 STREAM 7 1/4 " EX STOCK
NO KEDGE
240 FATHOMS 1 1/2" STUD LINK CHAIN CABLE
75 3 1/4" FLEX STEEL STREAM WIRE
30 3/4" TOW LINE
2 @ 30 2 1/4" WIRE HAWSER
2 @ 30 5" MANILLA HAWSE

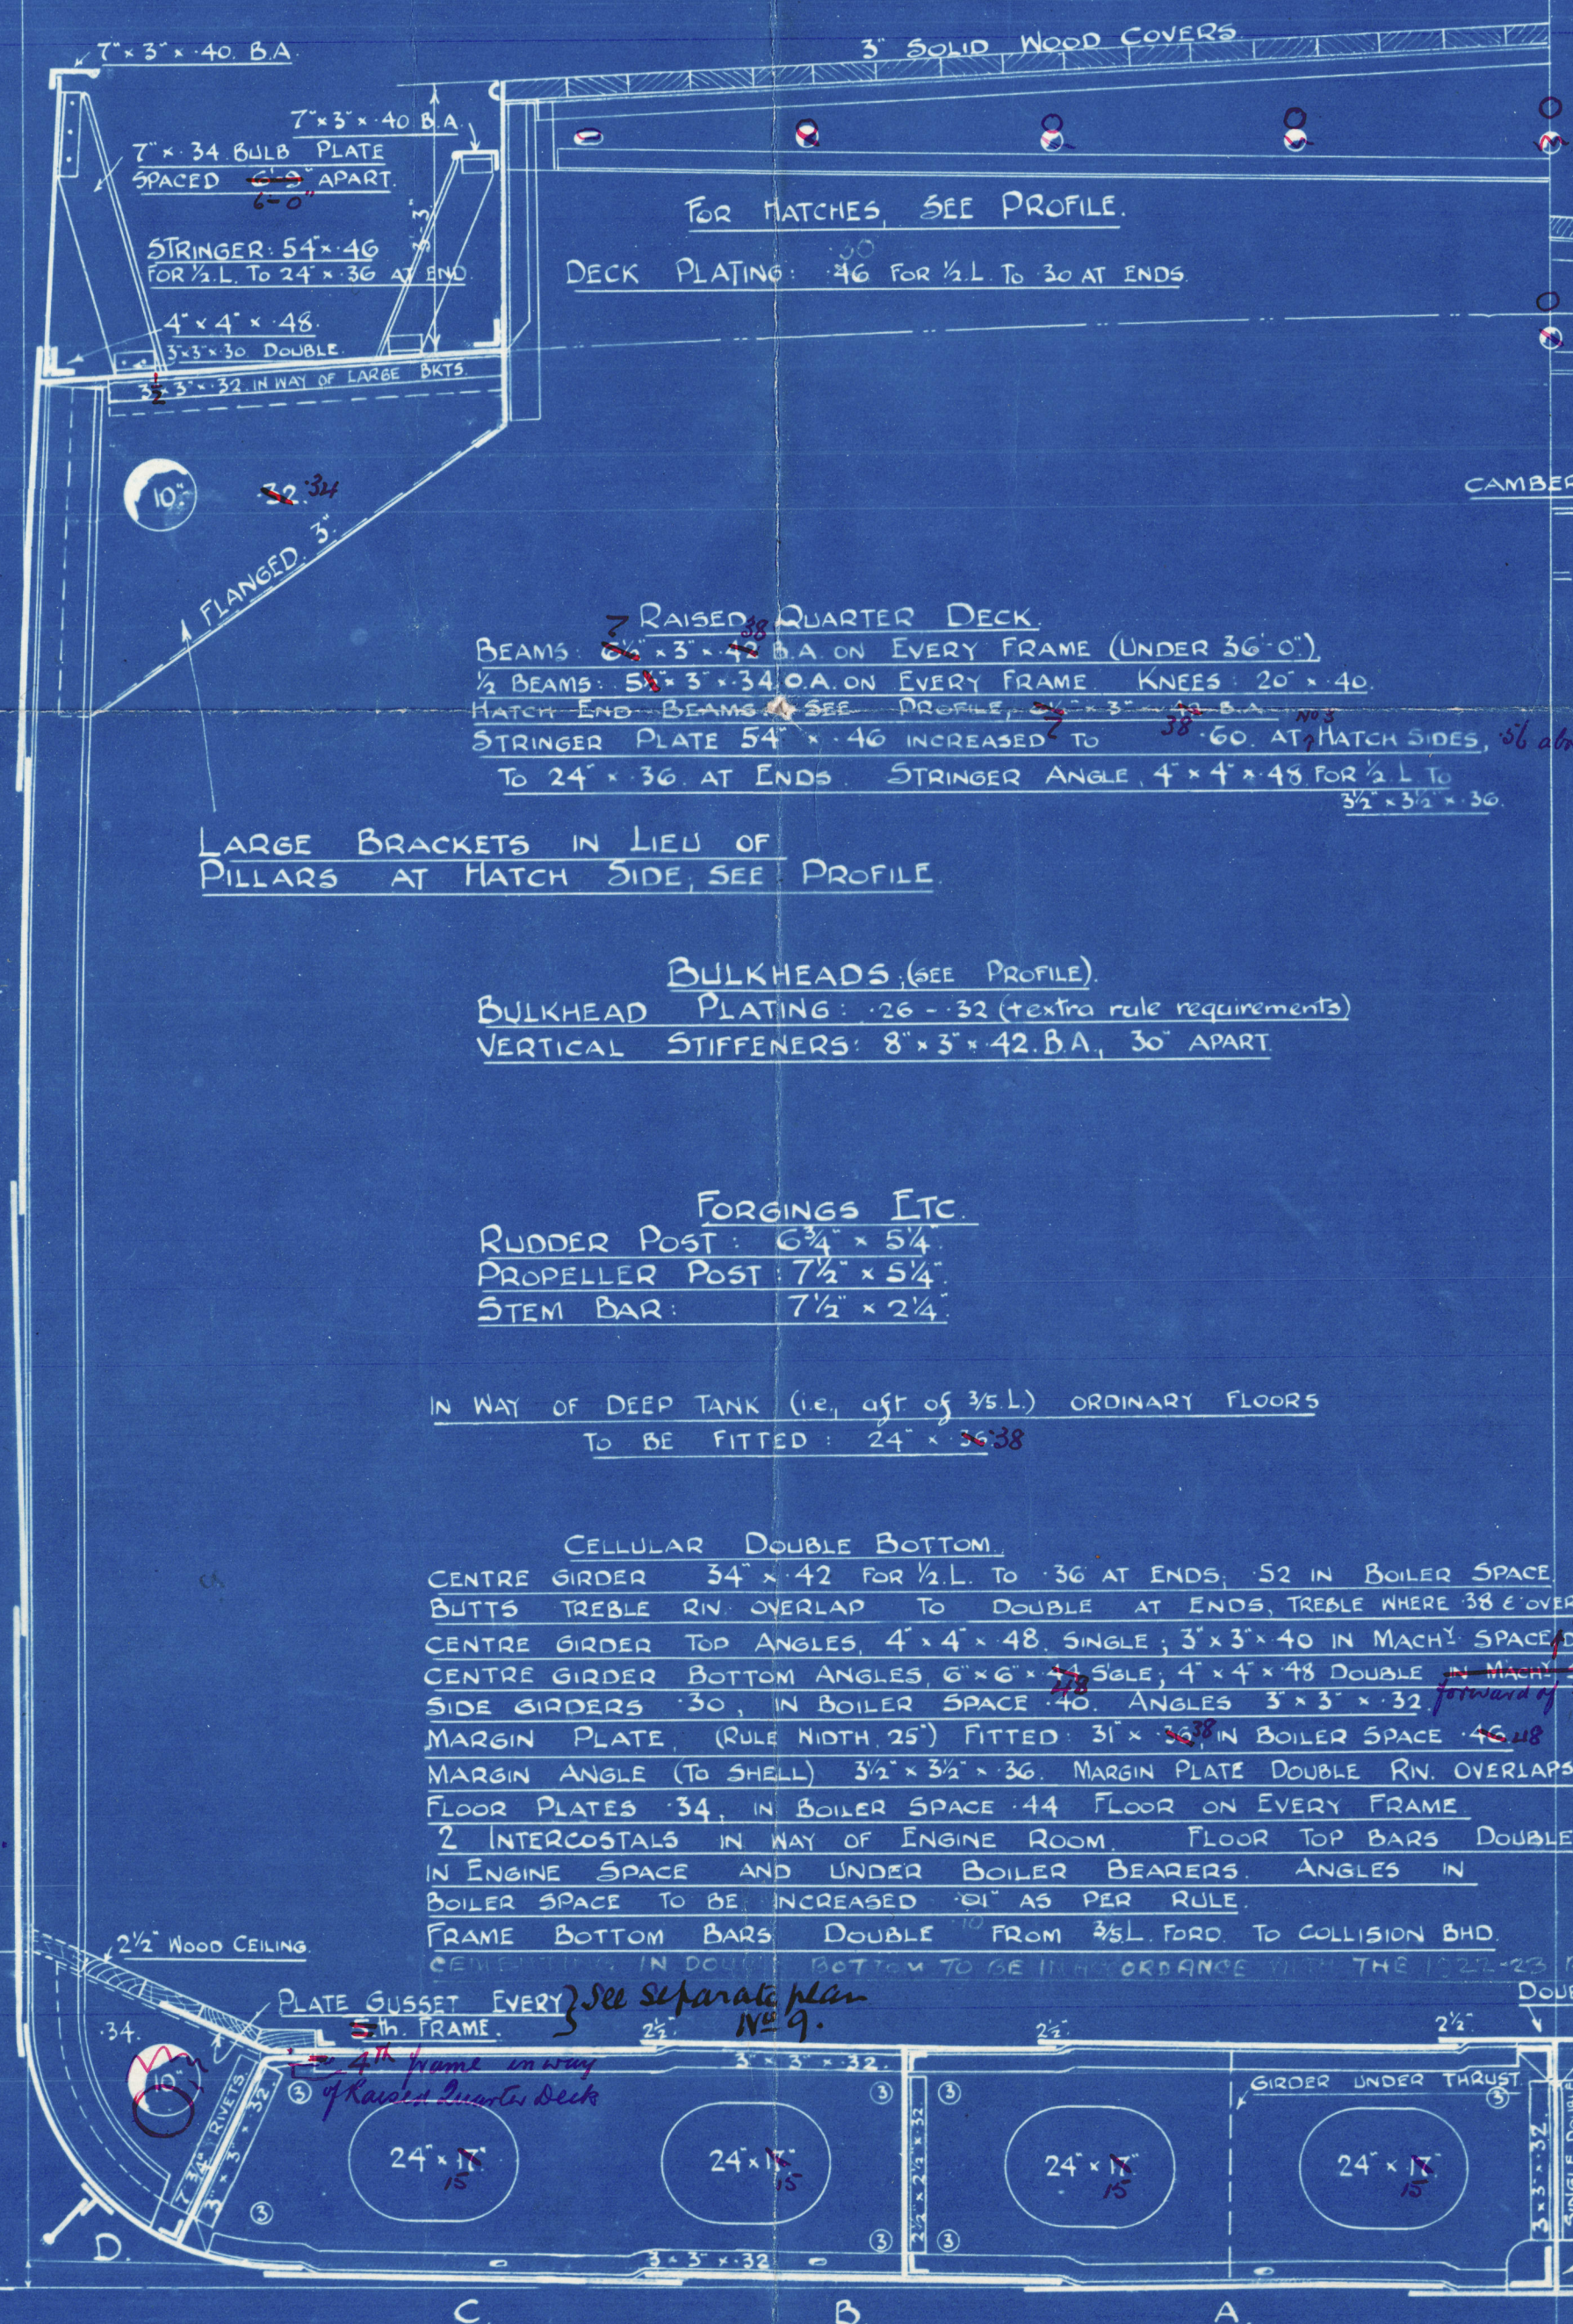

See separate plan for arrangement of side plating.

SIDE PLATING STRAKES
E.F. & S. 48 FOR 1/2 L.
TO 40 AT ENDS. TO BE
INCREASED TO 42.04
ON ACCOUNT OF NO SIDE
STRINGERS AND 04 ON
ACCOUNT OF 27" FRAME
SPACING = 54" TO 40.
PROPELLER BOSS PLATES 54.



9.5.23

00286-002824-0061

Messrs Tyne Iron
SB Co Ltd

S.S. No 227

Midship Section


1
—

S. S. Lamberwell

NEWCASTLE ON TYNE.

Report No. 44804

RECORDS DEPT
LONDON.

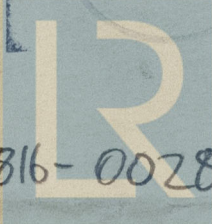

© 2021

002816-002824-0061

Lloyd's Register
Foundation