



28/3/23

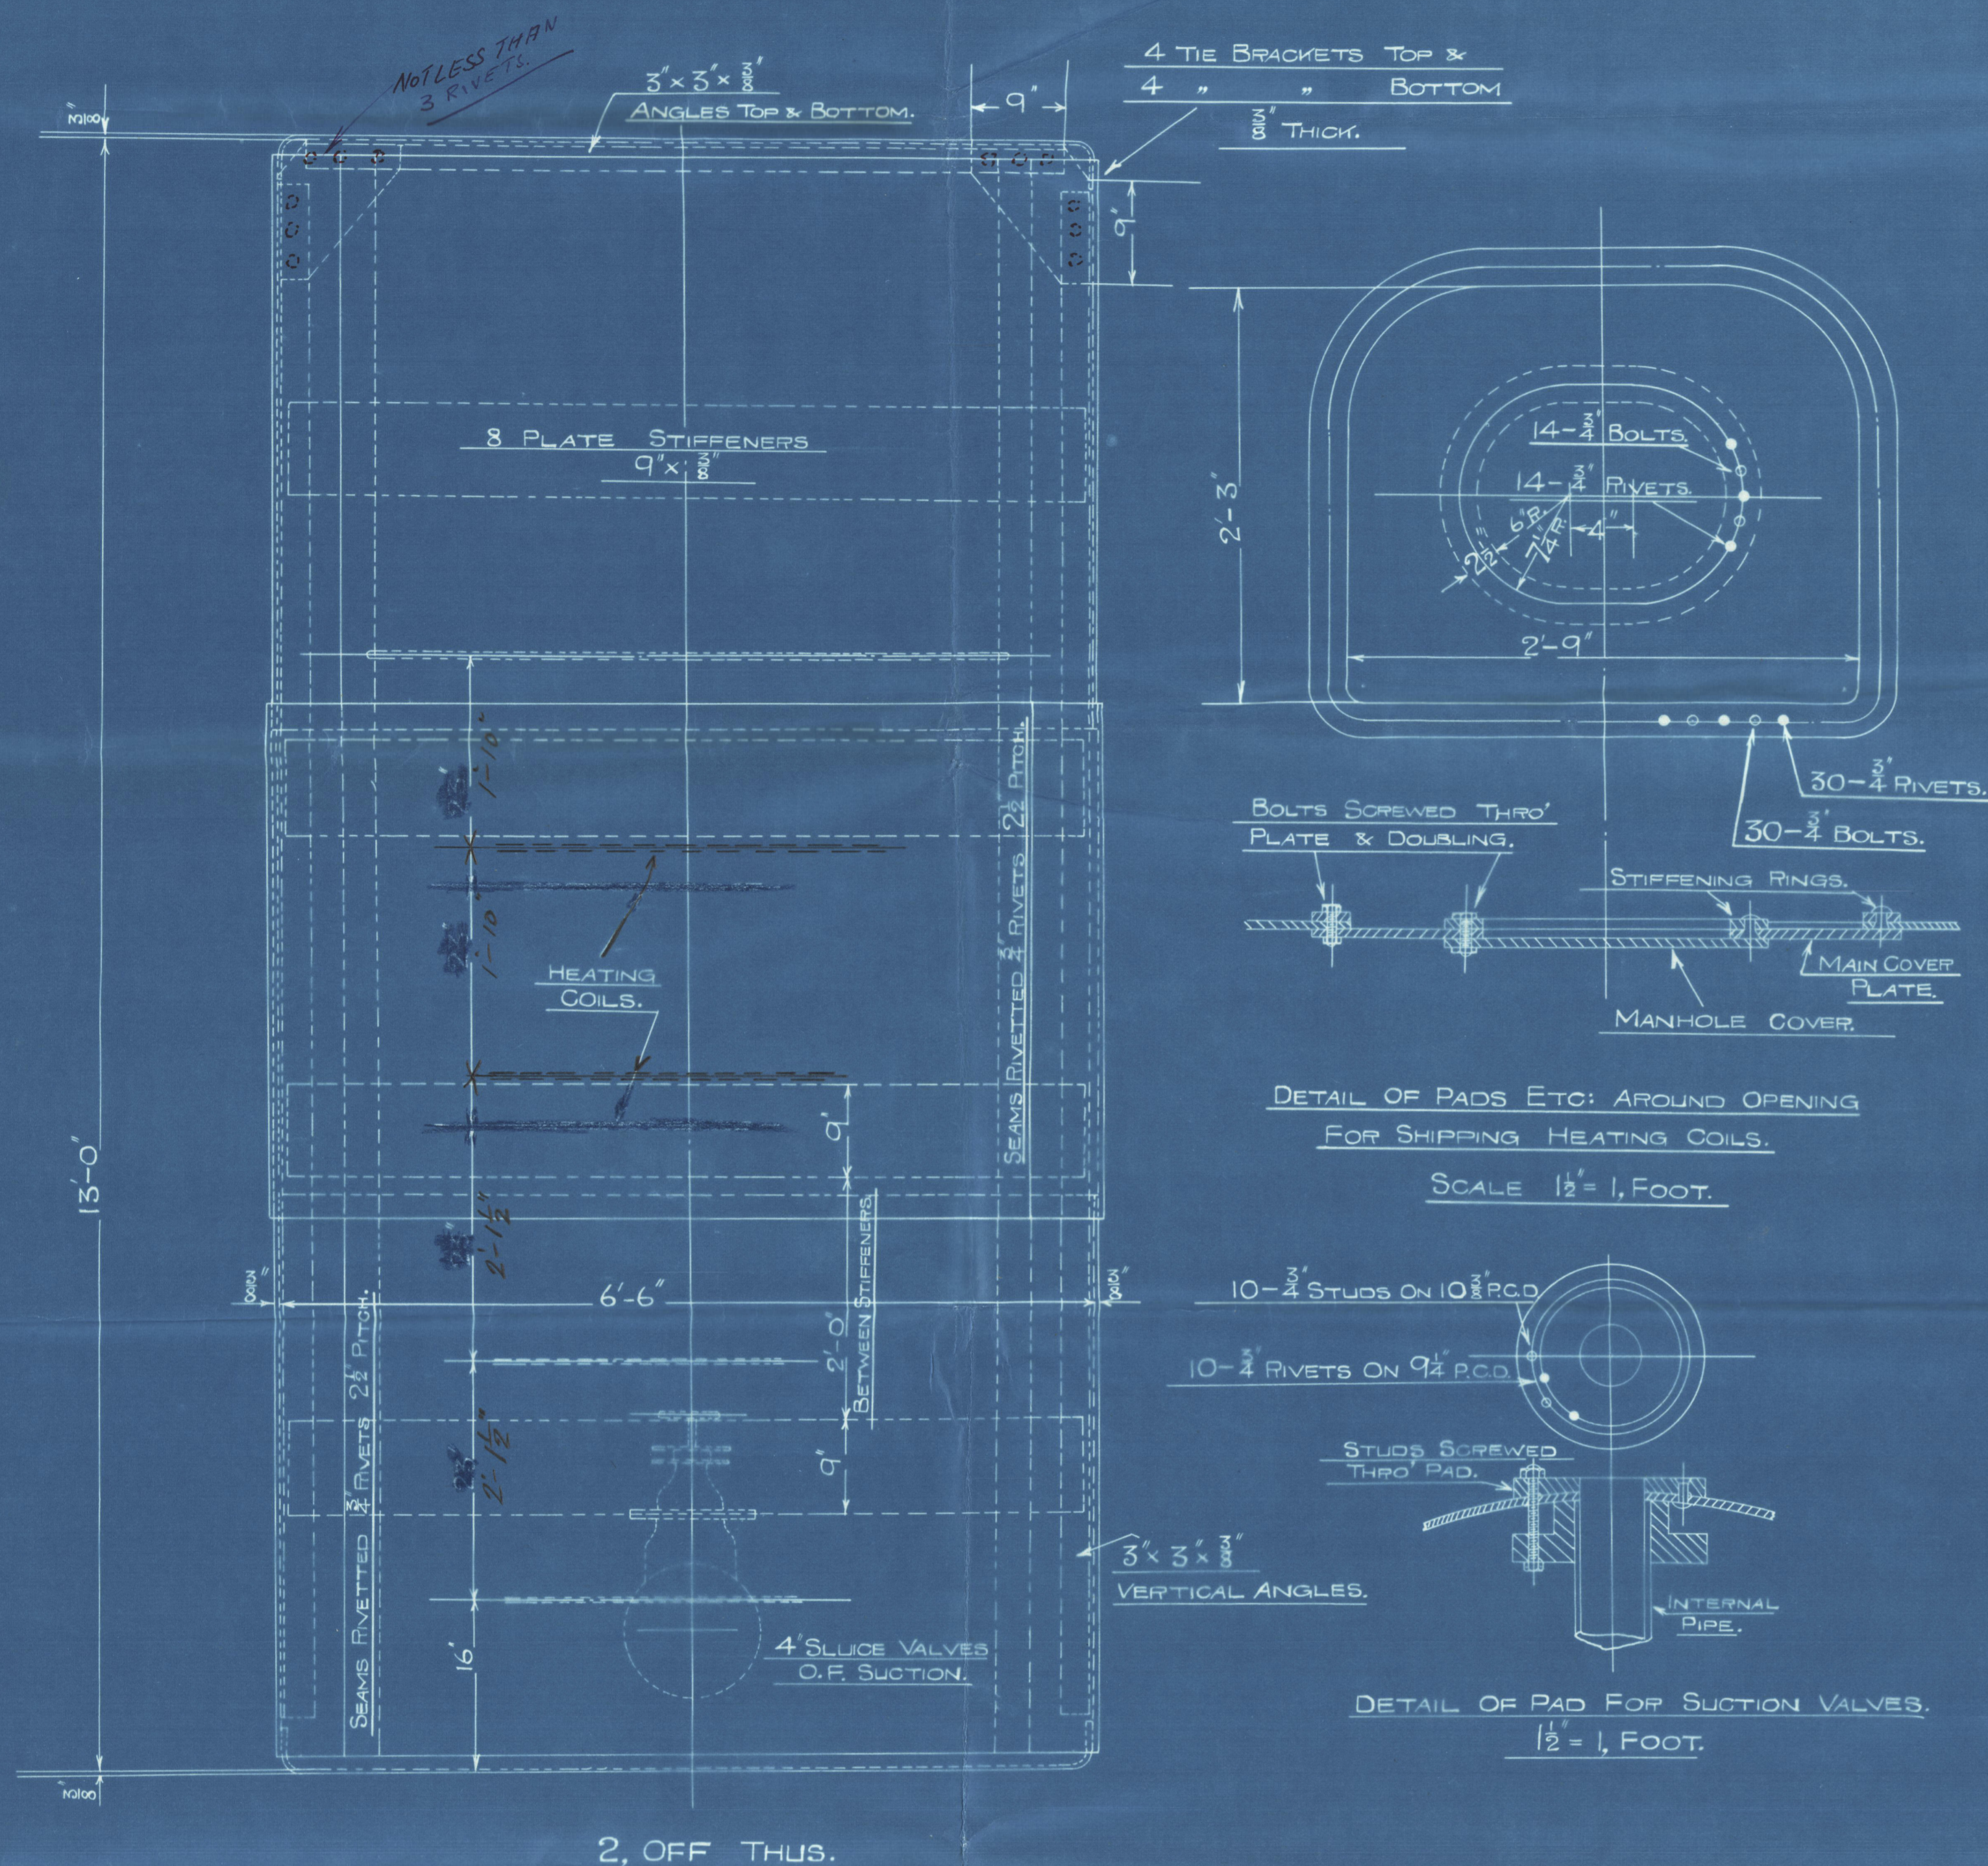

ALL SEAMS RIVETTED
2 1/2" RIVETS 2 1/2" PITCH.

TANKS TO BE TESTED
TO 10 LBS. □.

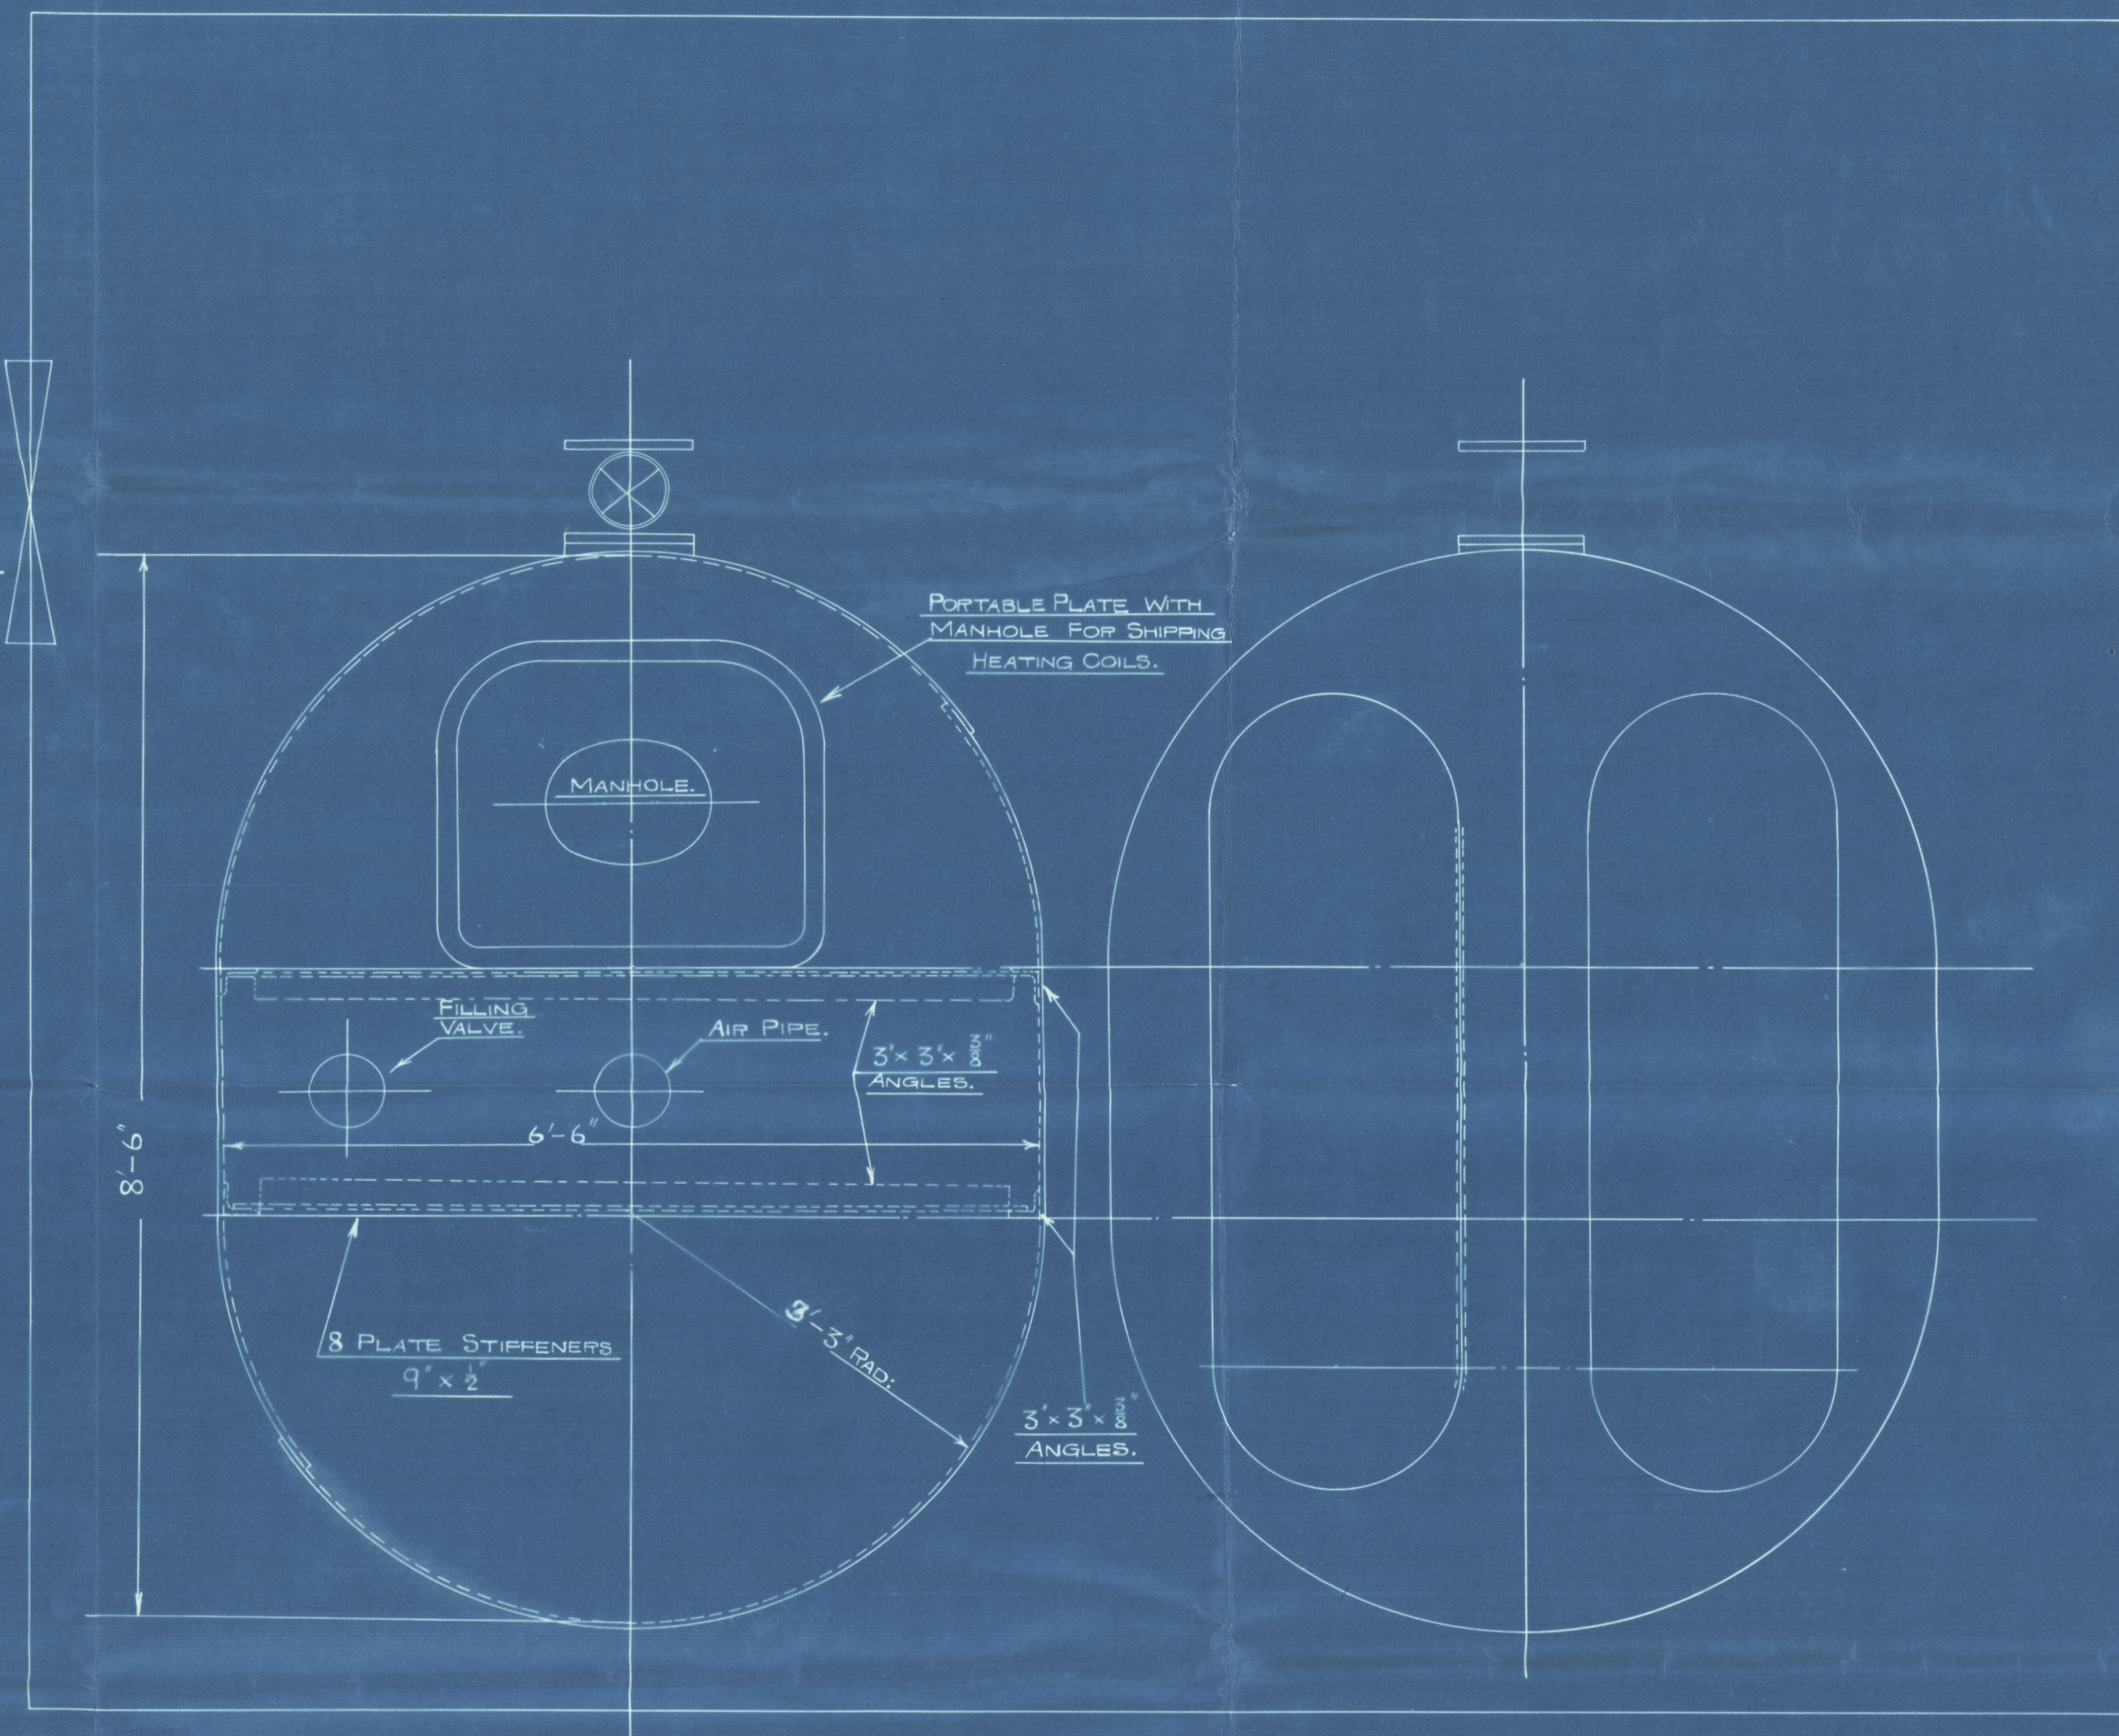

S.S. "SHAHRISTAN."

SETTLING TANKS FOR OIL FUEL INSTALLATION.

SCALE 1" = 1 FOOT.



S. S. "Shakristan"

Settling Tanks

Wallsend Shipway &
Engl.



© 2020

Lloyd's Register
Foundation

002825-002829-0050