



28/3/23

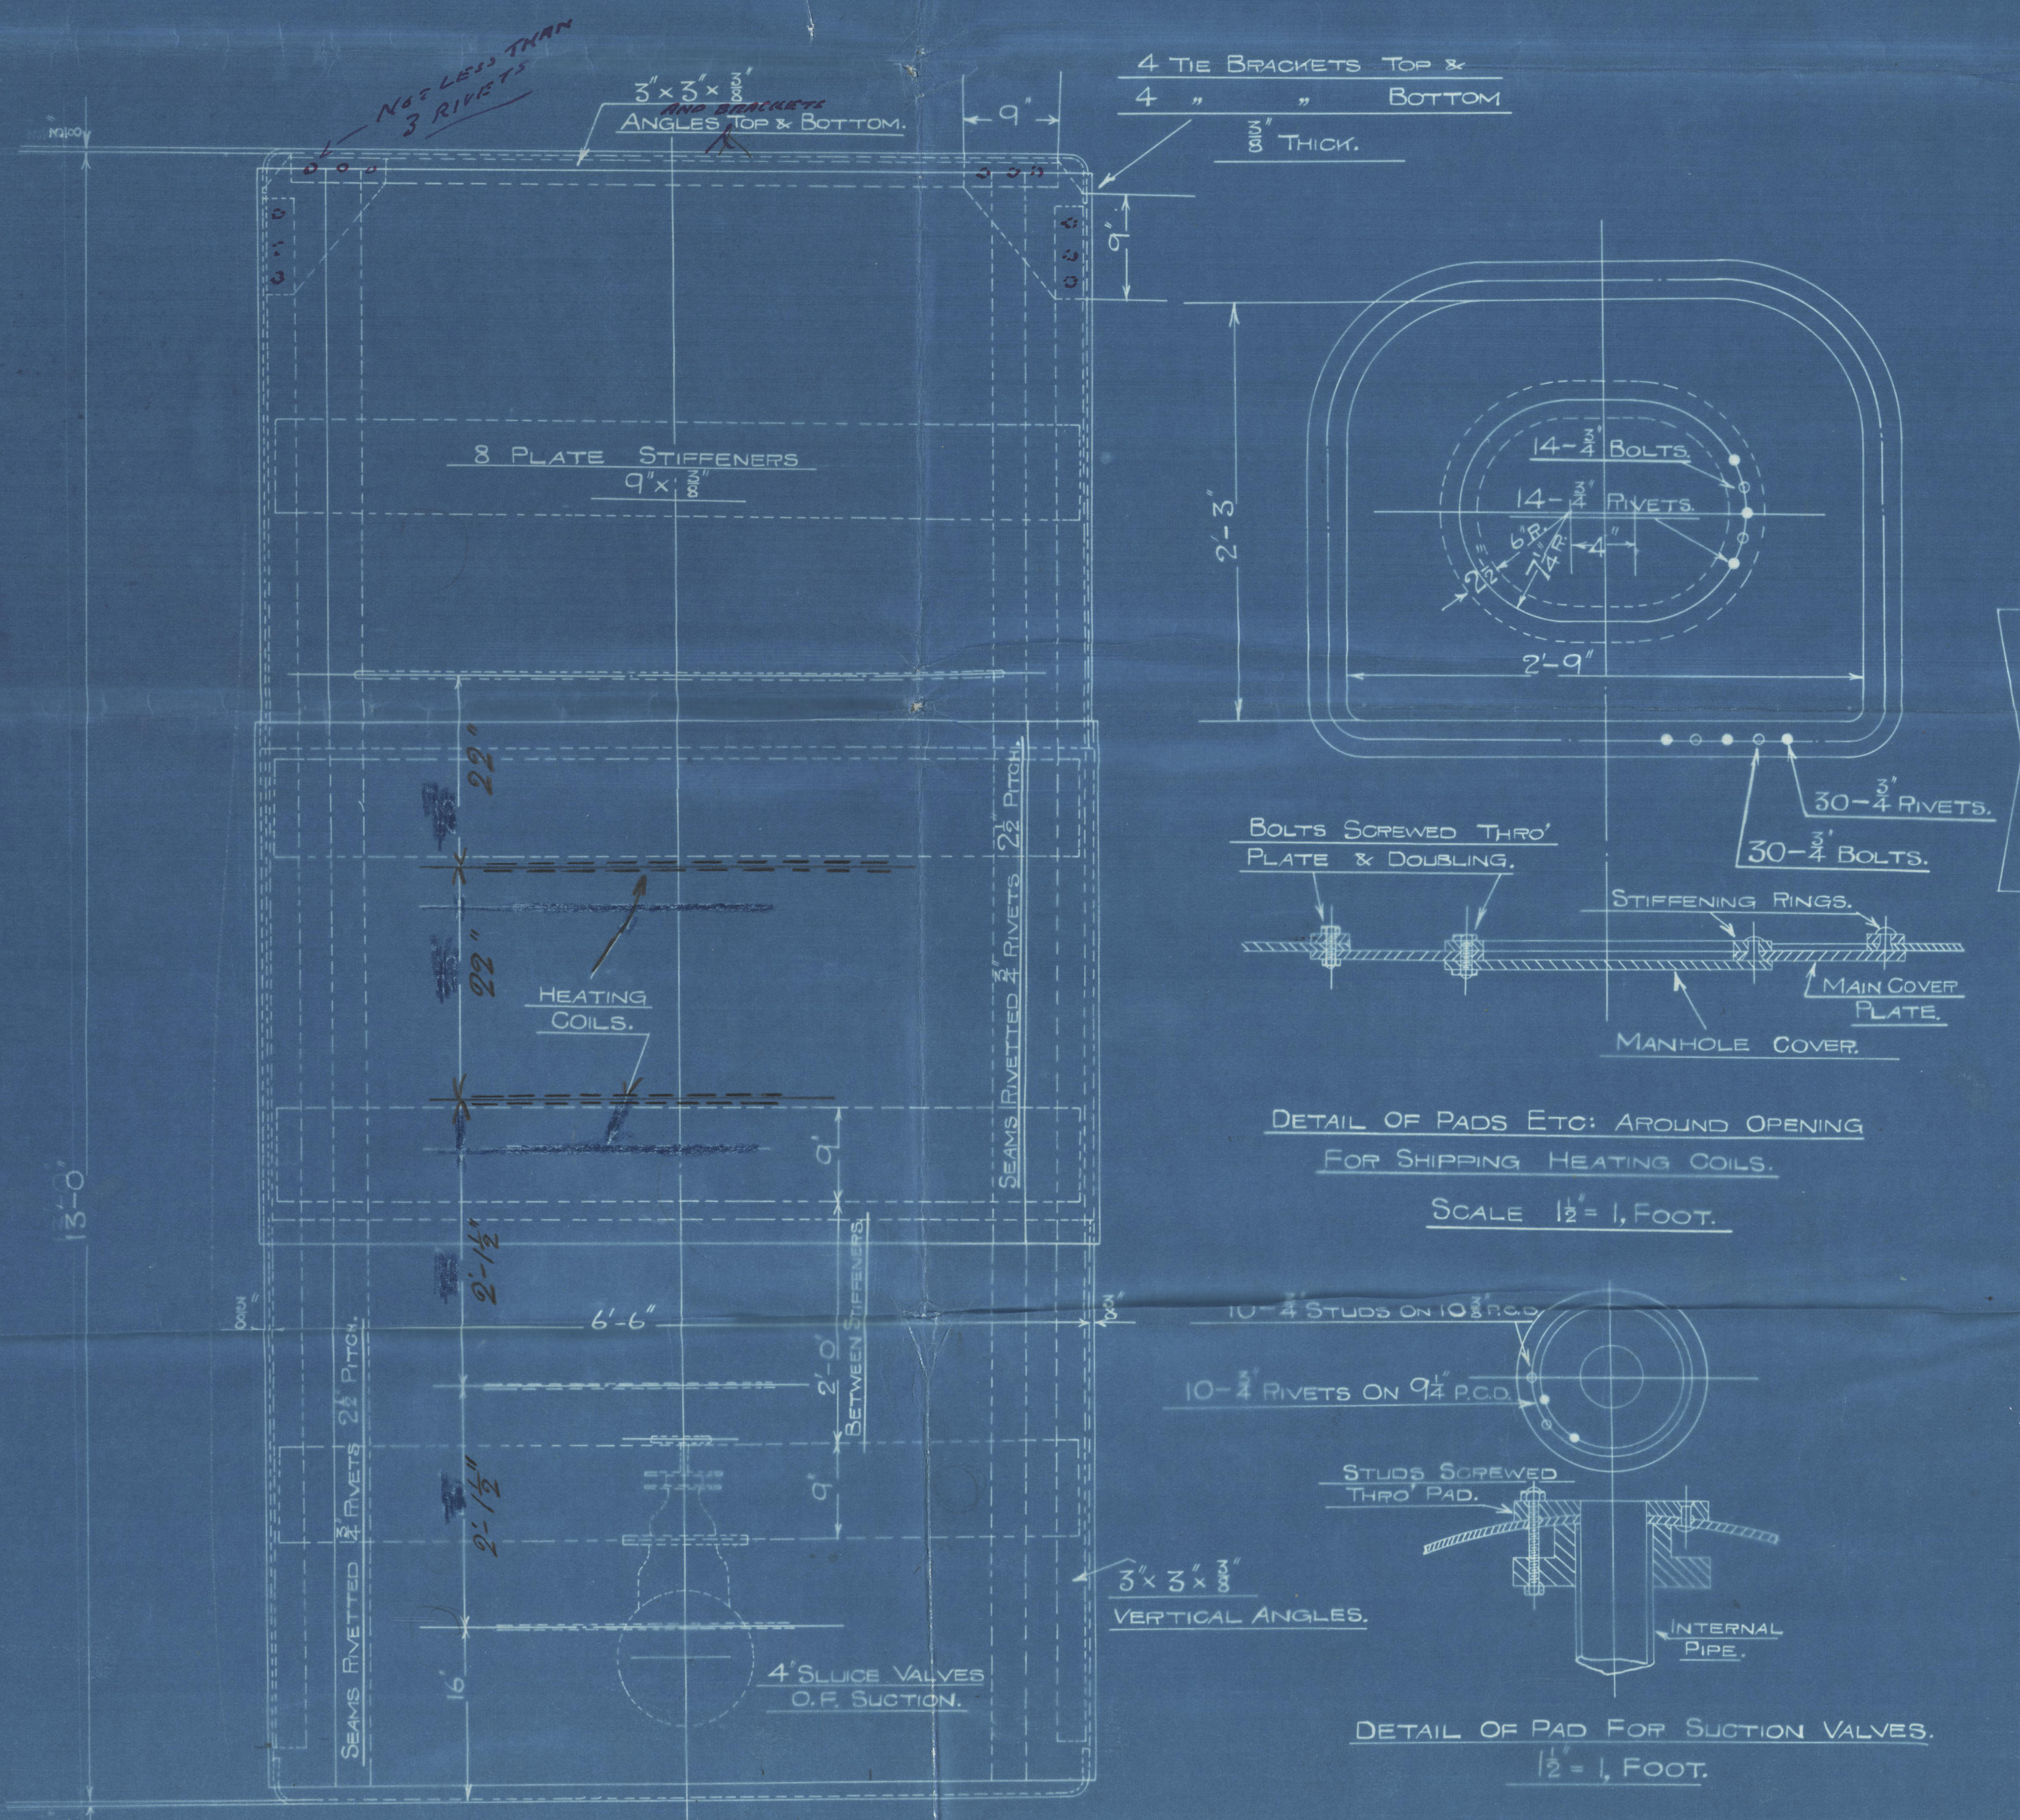


2, OFF THIS.

ALL SEAMS RIVETTED  
3/4" RIVETS 2 1/2" PITCH.

TANKS TO BE TESTED  
TO 10 LBS. □.

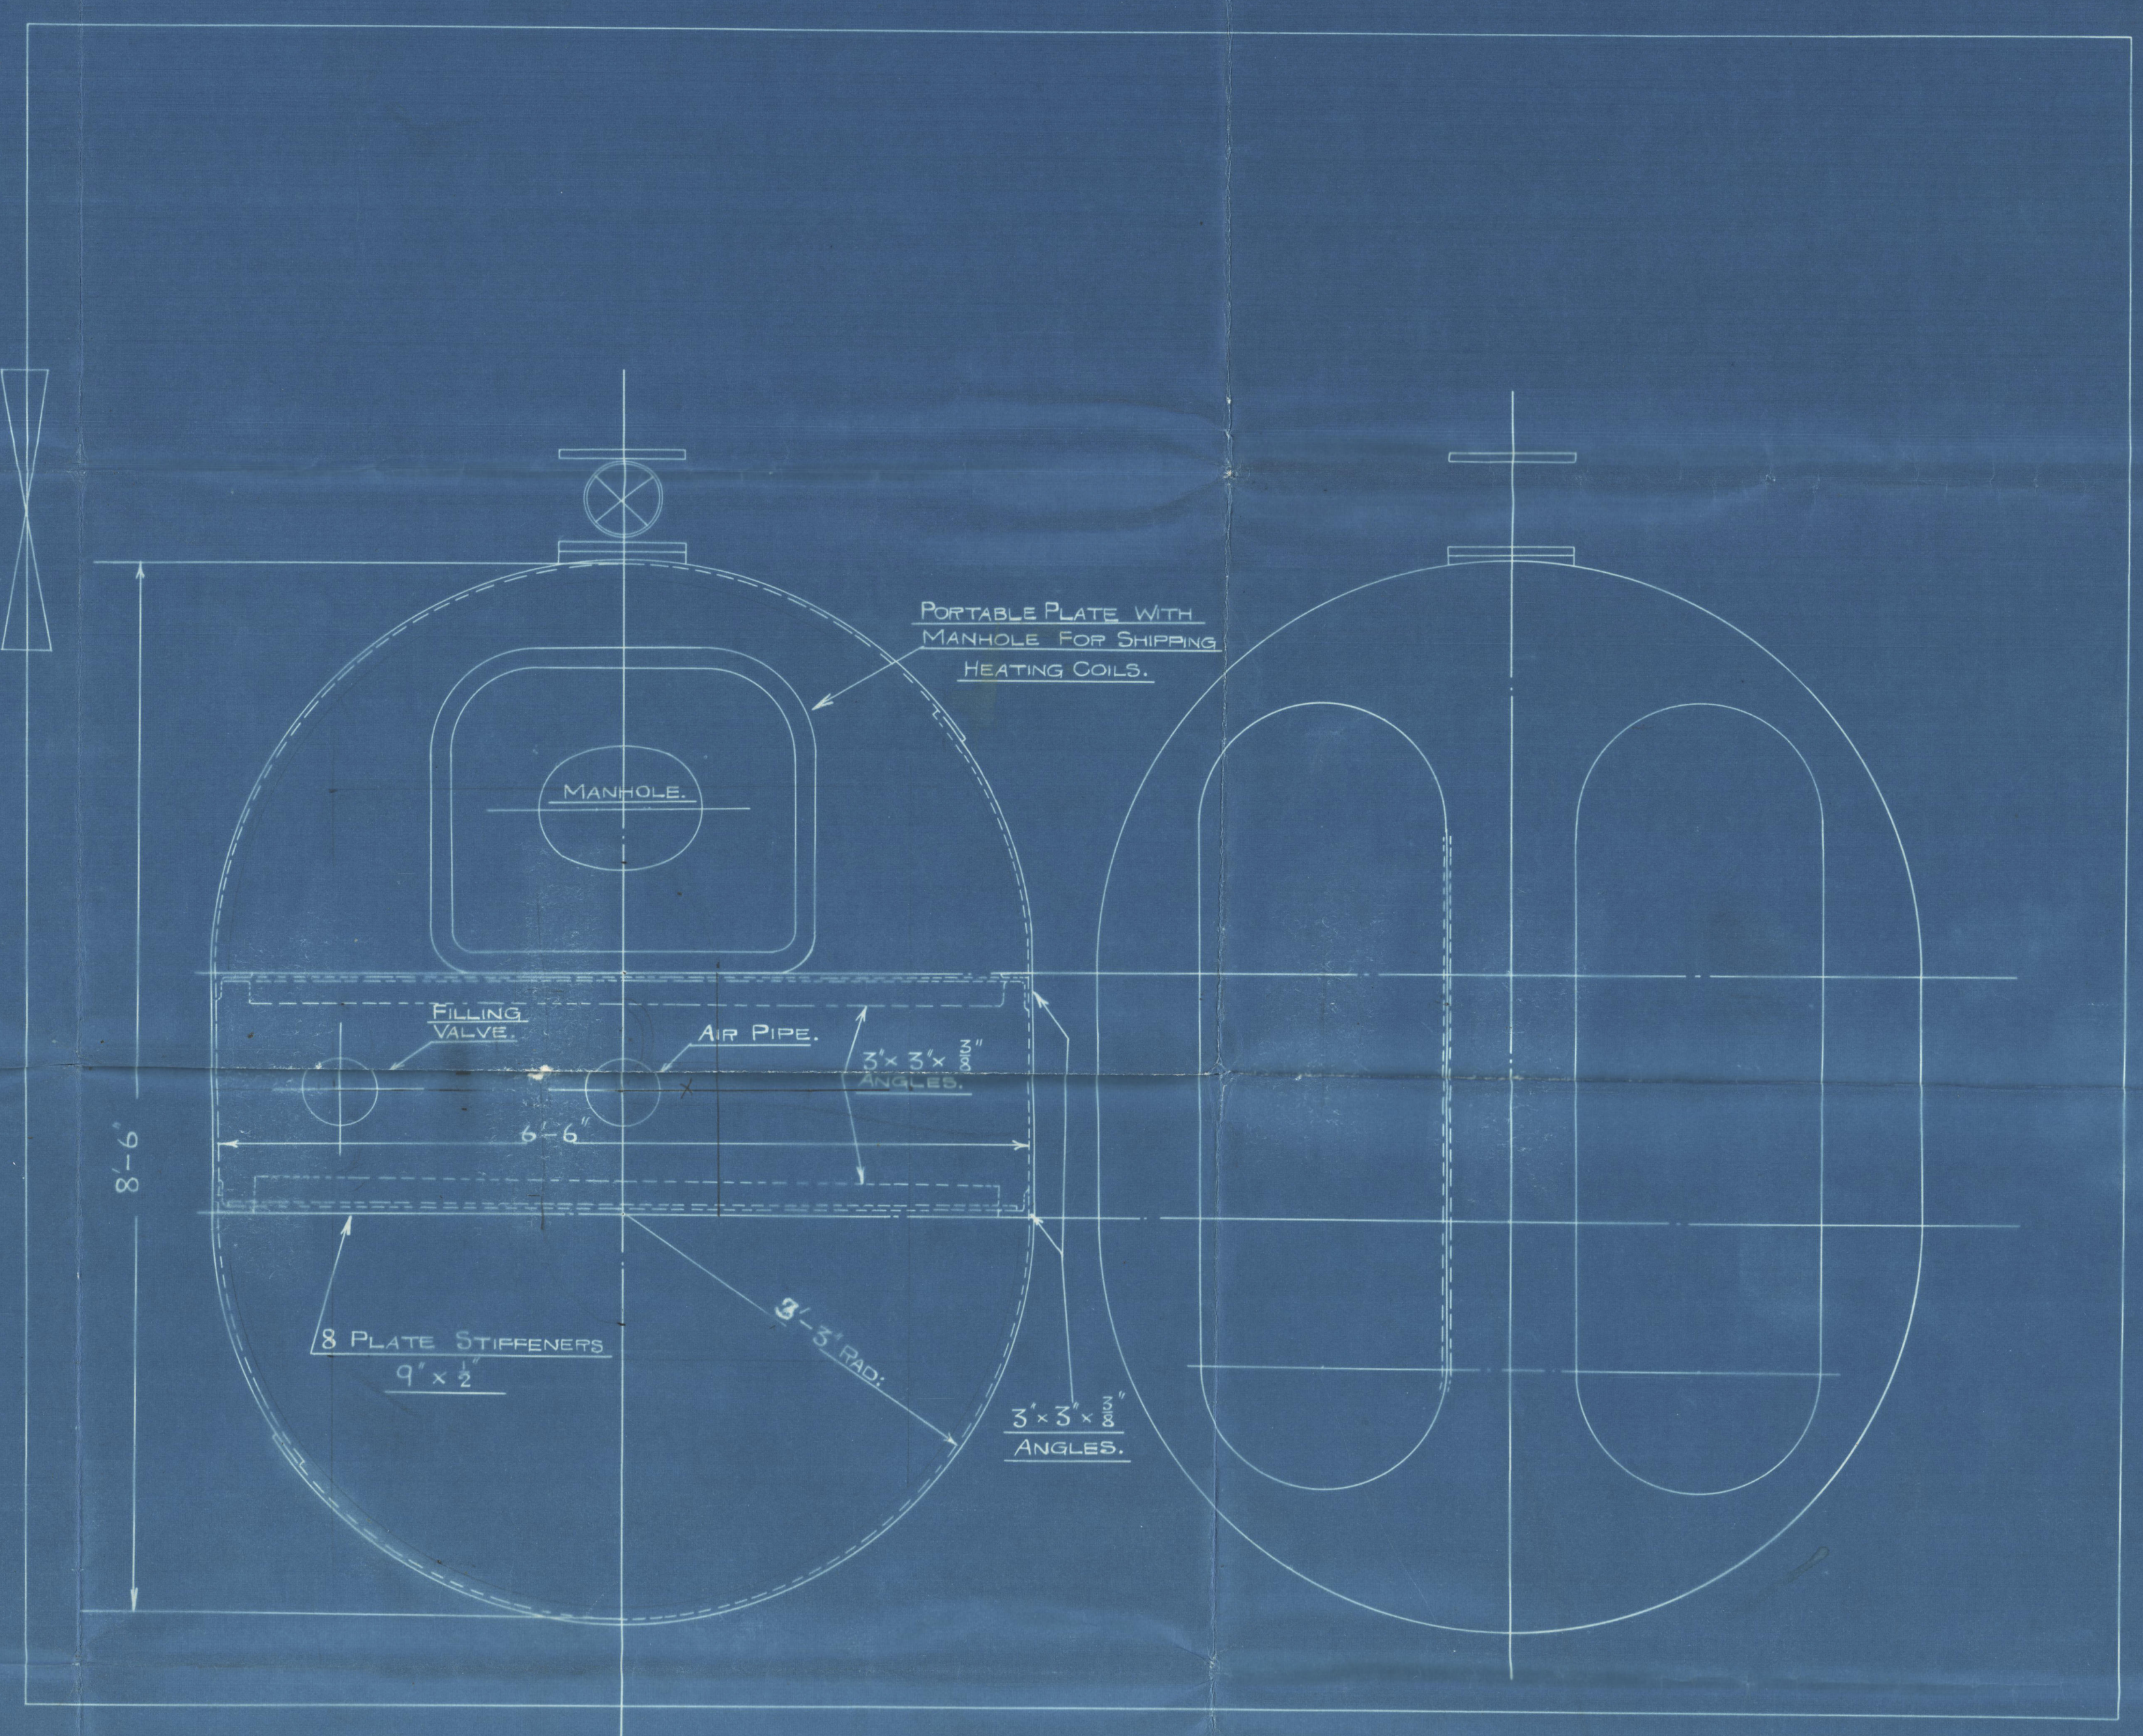

S.S. "SHAHRISTAN"  
SETTLING TANKS FOR OIL FUEL INSTALLATION.  
SCALE 1" = 1 FOOT.

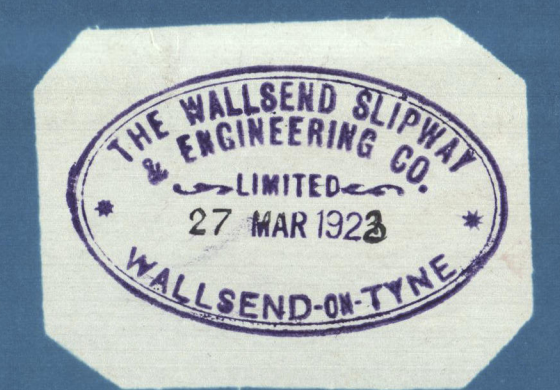


28/3/23

28/3/23



OB 1829.

002825-002829-0052 © 2020

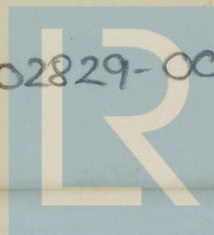

Lloyd's Register  
Foundation



S. S.<sup>r</sup> Shadrastan


Settling Tanks

Wallsend Shipway & Eng Co

QB 1829

NEWCASTLE ON TYNE.

Report No. 146689.

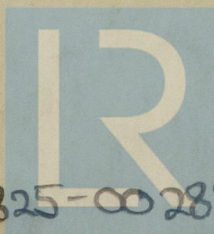

© 2020

Lloyd's Register

002825-002829-0052

Foundation