

S. S. № 334


RULE DIMS 330'-2" x 47'-8" MLD. x 24'-6" MLD. TO UPPER DECK 330'-1" ON L.W.L.
TO CLASS 100 A1. AT LLOYDS, SINGLE DECK & FITTED WITH CYLINDRICAL TANKS FOR
CARRYING PETROLEUM.

FREEBOARD PARTICULARS.

LENGTH ON LOAD WATER LINE	330'-1"
SHEER FORWARD	92 "
SHEER AFT	46 "
" 3/81IN: FORD.	51 3/4 "
" 1/8 " AFT	23 3/8 "
" 1/4 " FORD.	23 "
" 1/4 " AFT	11 1/2 "
TONNAGE COEFFICIENT (UNCORRECTED)	785

LENGTH OF ERECTIONS.

LENGTH OF ERECTIONS.
POOP 23'-5" — BRIDGE 96'-3" — FICLE 38'-0"

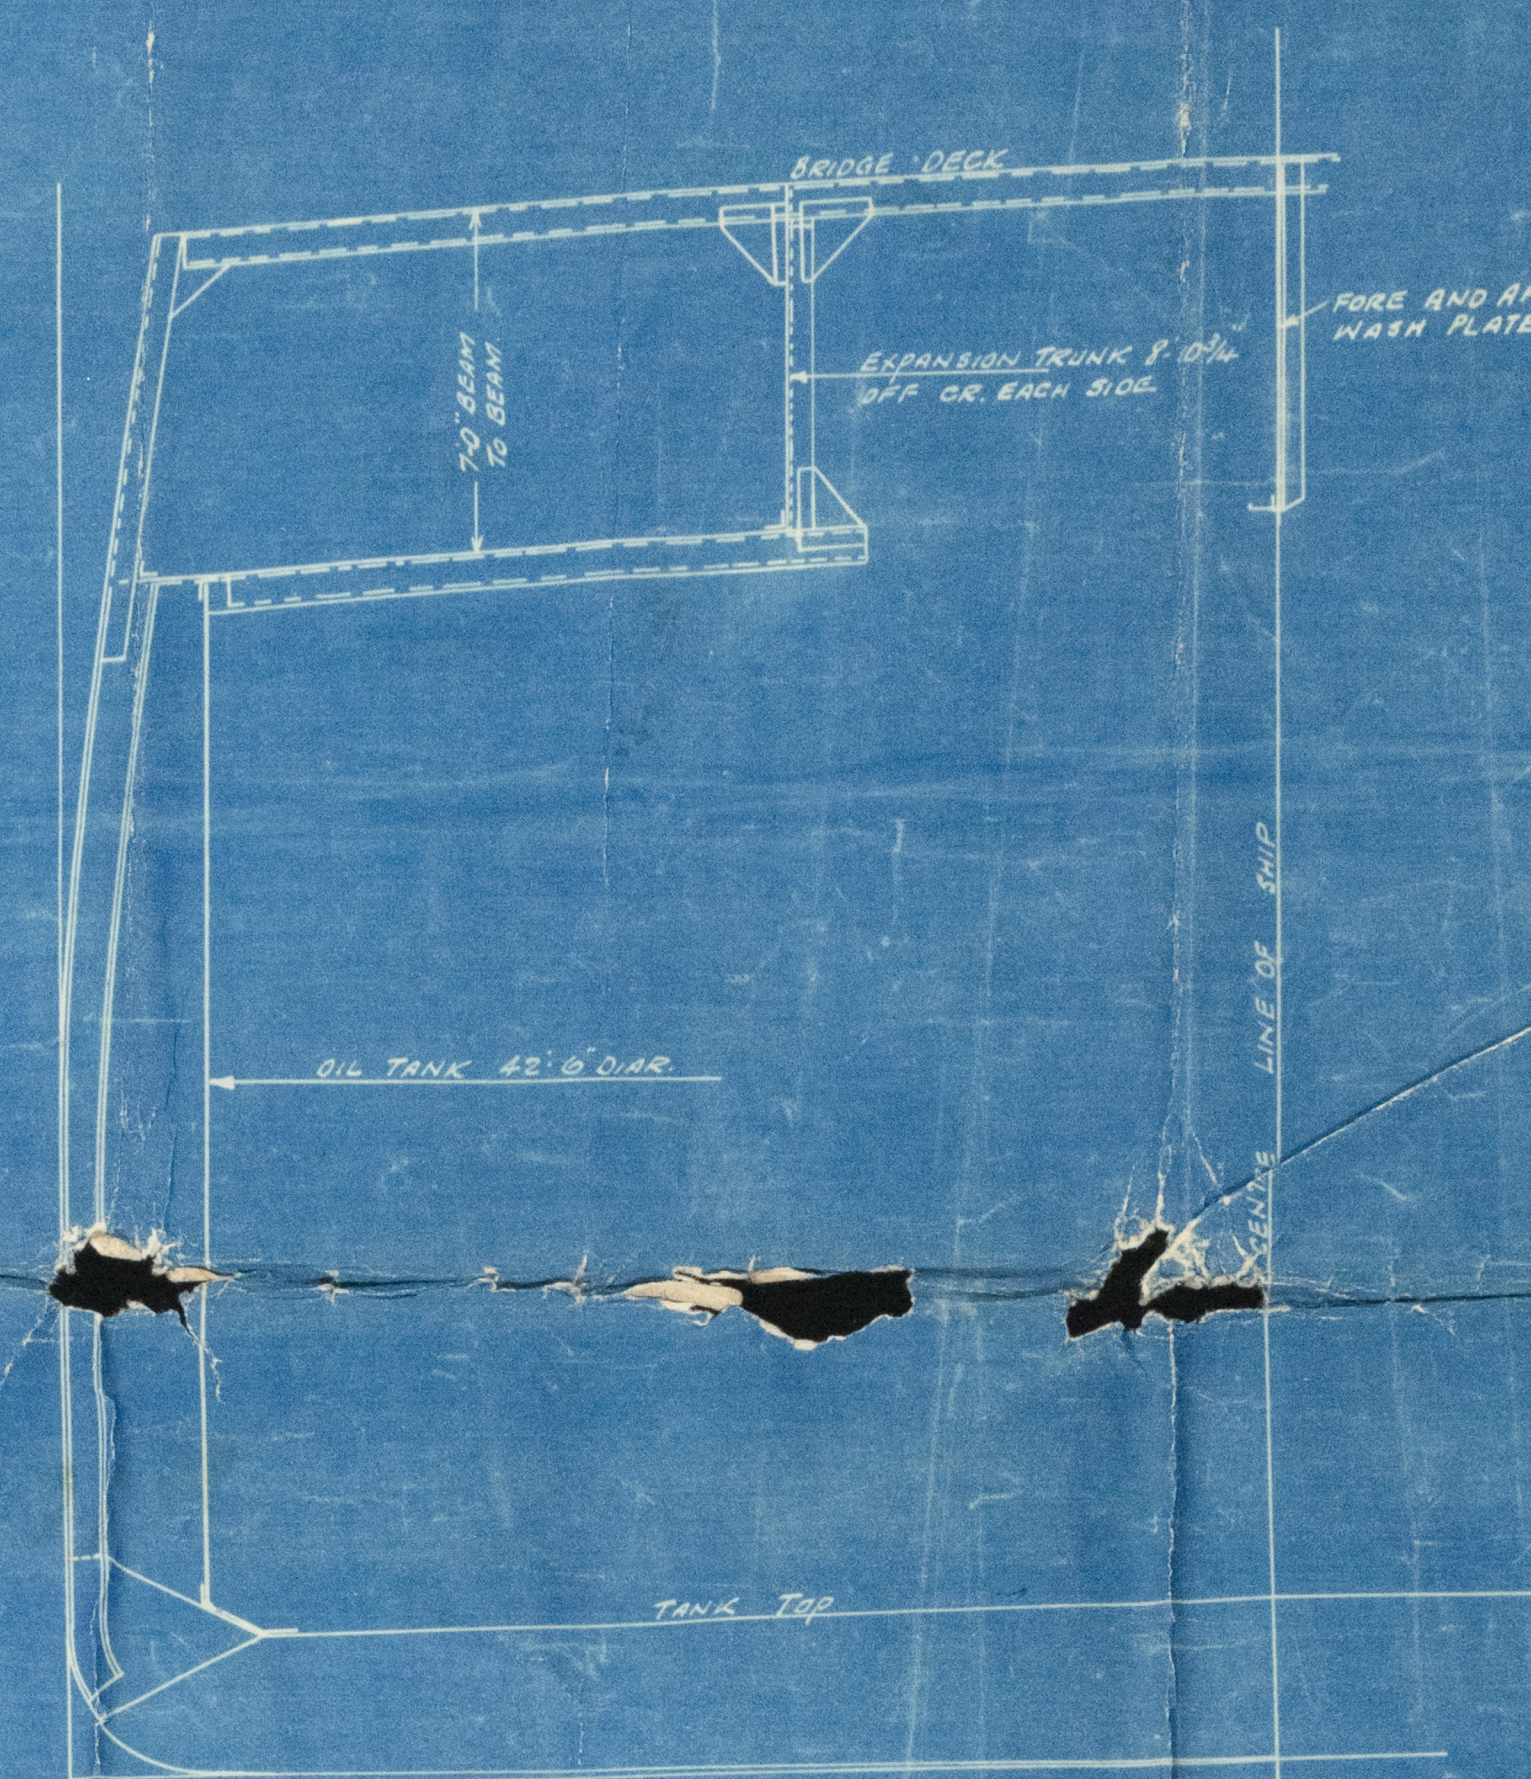

SECTIONAL ELEVATION

SECTIONAL PLAN OF TANKS

PLAN OF UPPER DECK

1/2 SECTION THRO' OIL TANKS
SCALE 1/4" = 1'-0"

002830 - 002837 - 0001

Profile Deck Plan (as Bittor).

R. Duncan Co. hd. No 334.

5
20. 05
16

sp. Gobco

GREENOCK Report No. 17786.

002830-002837-0001



© 2021
Lloyd's Register
Foundation