


M.V. "EVINA"
No 1060
PROFILE & DECKS PLAN.
SCALE $\frac{1}{8}" = 1 \text{ FOOT}$
MOULDED DIMENSIONS 59'5"0", 54'9"0", 32'0"

 

NEWCASTLE-UPON-TYNE.
No. 24087 DATE 26/3/21
WALKER SHIPYARD


Profile & deck plan
as built

M.V. "Evina"

Armstrong Whitworth

KP-1060

002830-002831-0090

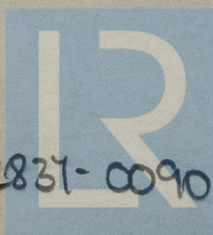

© 2021

Lloyd's Register
Foundation