
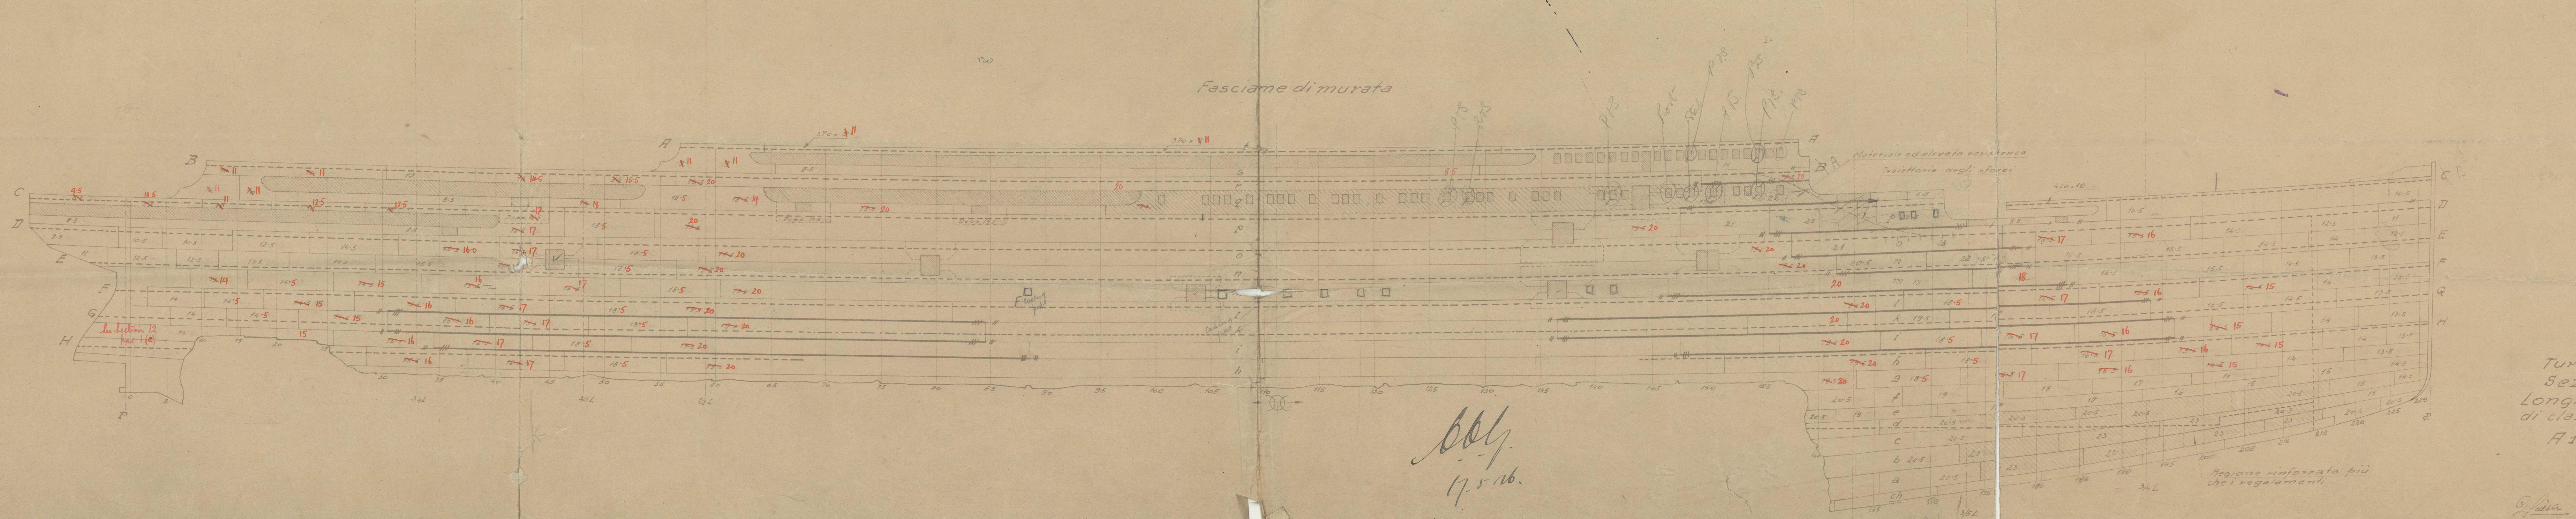
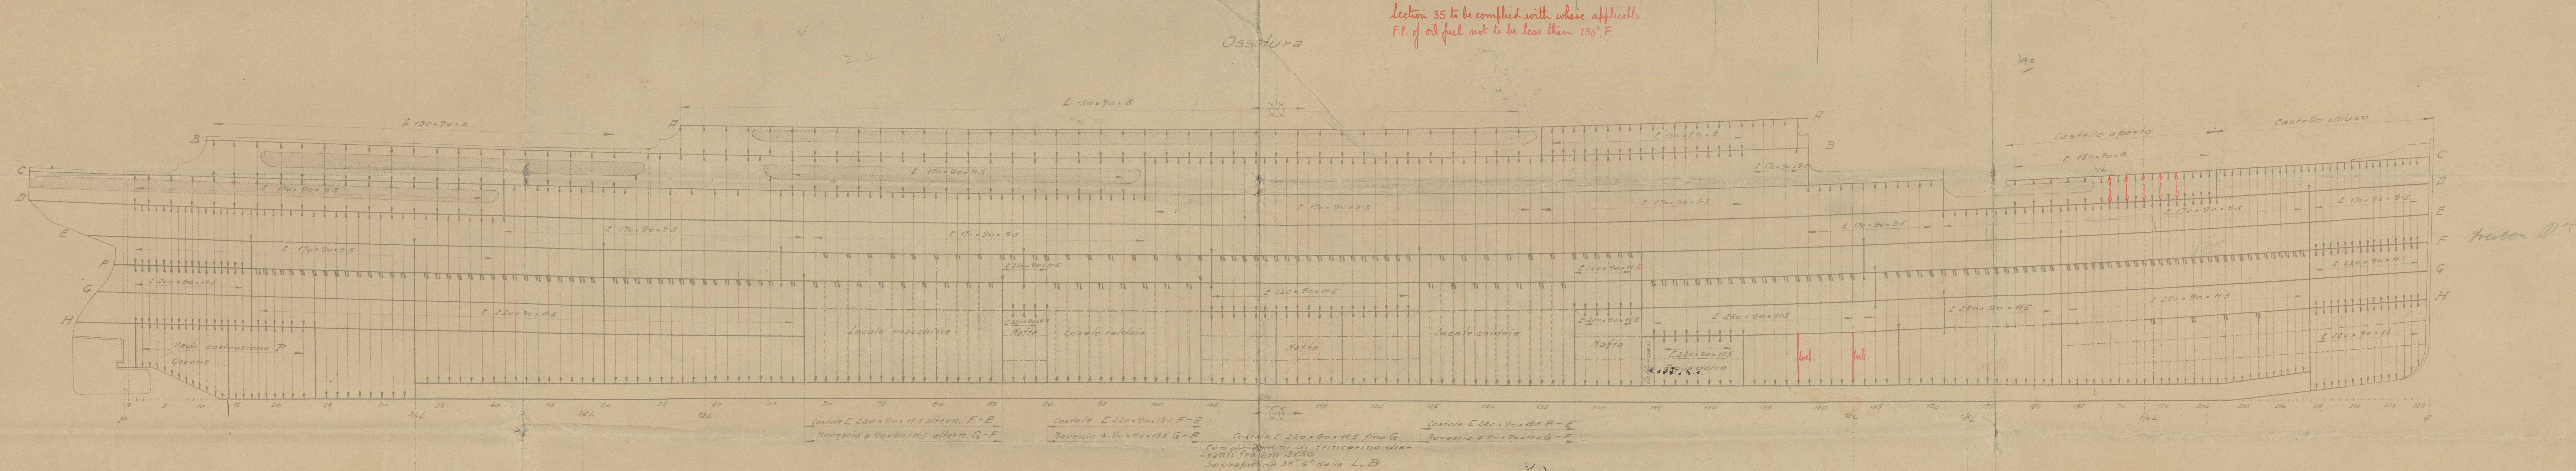


18/5/26

TURBONAVE N° 764

Scala 1:200

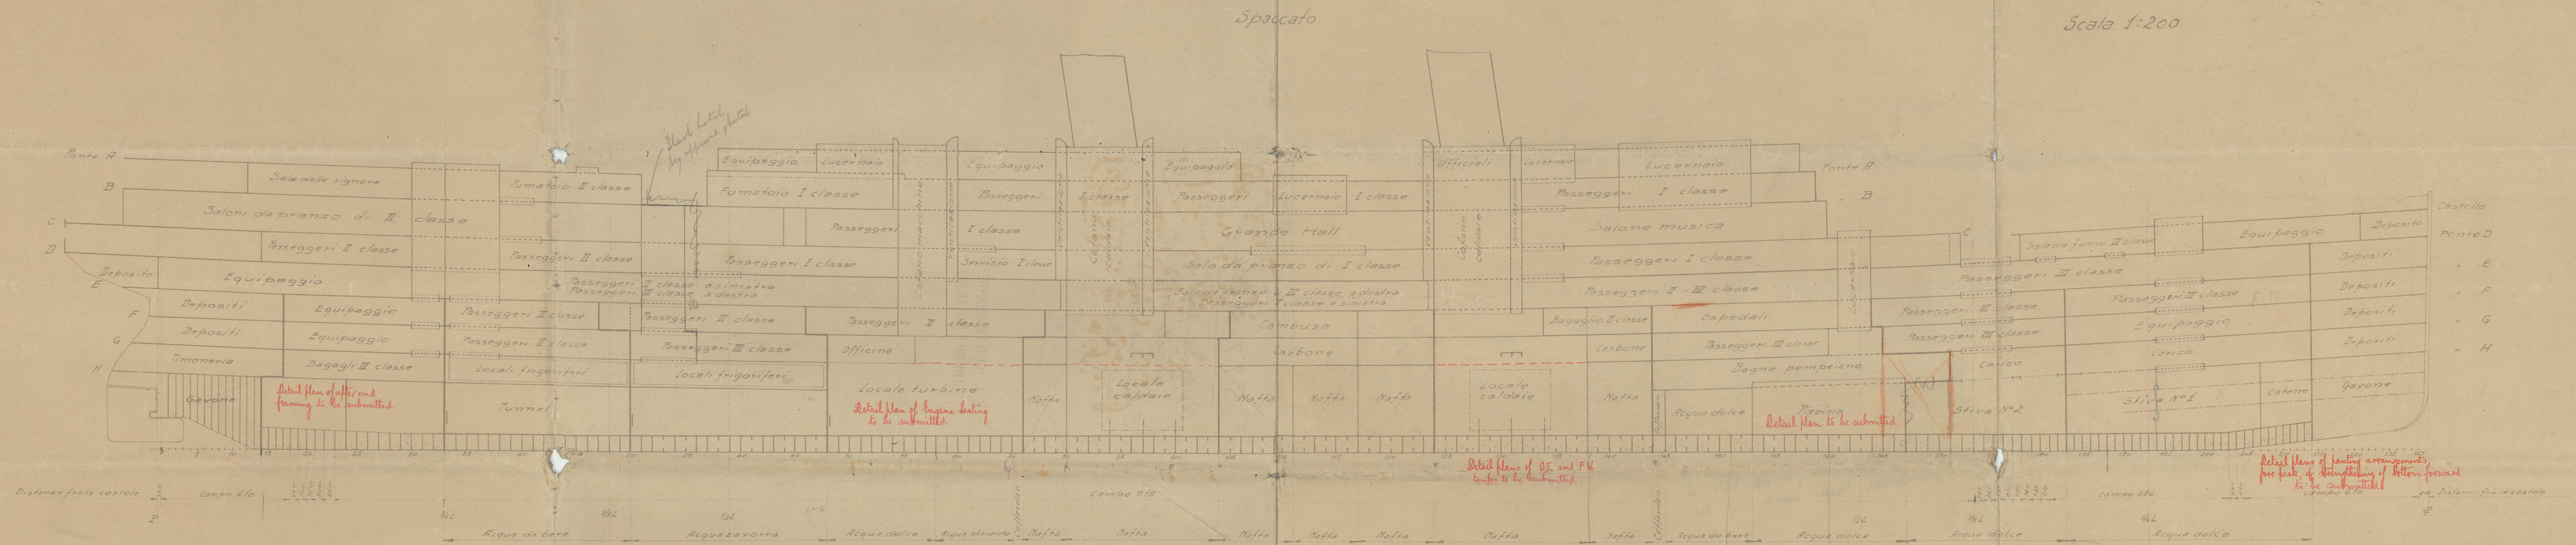

764
Turbonave
Sezioni
Longitudinali
di classifica
A-14
1:200
2 Aprile 1926
© 2021
Lloyd's Register
Foundation

S.T.T NO 764

Approved plan of
Profile & Shell
Expansion top structure
London dated 18/5/26

NO 6

S.S. "CONTE GRANDE"
TRI RPT NO 7869.

-D. 348

002830-002837-0150



© 2021

Lloyd's Register
Foundation