


23/12/19

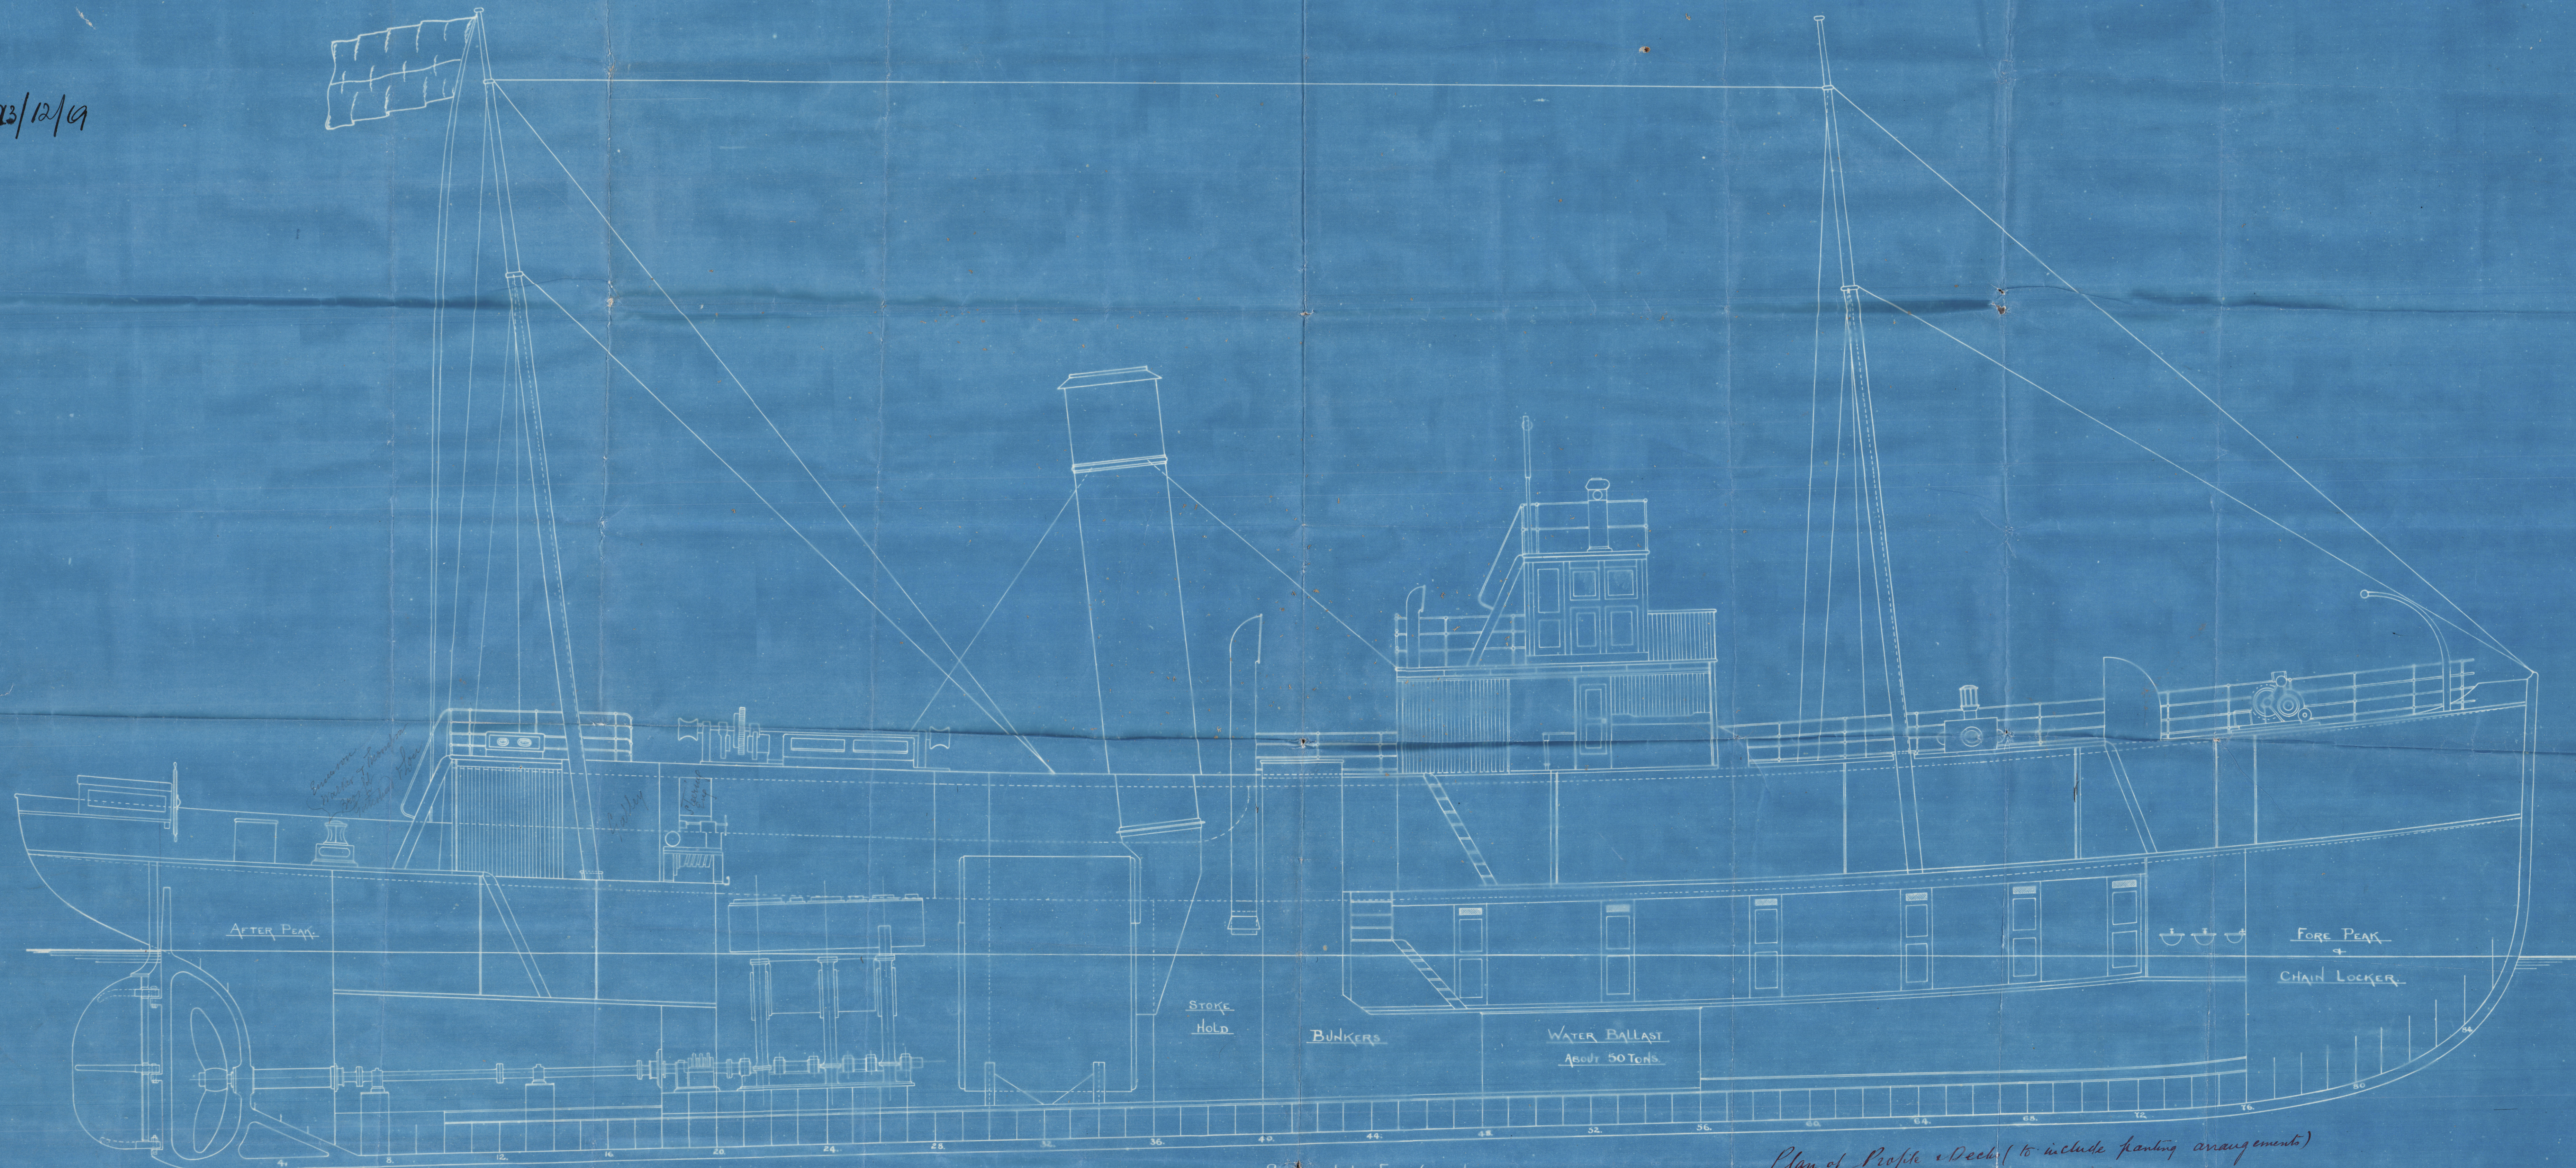

SECTIONAL ELEVATION.

Plan of Profile Deck (to include painting arrangements)
to be submitted
(showing steelwork)

J. H. H.
27.12.19


GENERAL ARRANGEMENT OF STEEL SINGLE SCREW PILOT STEAMER.

SCALE $\frac{1}{4}$ = 1 FOOT.

LENGTH O.A. 153'-6" B.P. 144'-8" BEAM M.L. 27'-6" DEPTH M.L. 14'-0"

BOAT N^o 582.

8131 - S.

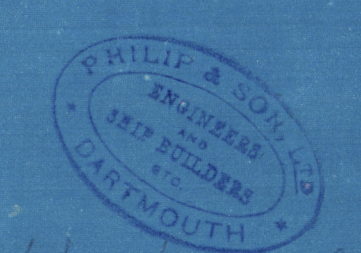

GENERAL ARRANGEMENT

Pilot Vessel No. 582.

Philip & Son Ltd; Dartmouth

Name of Vessel - "James H Beazley"

Ply. Rpt. No: 6110



© 2020

Lloyd's Register
Foundation