

~ MIDSHIP SECTION. ~

STEEL SCREW TRAWLERS.

~ Nos 1099 ~

DIMNS: 150'-0" B.P. x 25'-6" EXT. x 14'-0" MLD.

1/2" SCALE.

TO CLASS + 100 A1 STEAM TRAWLERS.

NUMERALS.

L x D ----- 2100.
L x (B + D) ----- 5906.

RIVETING.

ALL LANDING EDGES TO BE DOUBLE RIVETED,
EXCEPT TOP EDGE OF SHEERSTRAKE, WHICH
SHALL BE SINGLE RIVETED.
BUTTS OF SHEERSTRAKE STRAPPED AND
TREBLE RIVETED FOR 1/2 LENGTH.
BUTTS OF E AND F STRAKES OVERLAPPED
AND TREBLE RIVETED FOR 1/2 LENGTH
REMAINDER TO BE DOUBLE RIVETED.

PLAN No. 4504.


FOR ENCLOSURE TO

Messrs The Surveyors
Lloyd's Register of Shipping

FROM
COCHRANE & SONS, LTD.

SHIPBUILDERS SELBY.

DATE 16/7/30

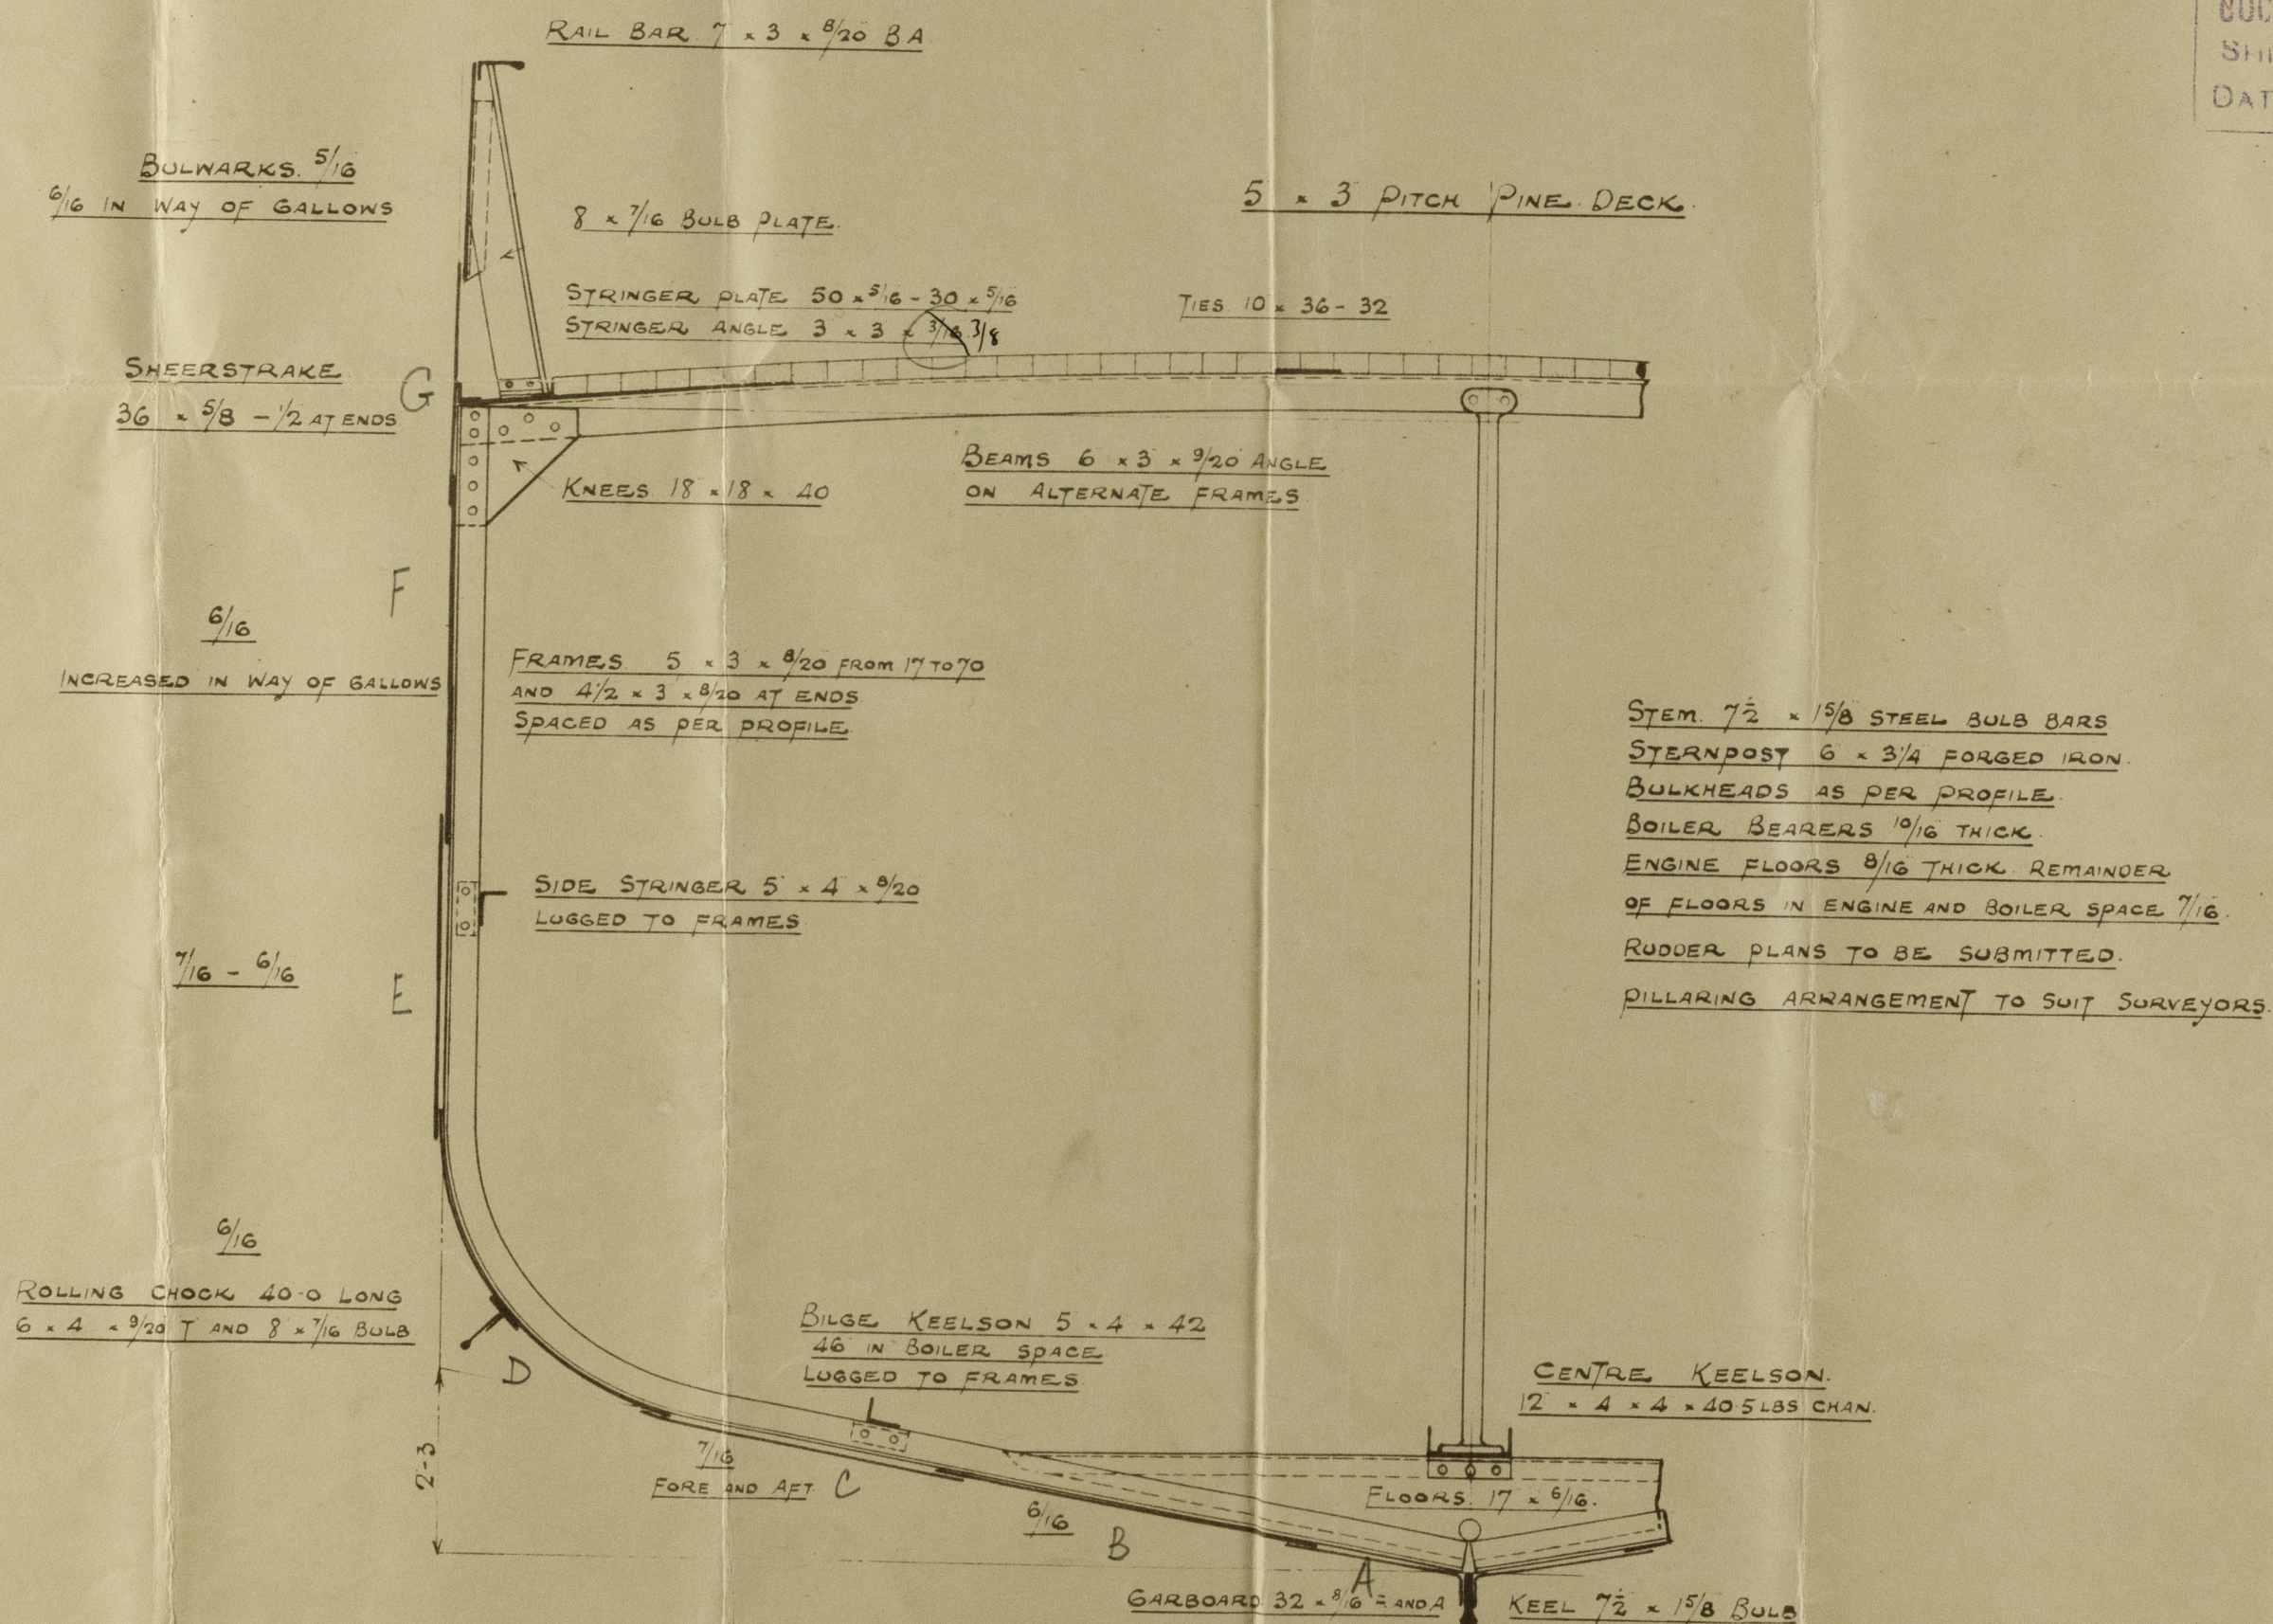

N^o 1099.

Midship Section

Cochranes Survs to

S.S. "Lord Beaverbrook"

HULL REPORT NO. 41516.

© 2020

Lloyd's Register
Foundation

002838-002845-0134