


PROFILE & DECKS.

S.S. "JAMAICA PRODUCER."

SCALE 1/8" = 1'-0"

DIMS. 410' 0" ON L.W.L. x 24' 0" MLD. x 23' 0" MLD. TO UPPER DECK.
TO CLASS 100A1, WITH FREEBOARD AT HULLS SPECIAL SURVEY (COMPLETE SUPERSTRUCTURE TYPE).
NOTE: FORE END TO BE SPECIALLY STRENGTHENED FOR NORTH ATLANTIC TRAFFIC.


SHEER	FORWARD	1' 00"
	1/2 L. FORE	1' 30"
	AFT	1' 30"
	1/2 L. AFT	1' 00"
DISPLACEMENT	CO. EFF.	1' 00"
ROUND OF BEAM		1' 10"

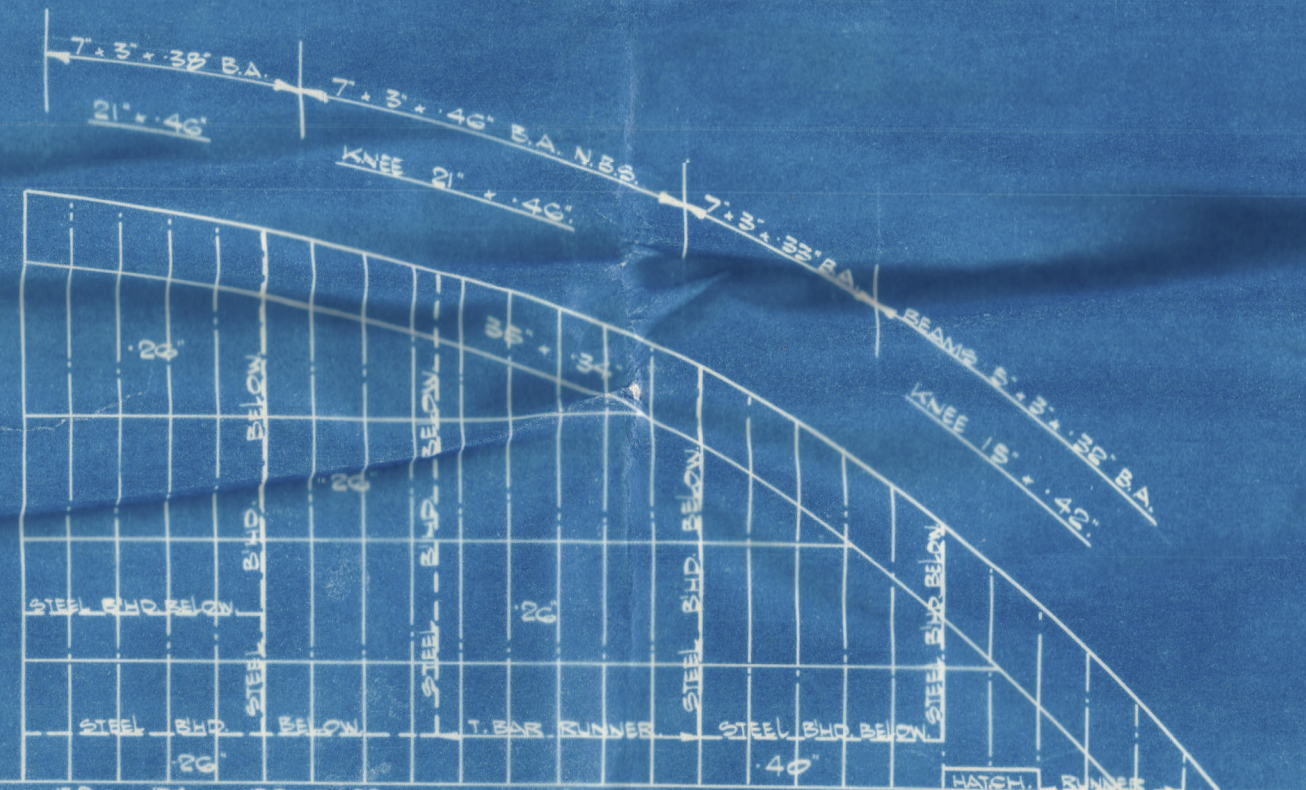

FORECASTLE DECK
STRENGTHENED WITH 8" x 8" B.E.
BULKHEADS WIDENED
SPECIALLY STRENGTHENED UNDER GUNS
PILARS 6" x 6" DIA. SOLID

SCANTLING AND DETAIL OF CONSTRUCTION NOTED HEREON ARE
SUBMITTED ON THE UNDERSTANDING THAT THEY ARE THE MINIMUM
WHICH WILL BE ACCEPTED FOR CLASS, AND IF NOT THEY ARE TO
BE AVOIDED, ERRORS AND OMISSIONS EXCEPTED.

PLAN OF HATCHES, GIRDERS & PILARS, N.T. BULKHEADS, SHAFT
TUNNEL, AND FORE END STRENGTHENING WILL BE SUBMITTED.

 


LITHGOWS LIMITED.

Nº 868.

"JAMAICA PRODUCER"

PROFITE & DECKS
(AS BUILT).

GRK. FIRST ENTRY REPORT Nº 19464.

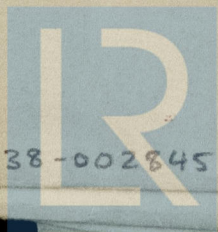

© 2020

002838-002845-0152

Lloyd's Register
Foundation