


15/10/33

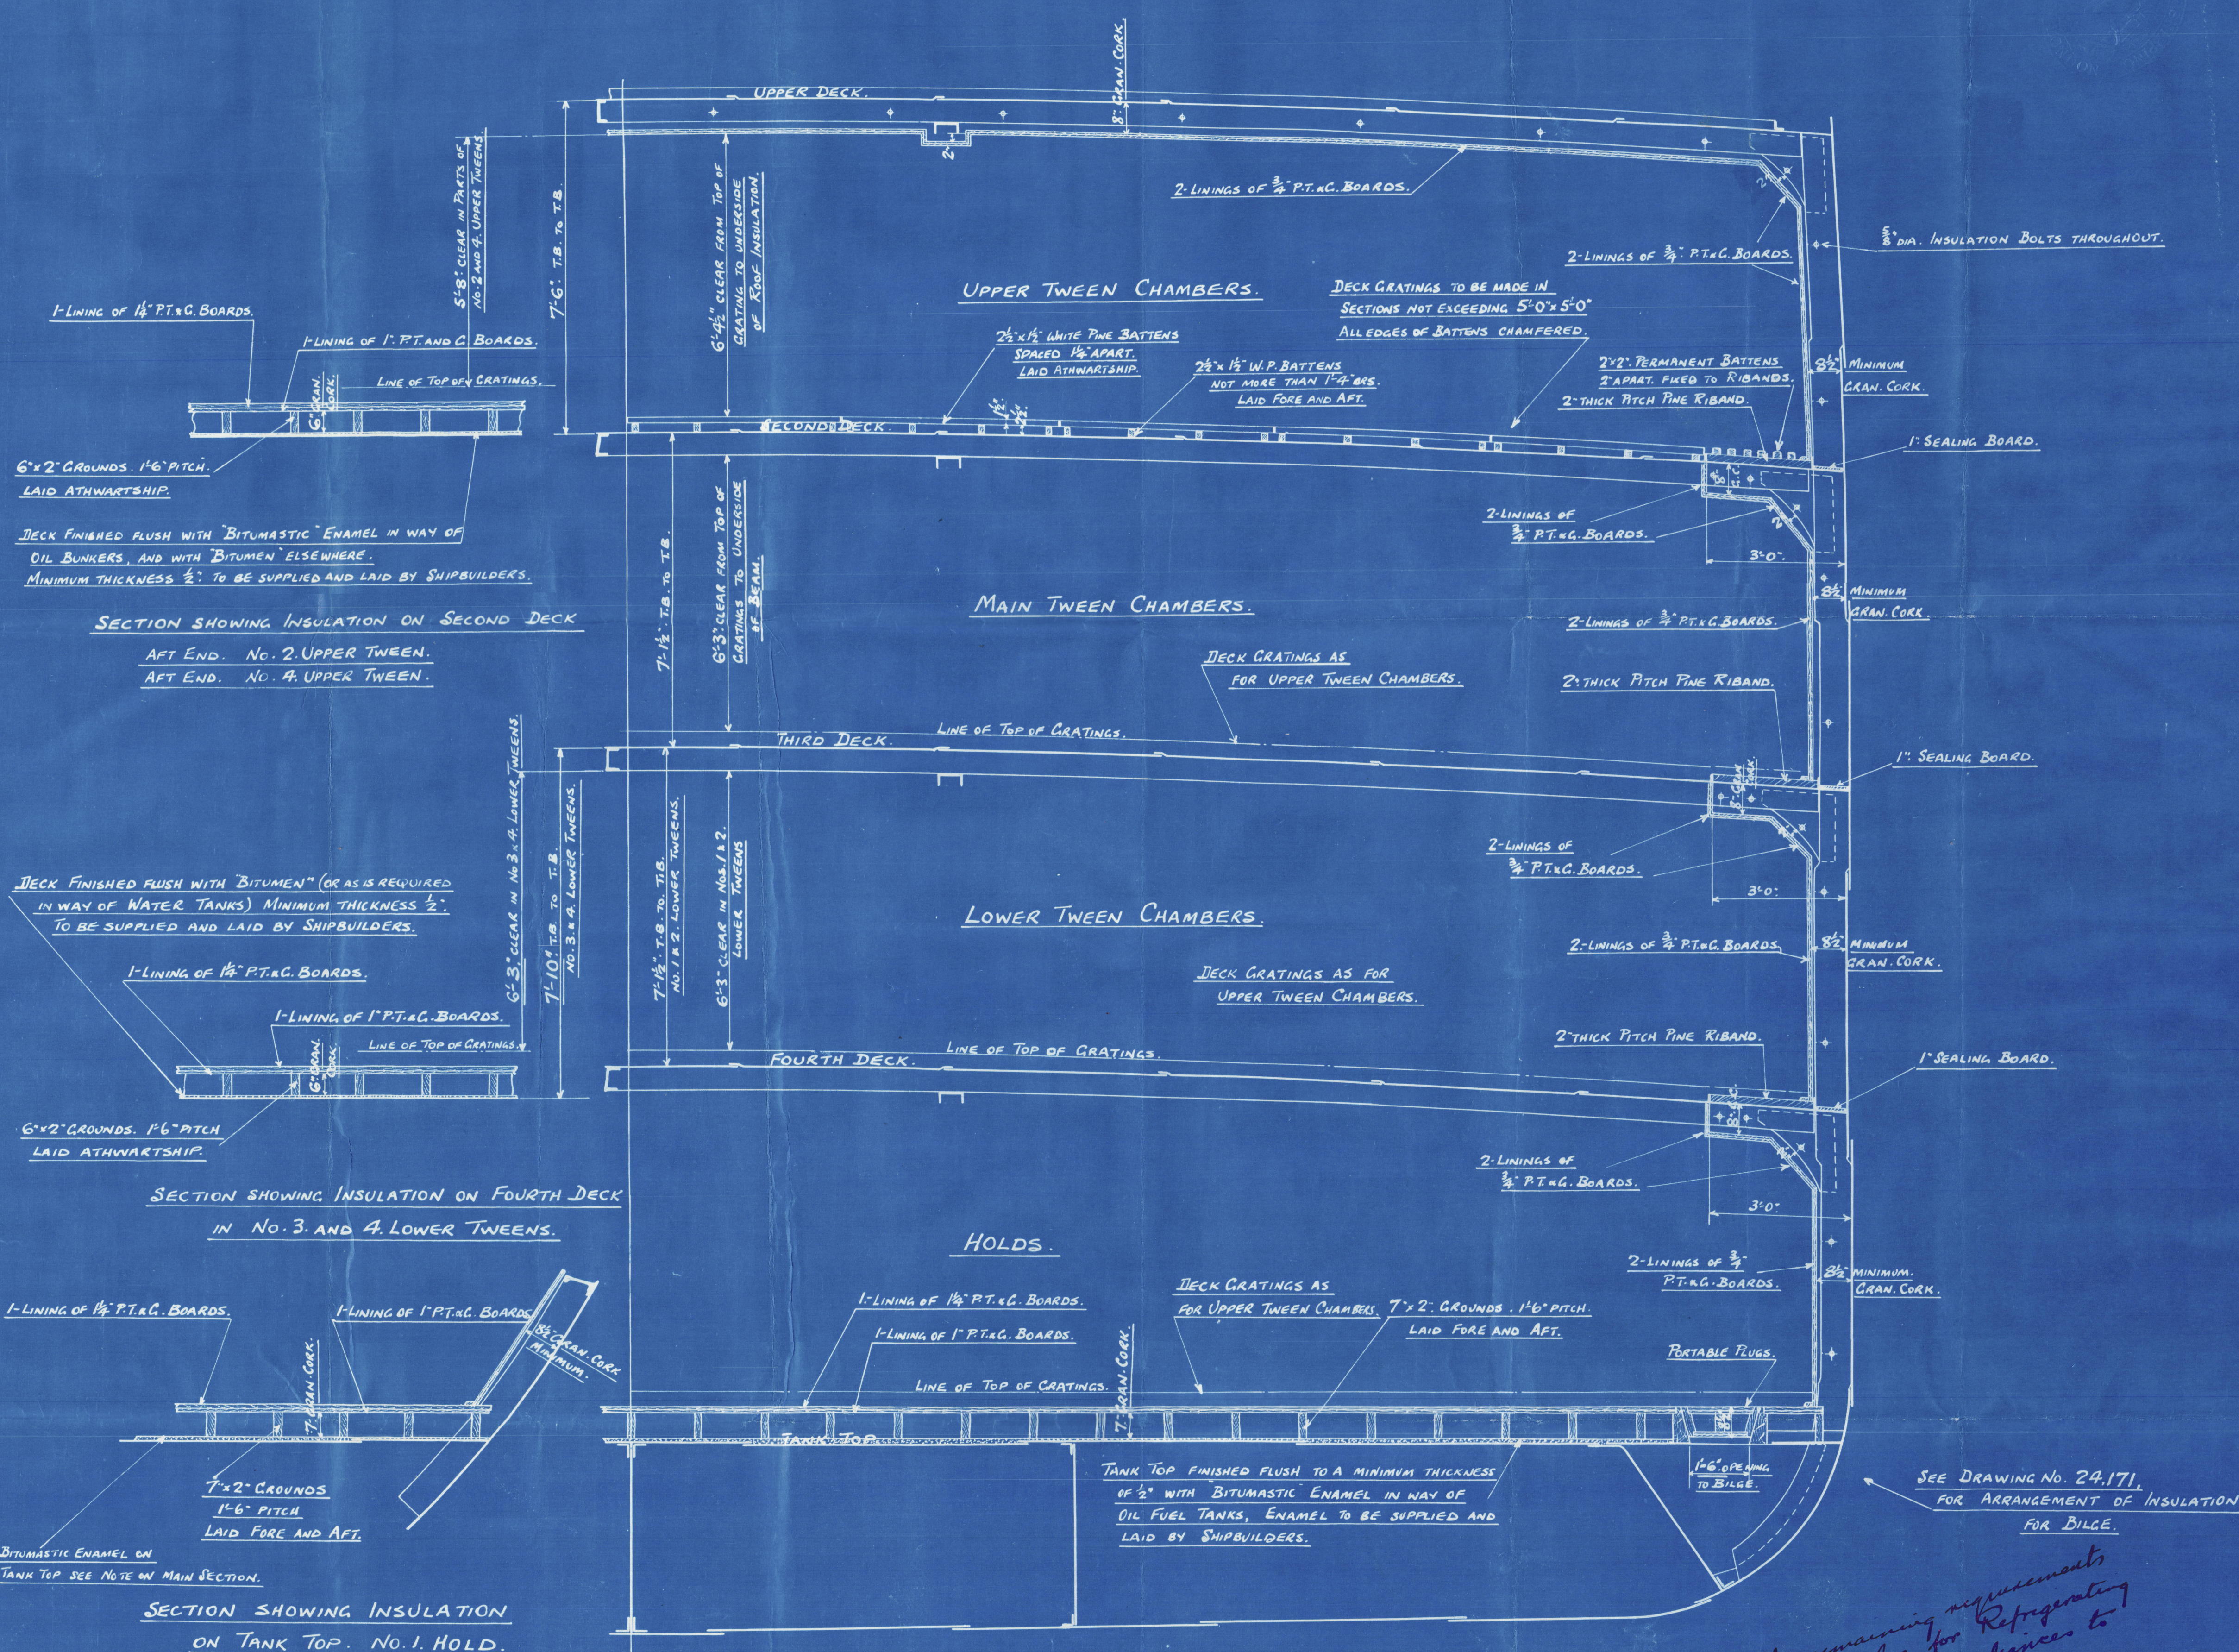

MIDSHIP SECTION SHOWING INSULATION OF BANANA CARRYING VESSEL.

Messrs Lithgow's no 868.

Insulation Plan - midship section.



© 2020

Lloyd's Register
Foundation

002838-002845-0204