

11-10-11  
25-11-11

SHEET 4-5

LENGTH OF POOP 31'25"

SHEET 4-6

SHEET 4-7

SHEET 4-8

SHEET 4-9

SHEET 4-10

SHEET 4-11

SHEET 4-12

# LONGITUDINAL SECTION

SCALE 3/16"=1'-0"  
CLASS 100A LLOYDS


RULE DIMENSIONS 58'37" x 49'37" x 24'0"

UNDERDECK TONNAGE ABOUT 3190 TONS

BREADTH AT UPPER DECK 43'-6"

Winches and windlass supported to Surveyors satisfaction  
LENGTH OF BRIDGE 210'35"

FORECASTLE 56'53" LONG

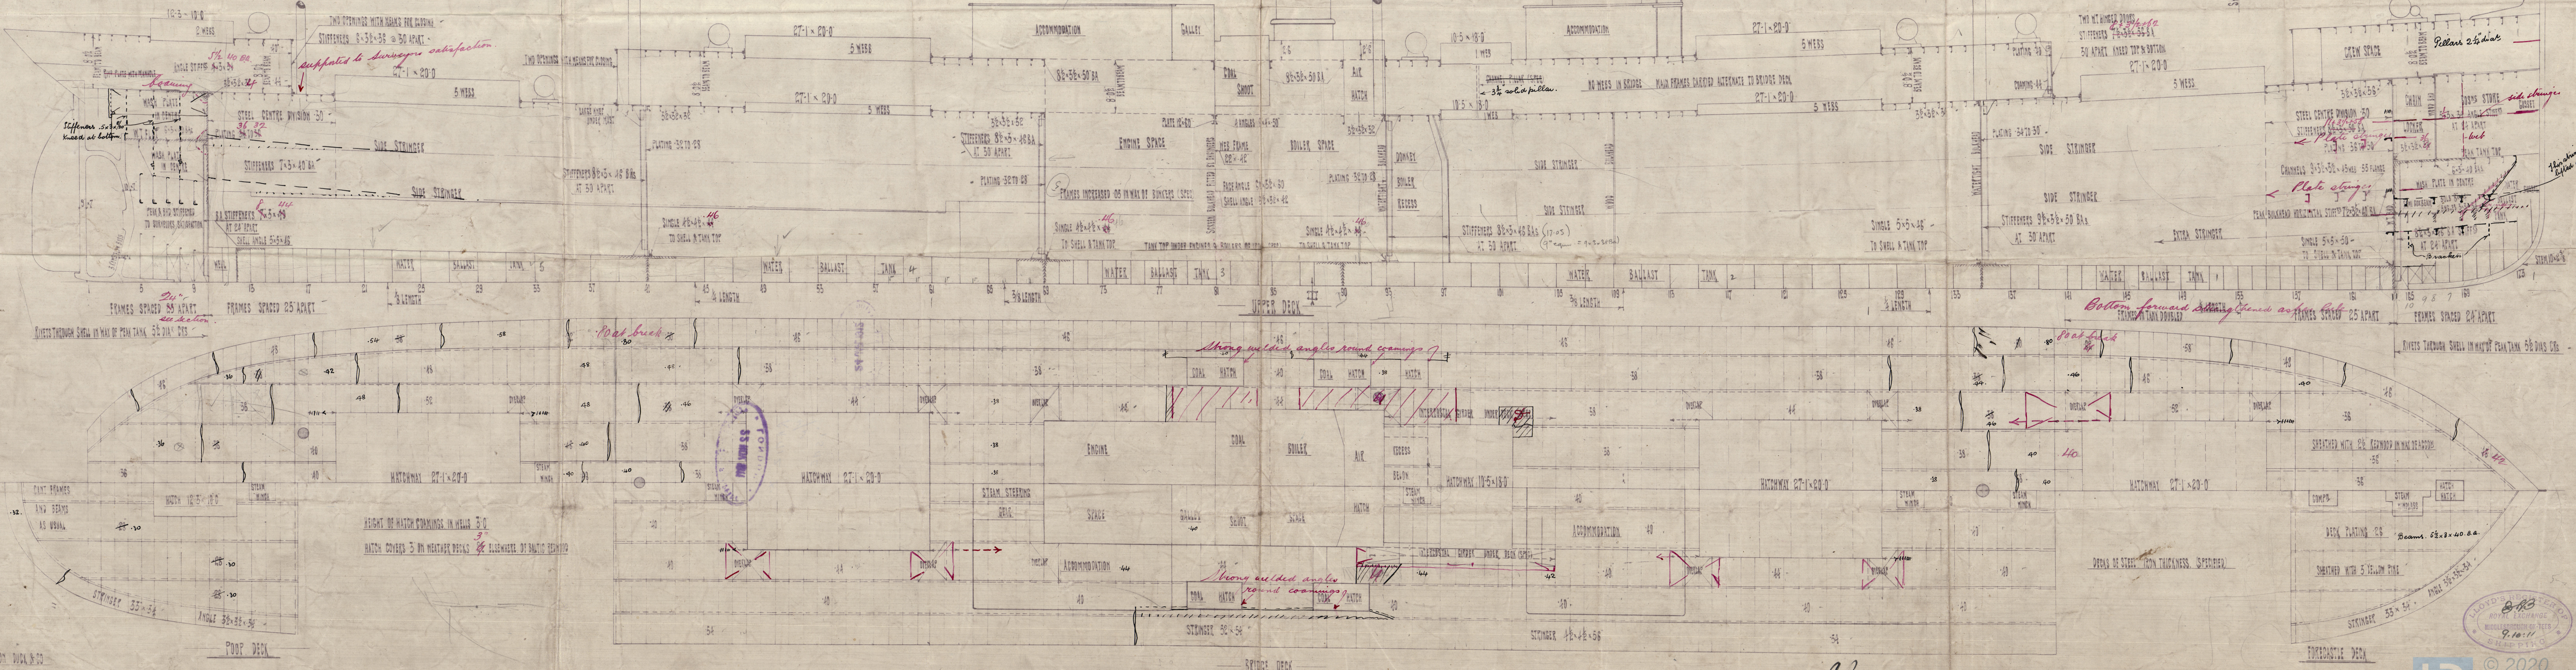

RICHARDSON, DUBA & CO  
SHIPBUILDERS  
STOCKTON ON TEES  
TRADING NO 2405  
Oct 5<sup>th</sup> 1911.

C.F.  
11-10-11



© 2020  
N°625  
Lloyd's Register  
Foundation  
002838-002845-0207




Messrs Richardson Buck & Co.

No 26

Profile & Deck Plans

"Hoveington"

Mar Report

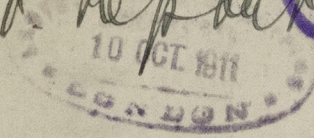

RAMIZ \*  
M/N  
"ISMEI"



© 2020

Lloyd's Register  
Foundation

002838-002845-0207