

25. 8. 13


N^{os} 801 & 2 Fore Peak Framing

Scale 1/2" = 1 Foot


CAMMELL LAIRD & CO LTD
BIRKENHEAD.
FOR ENCLOSURE TO
Lloyds
PLAN No 28
DATE AUG 18 1913
SHIP DEPARTMENT.

NOTES REGISTER OF SHIPBUILDING
LONDON
22 AUG 1913


NOTED & RETURNED
AUG 28 1913
CAMMELL LAIRD & CO LTD
BIRKENHEAD.

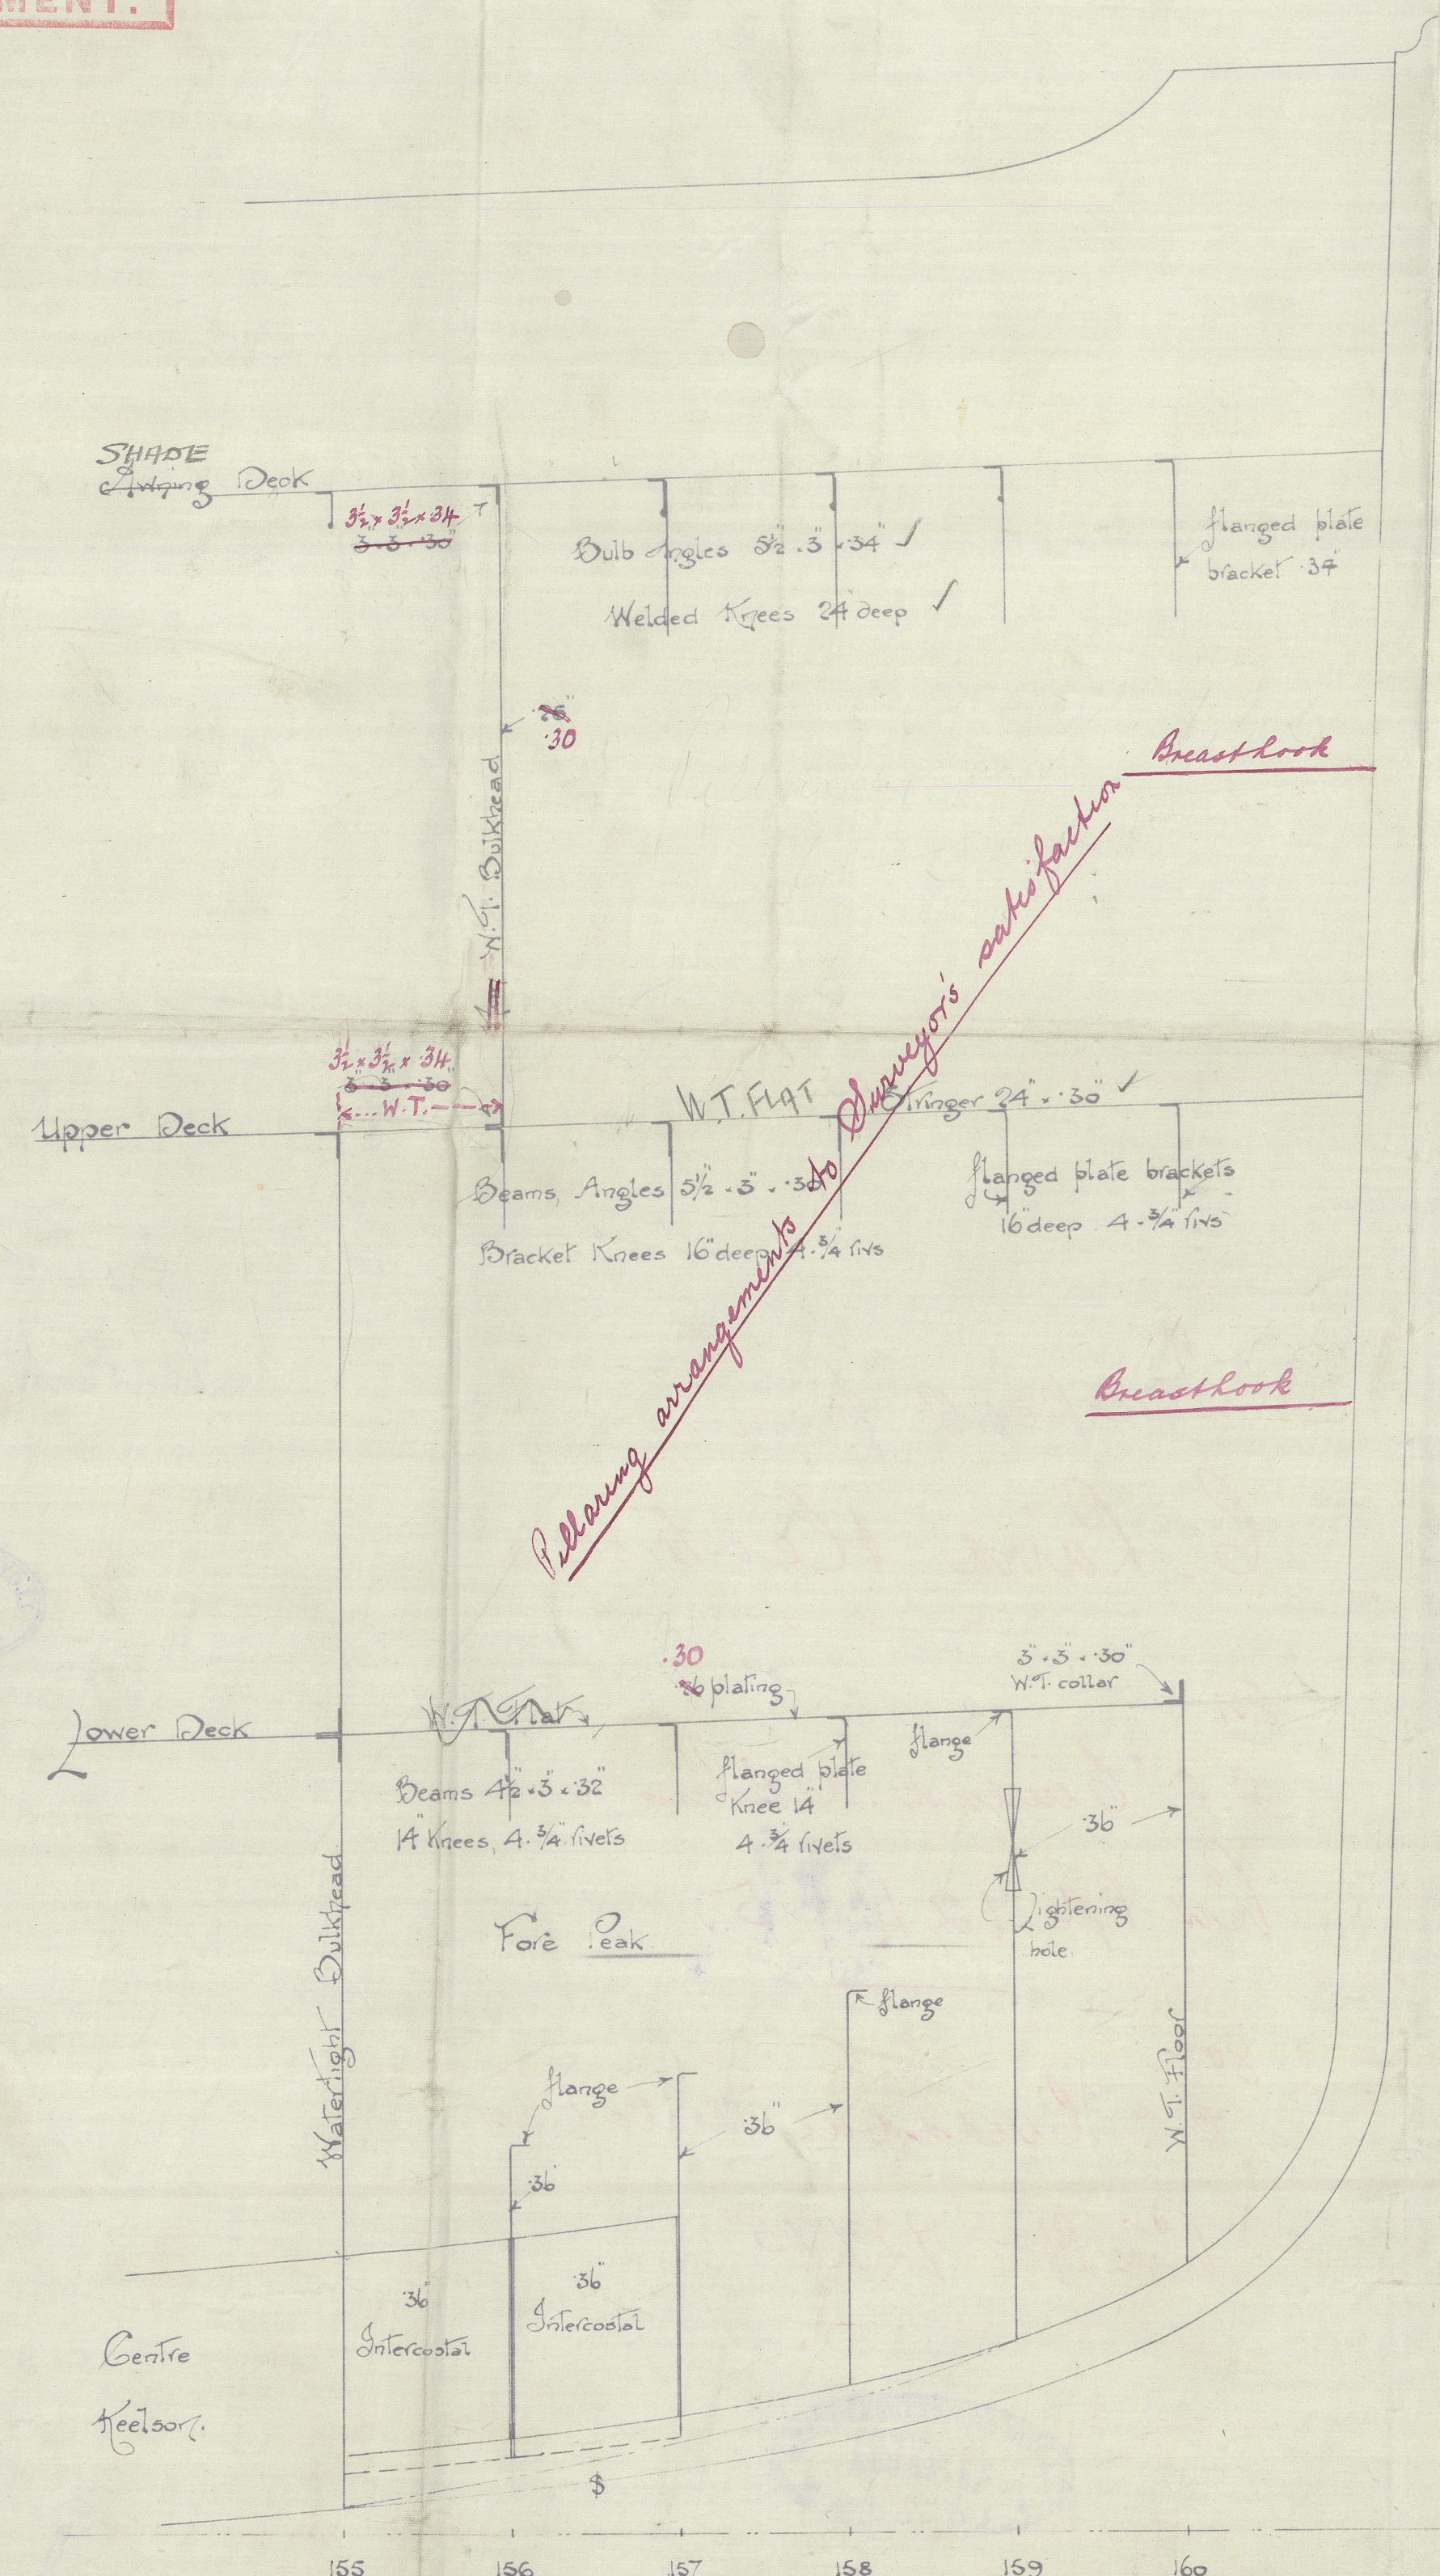


Upper Deck
Reverse Frame to Fore
angle 5.5.30
Reverse Frame to Fore
angle 5.5.30
Reverse Frame to Fore
angle 5.5.30
Reverse Frame to Fore
angle 5.5.30
Reverse Frame to Fore
angle 5.5.30

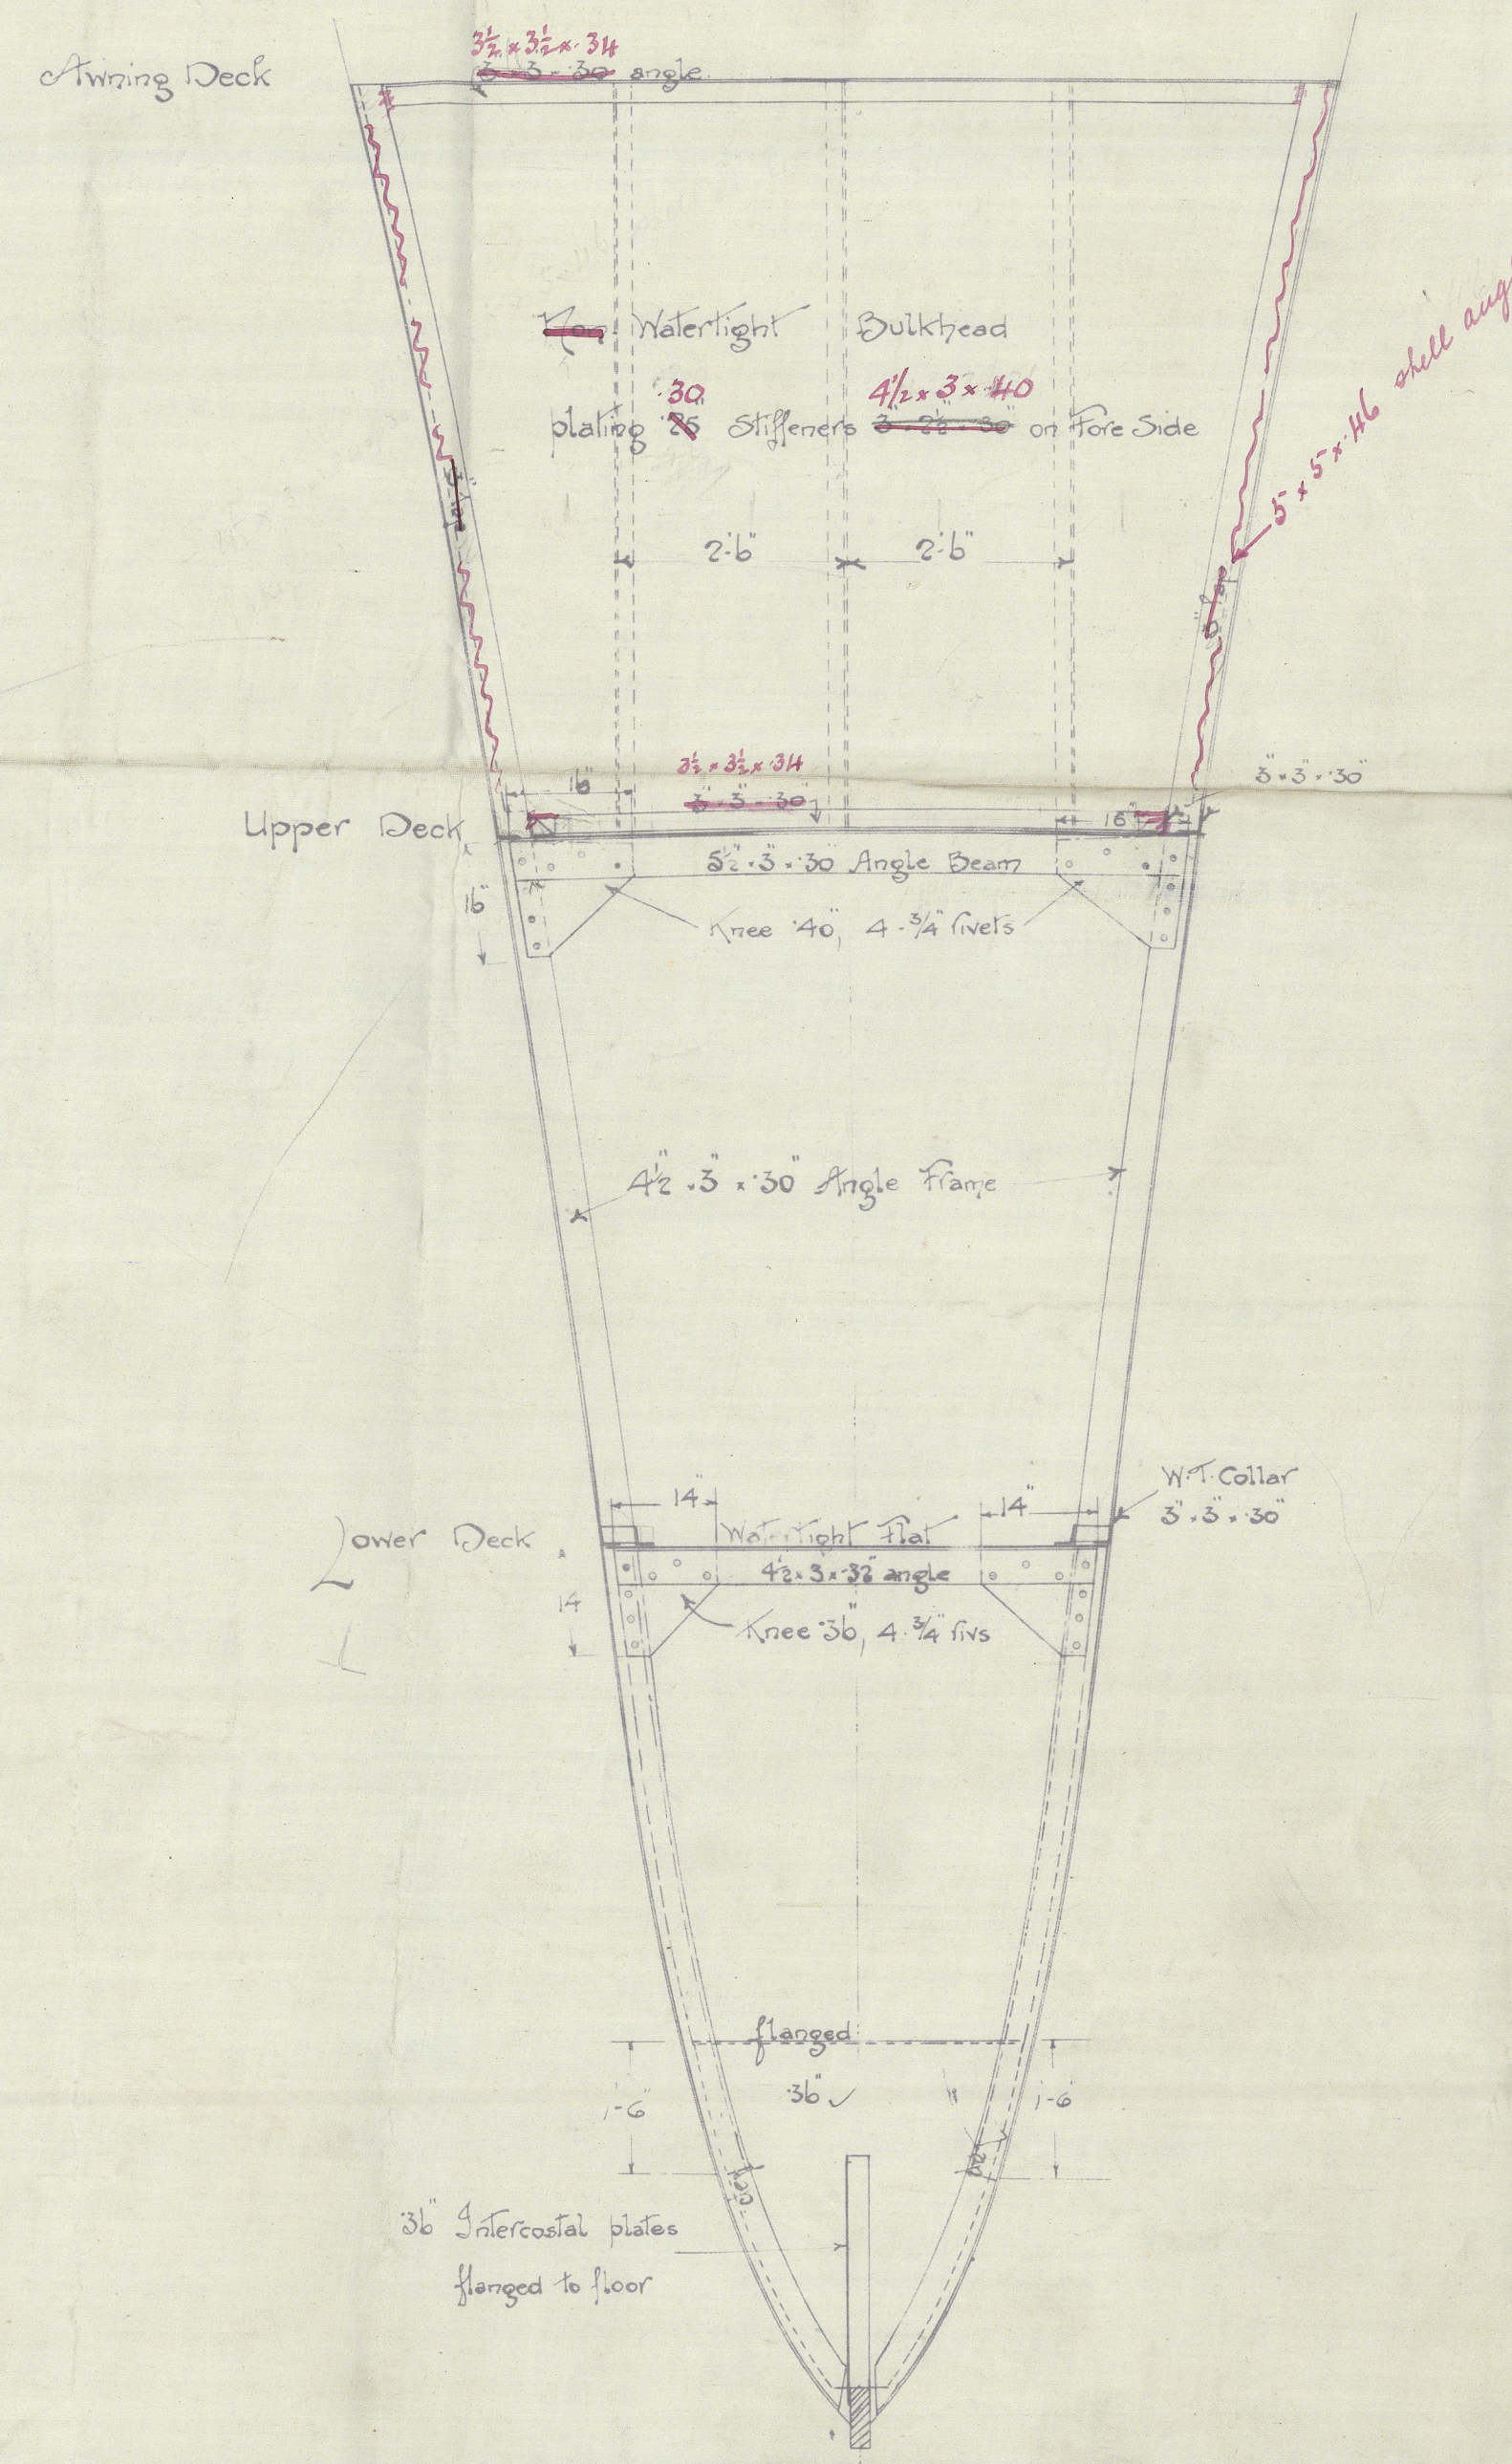


156

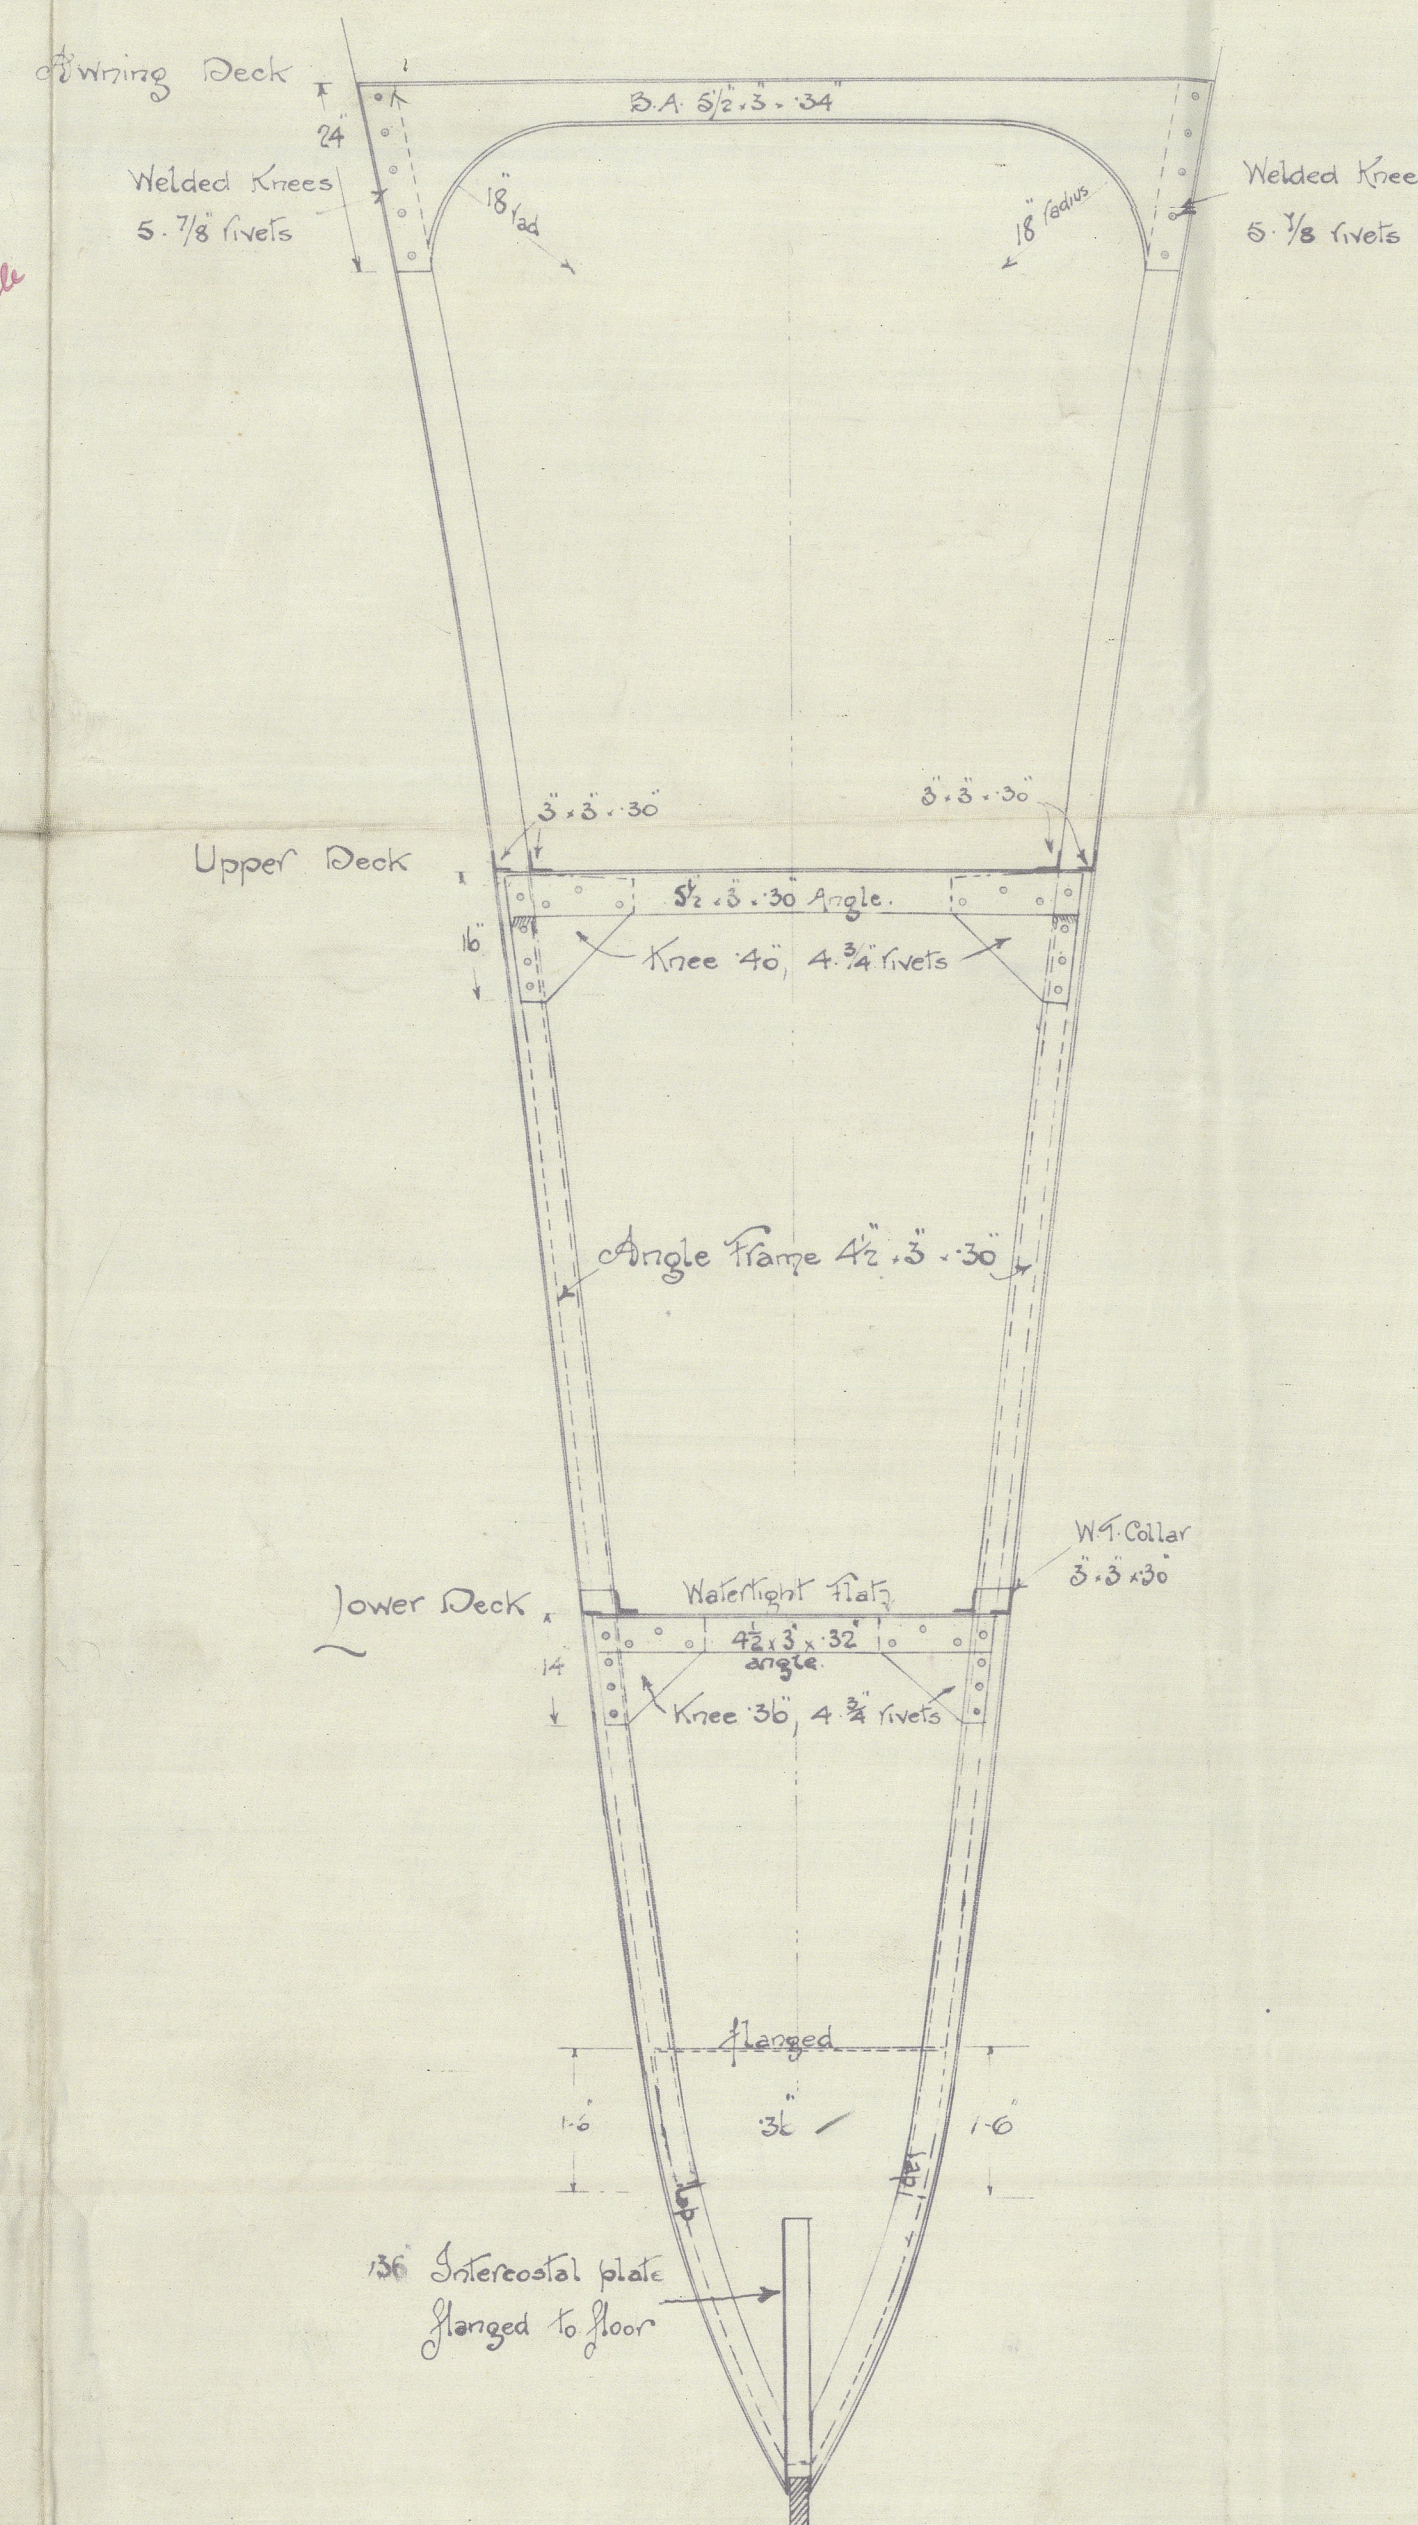


157

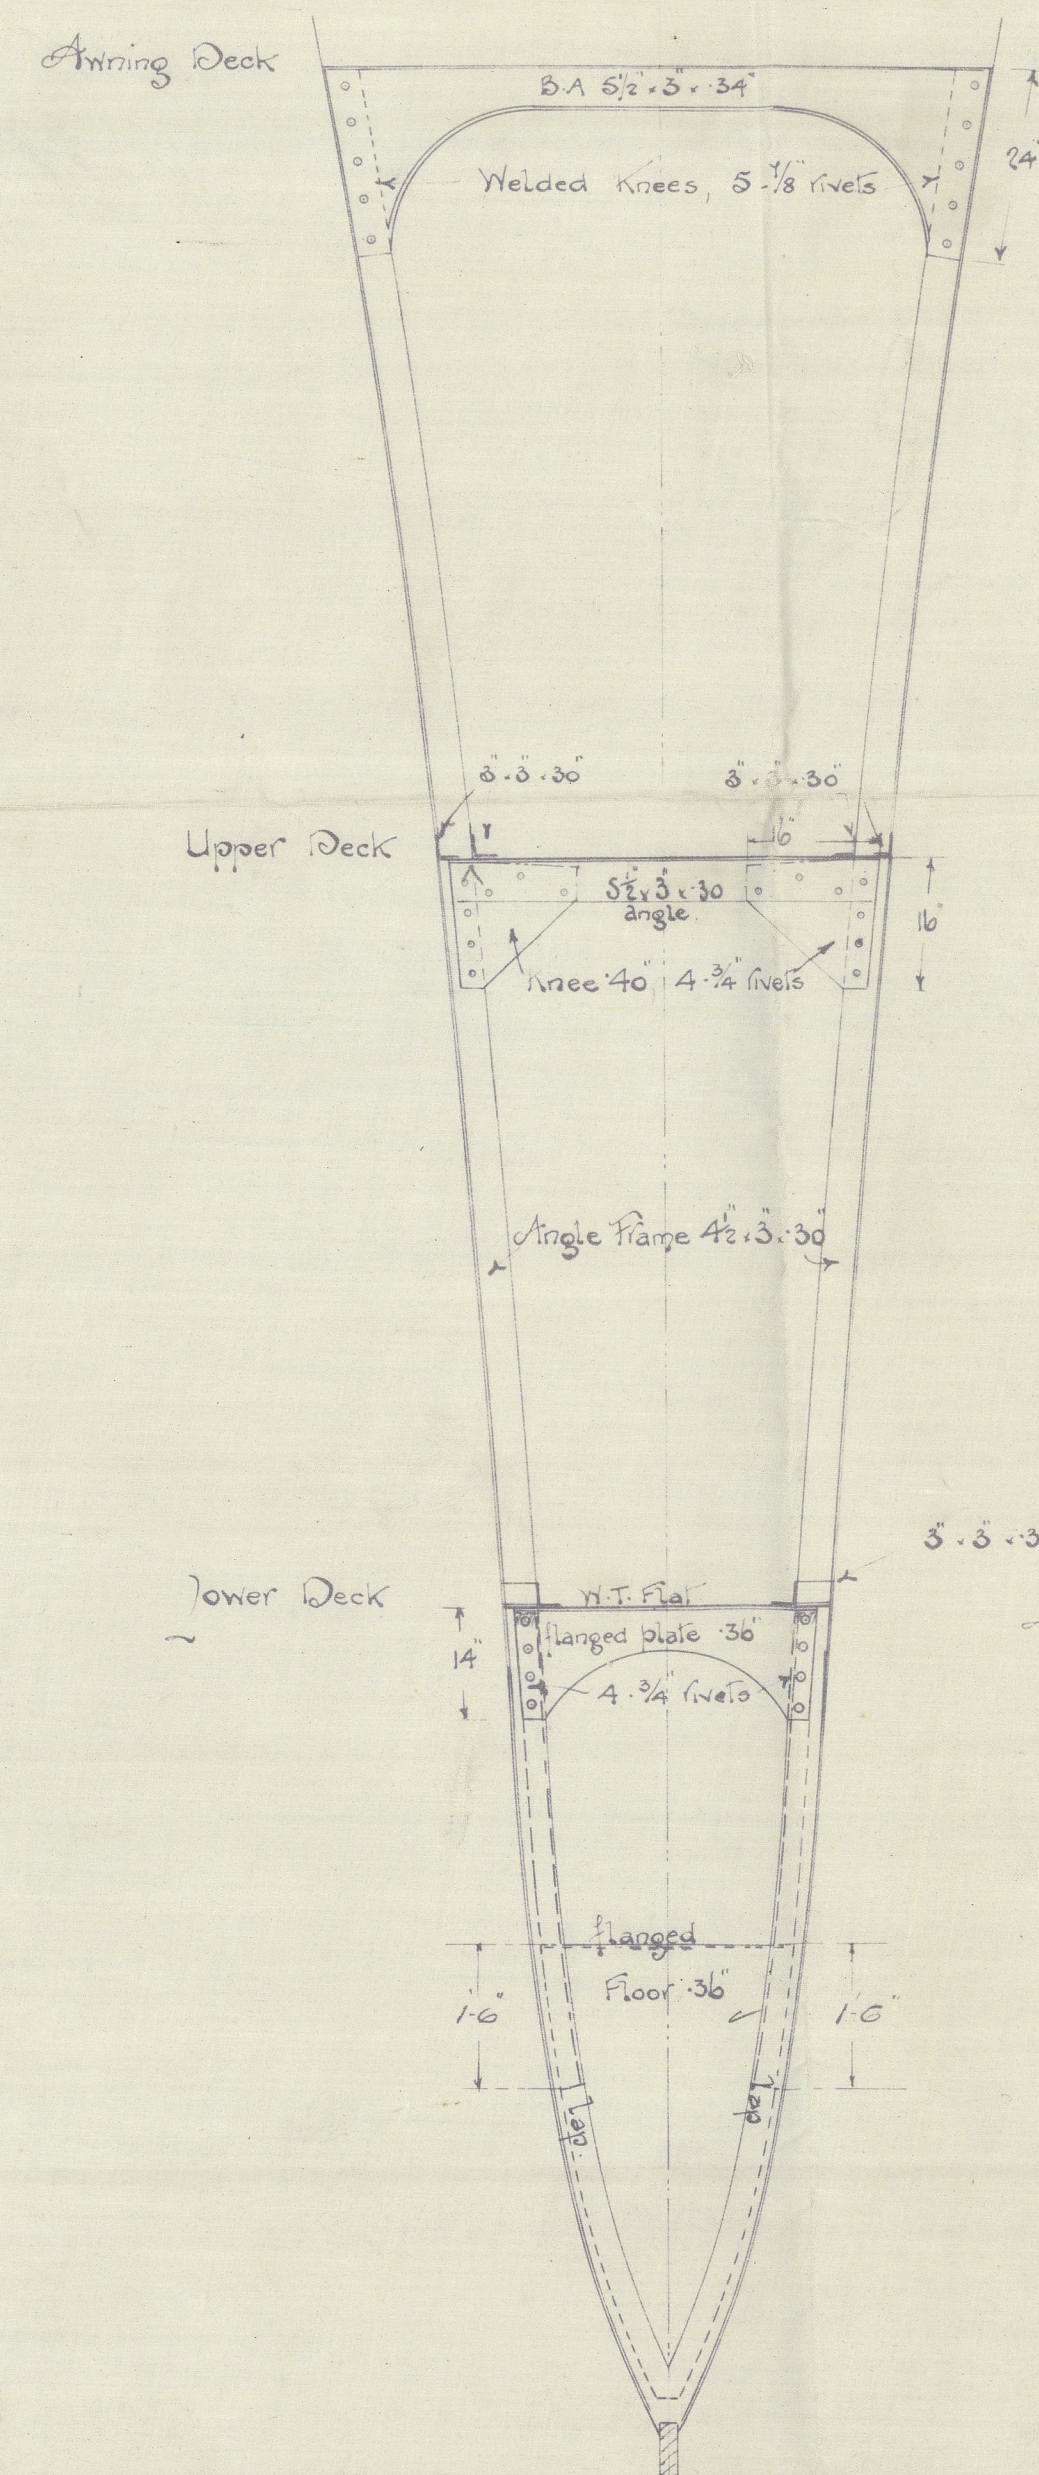

158

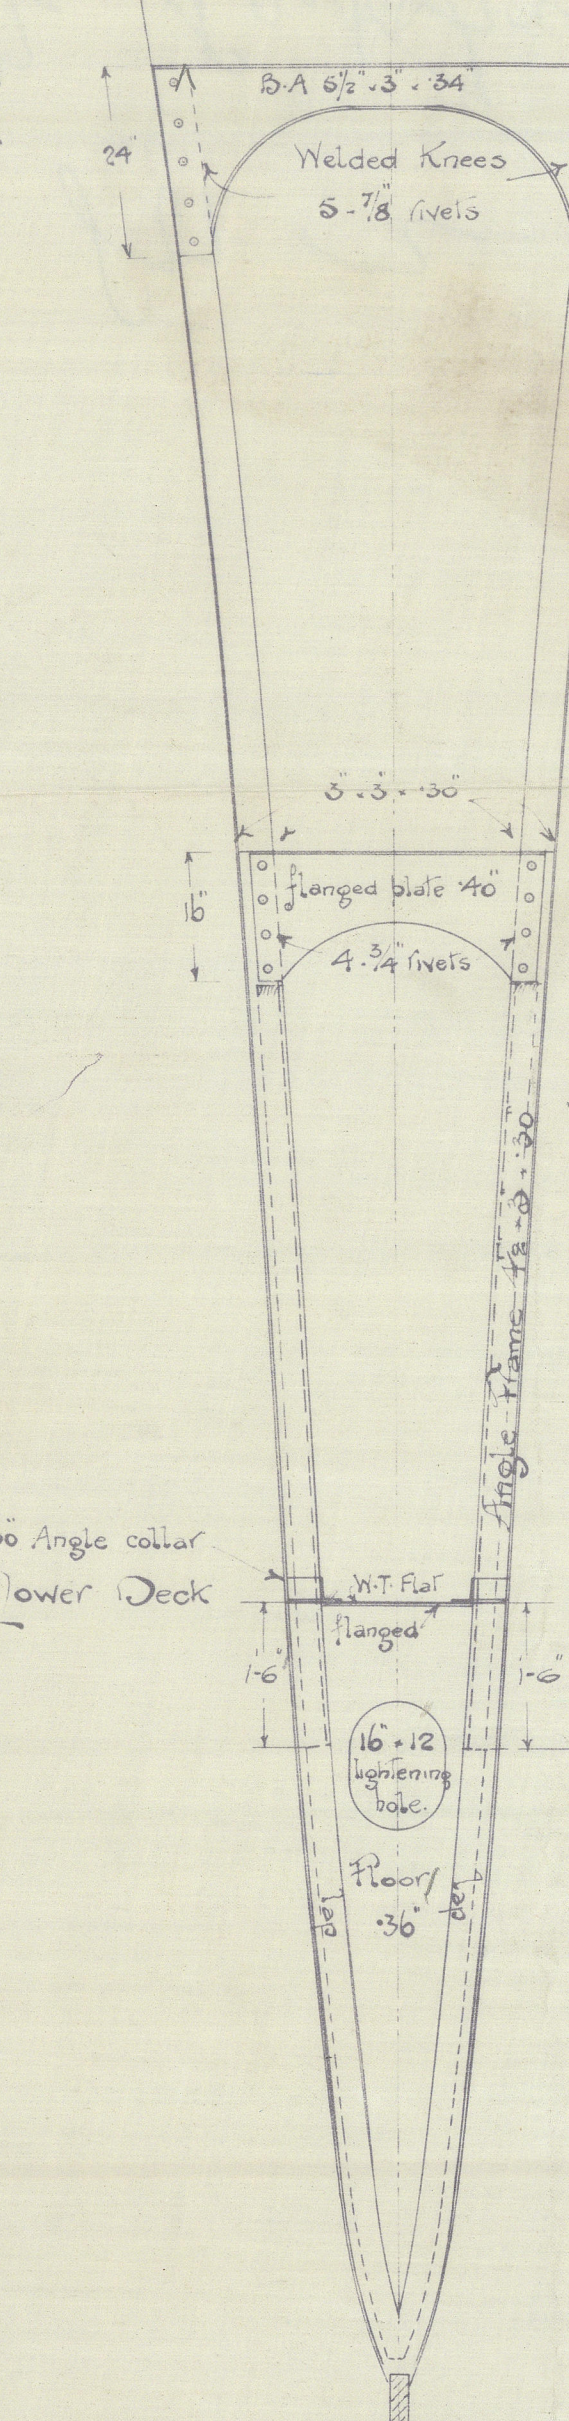

159

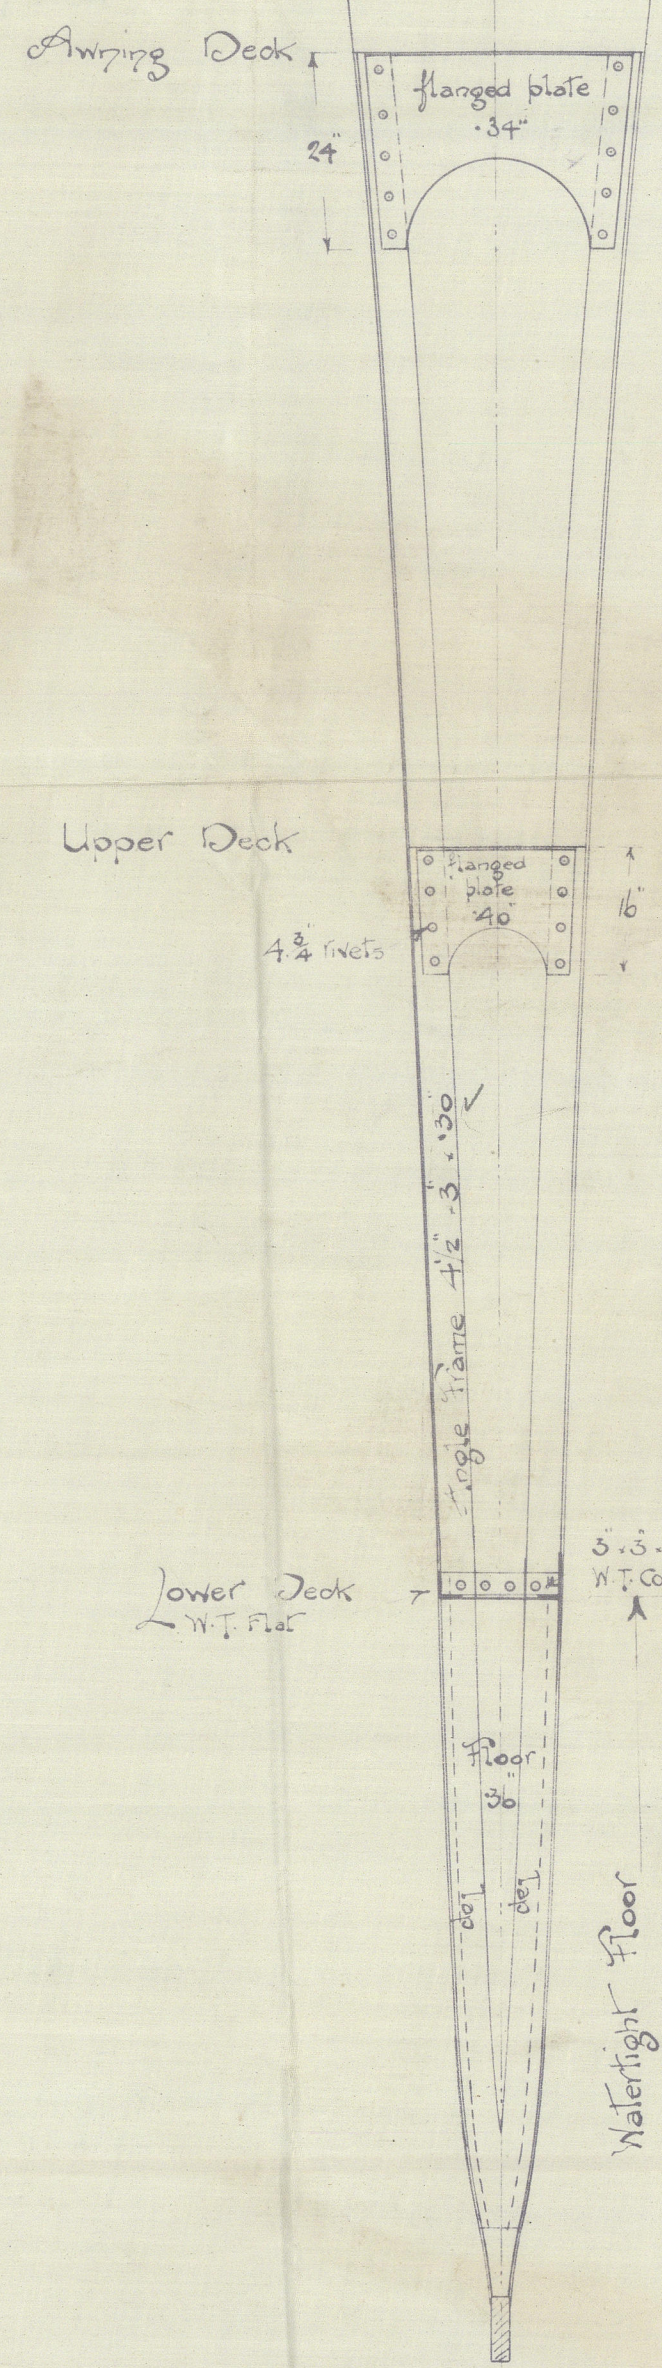

160

Section Views are drawn Looking Forward.

C.F.
25/8/13.

for
Jou Pembhammy

002853-002857-0062




© 2021

Lloyd's Register
Foundation


C. L. Co
Ton Peak Framing

Ton Peak Framing.
C. Laird Heol 801/2.

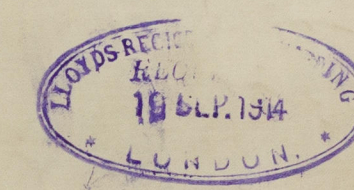

801.
S.S. "Ciudad de Buenos Aires"
Arr Rpt 72445.

802.
S.S. "Ciudad de Monte Video"
Arr Rpt 72775.

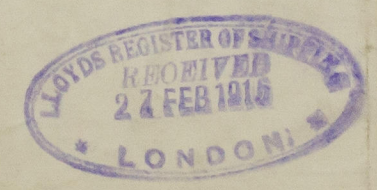

801/2
Ton Peak Framing

002856-002857-0062

