


CAMMELL LAIRD & CO LTD  
BIRKENHEAD.  
FOR ENCLOSURE TO  
PLAN No 106  
DATE OCT 2 - 1913  
SHIP DEPARTMENT.

NOTED & RETURNED  
OCT 9 1913  
CAMMELL LAIRD & CO LTD  
BIRKENHEAD.

TRACING No 43.

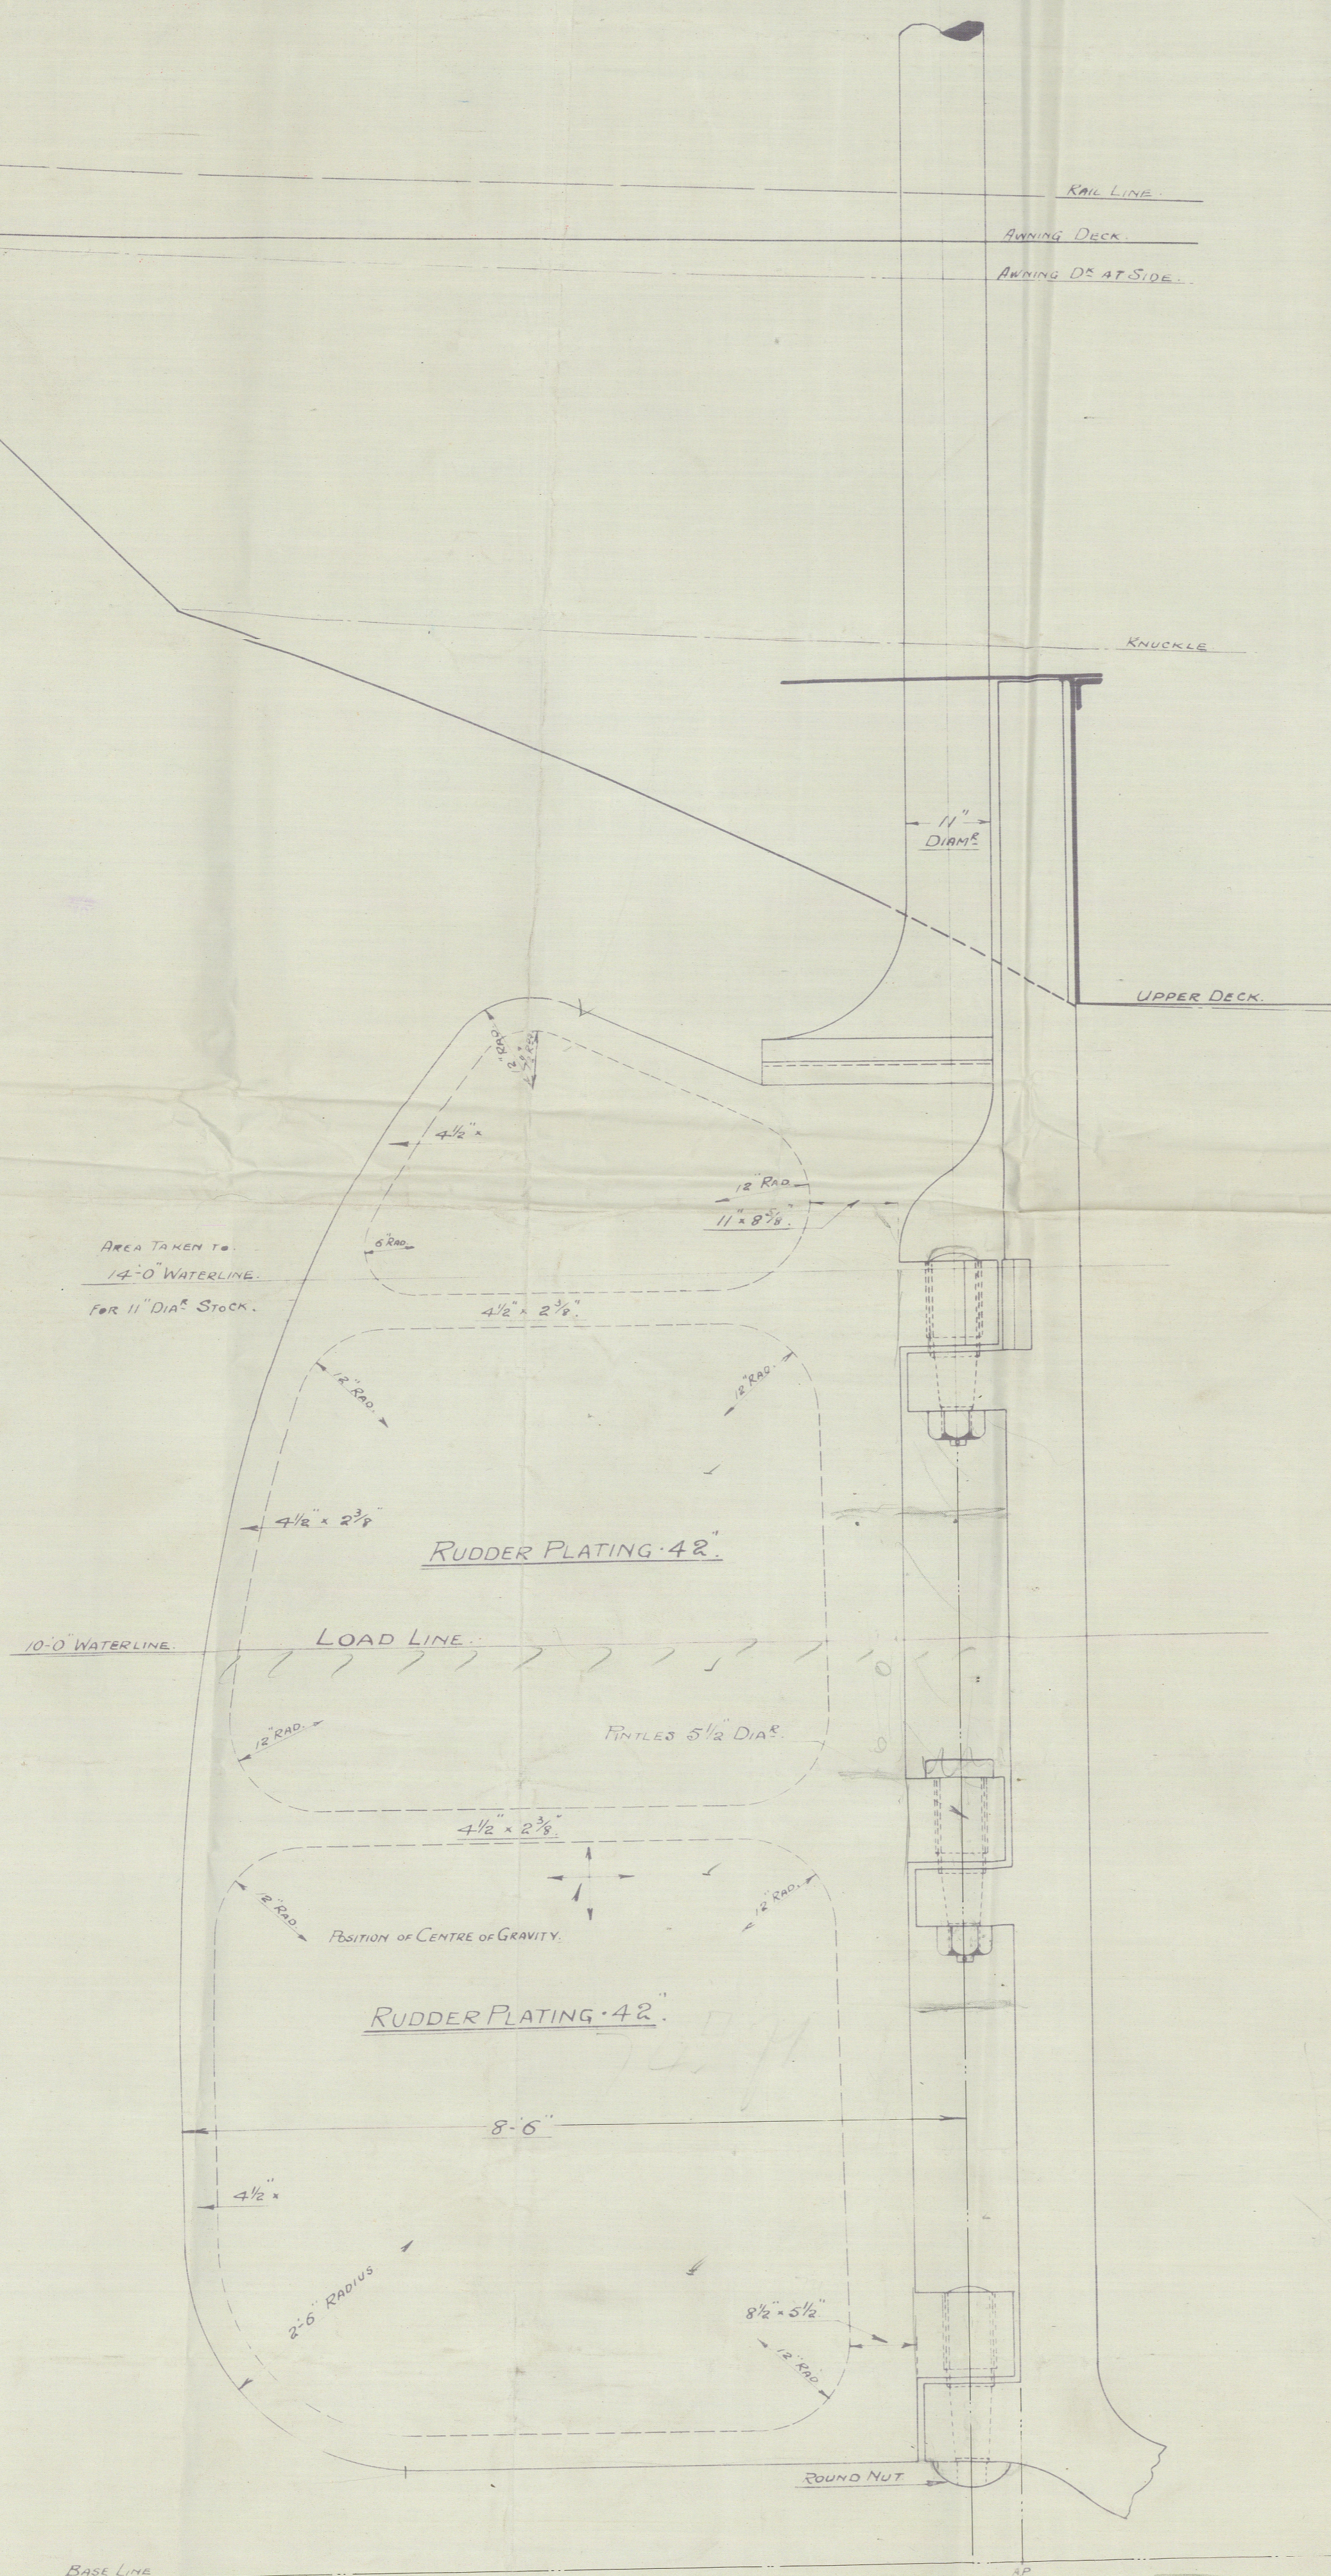

No 801 & 2.

RUDDER PLAN.

SCALE  $\frac{3}{4}$ " = 1 Ft.

AREA OF RUDDER UP TO 14'-0" W.L. = 104 Sq. Ft.

CR. OF GRAVITY ABAFT CR. LINE OF PINTLES = 4.04 Ft.

LLOYDS. A x d = 420. DIA<sup>s</sup> OF RUDDER HEAD = 11 INCHES.

SPEED OF SHIP = 18 KNOTS.

C.B.  
4.10.13.

3/10/13  
P.Q.R.S.

002853-002857-0000