


Nº 954. and 956.

CONSTRUCTIONAL DECK PLANS.


SCALE - $\frac{1}{8}" = 1 \text{ FOOT.}$

325'-0" x 46'-10" MLD. x 27'-6" MLD. TO UPPER DK.


POOD D¹

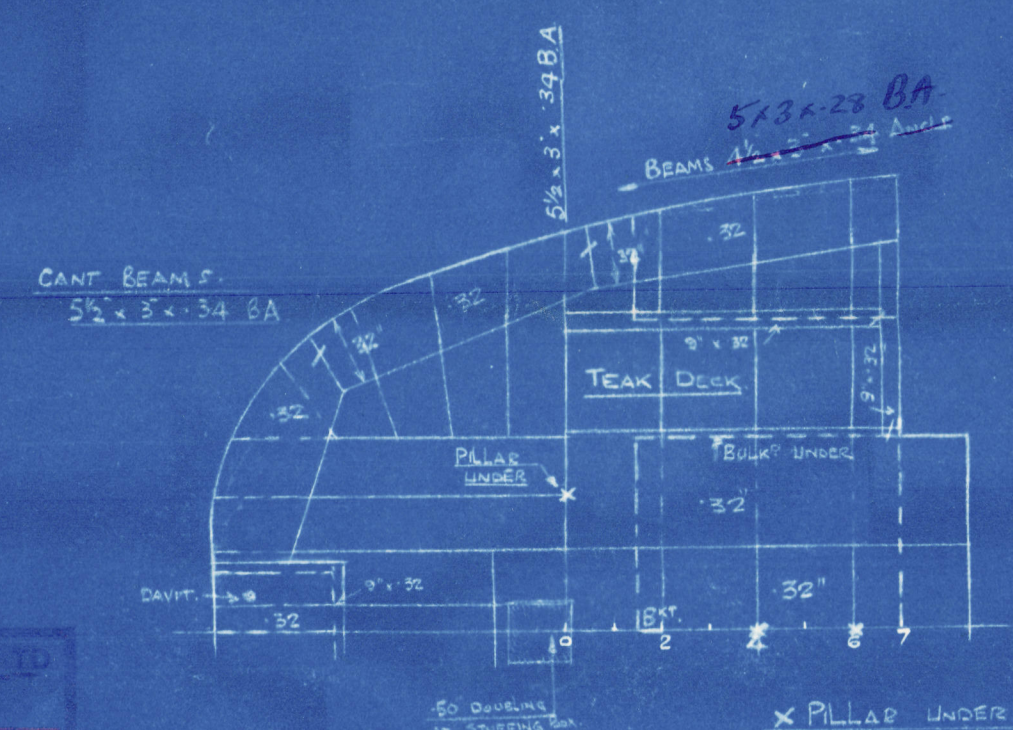


BRIDGE D¹

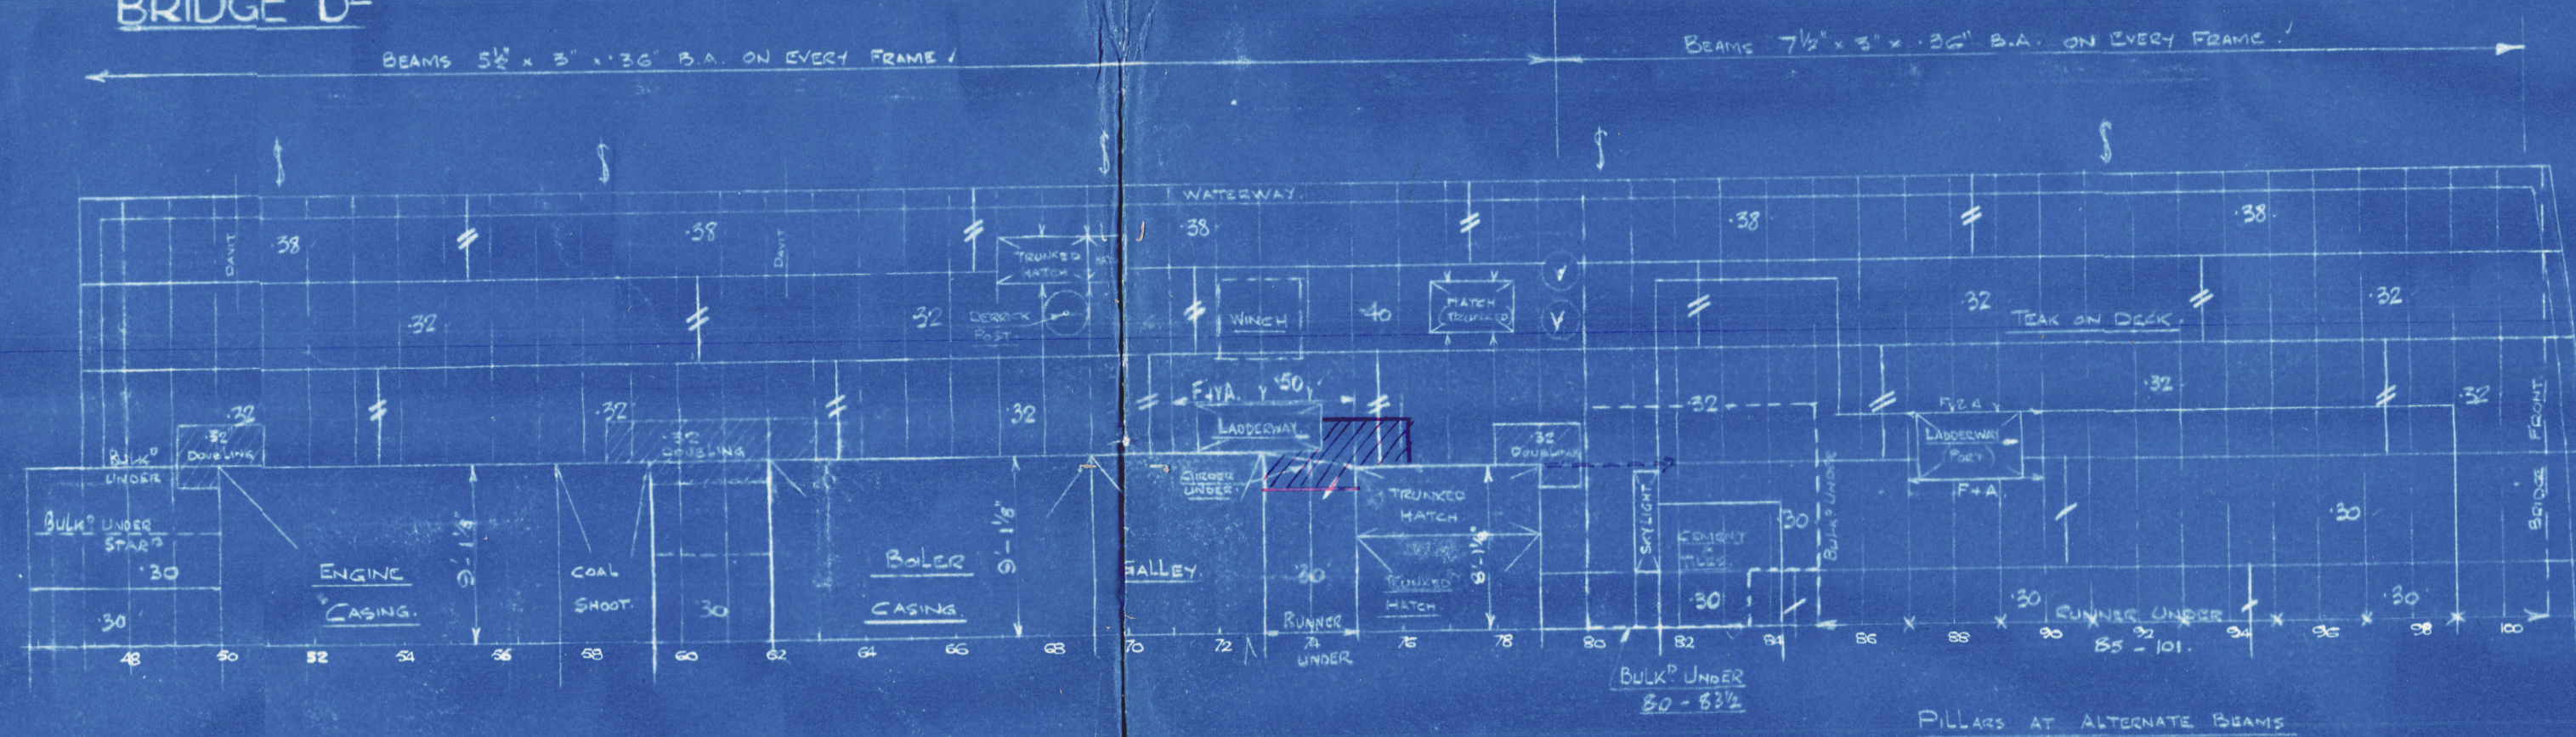


FICLE D¹

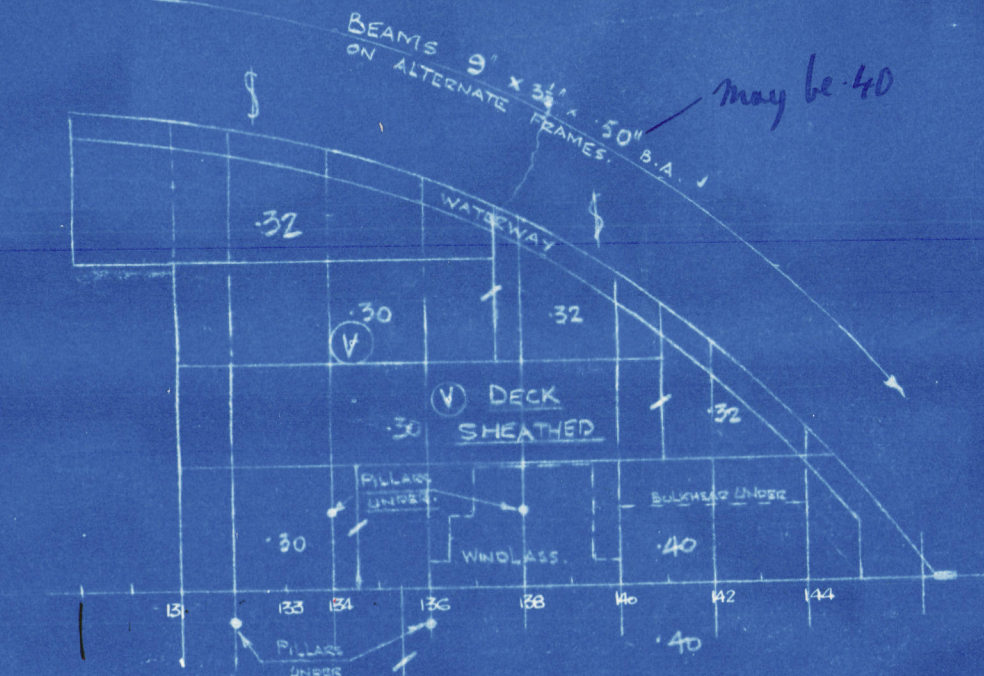

UPPER D¹

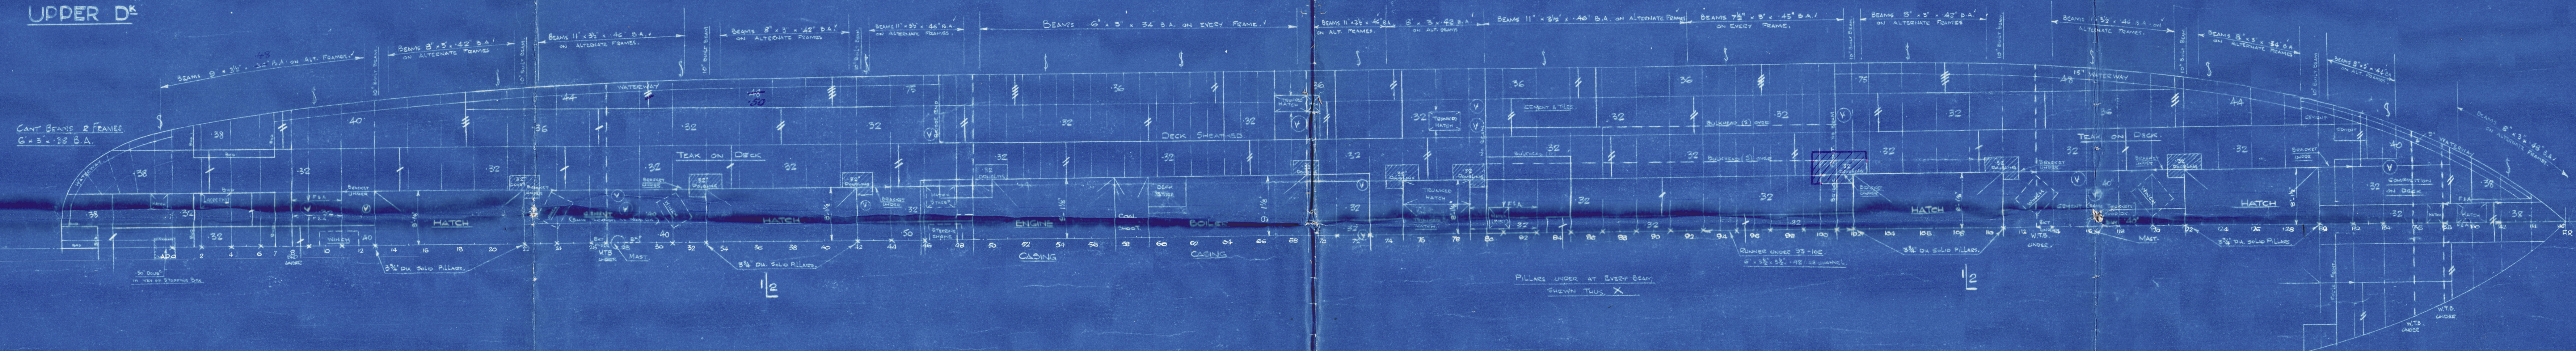

MAIN D¹

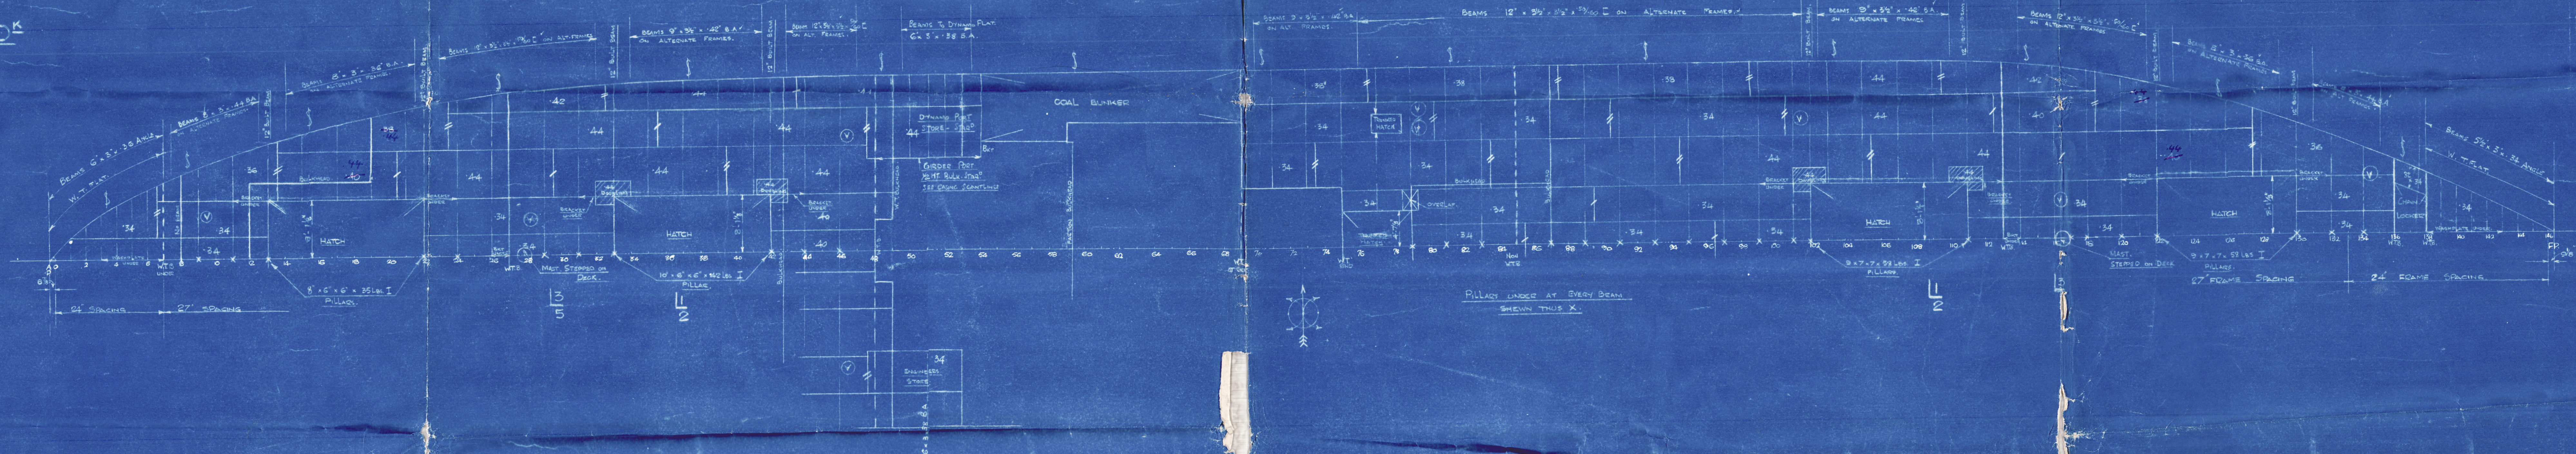

T. Nº 14.
100

100
1.11.28

002870-002875-0028

Cammell Lairds

No. 954 + 956

DORINTHIA

Constructional
Deck Plans

S. S. Godfrey B Holt *

LIVERPOOL

Report No. 95751

N.N. HANS ERICH

S. S. Thomas Holt

LIVERPOOL

Report No. 95885

RETAIN

© 2020

Lloyd's Register
Foundation

002870-002875-0063